


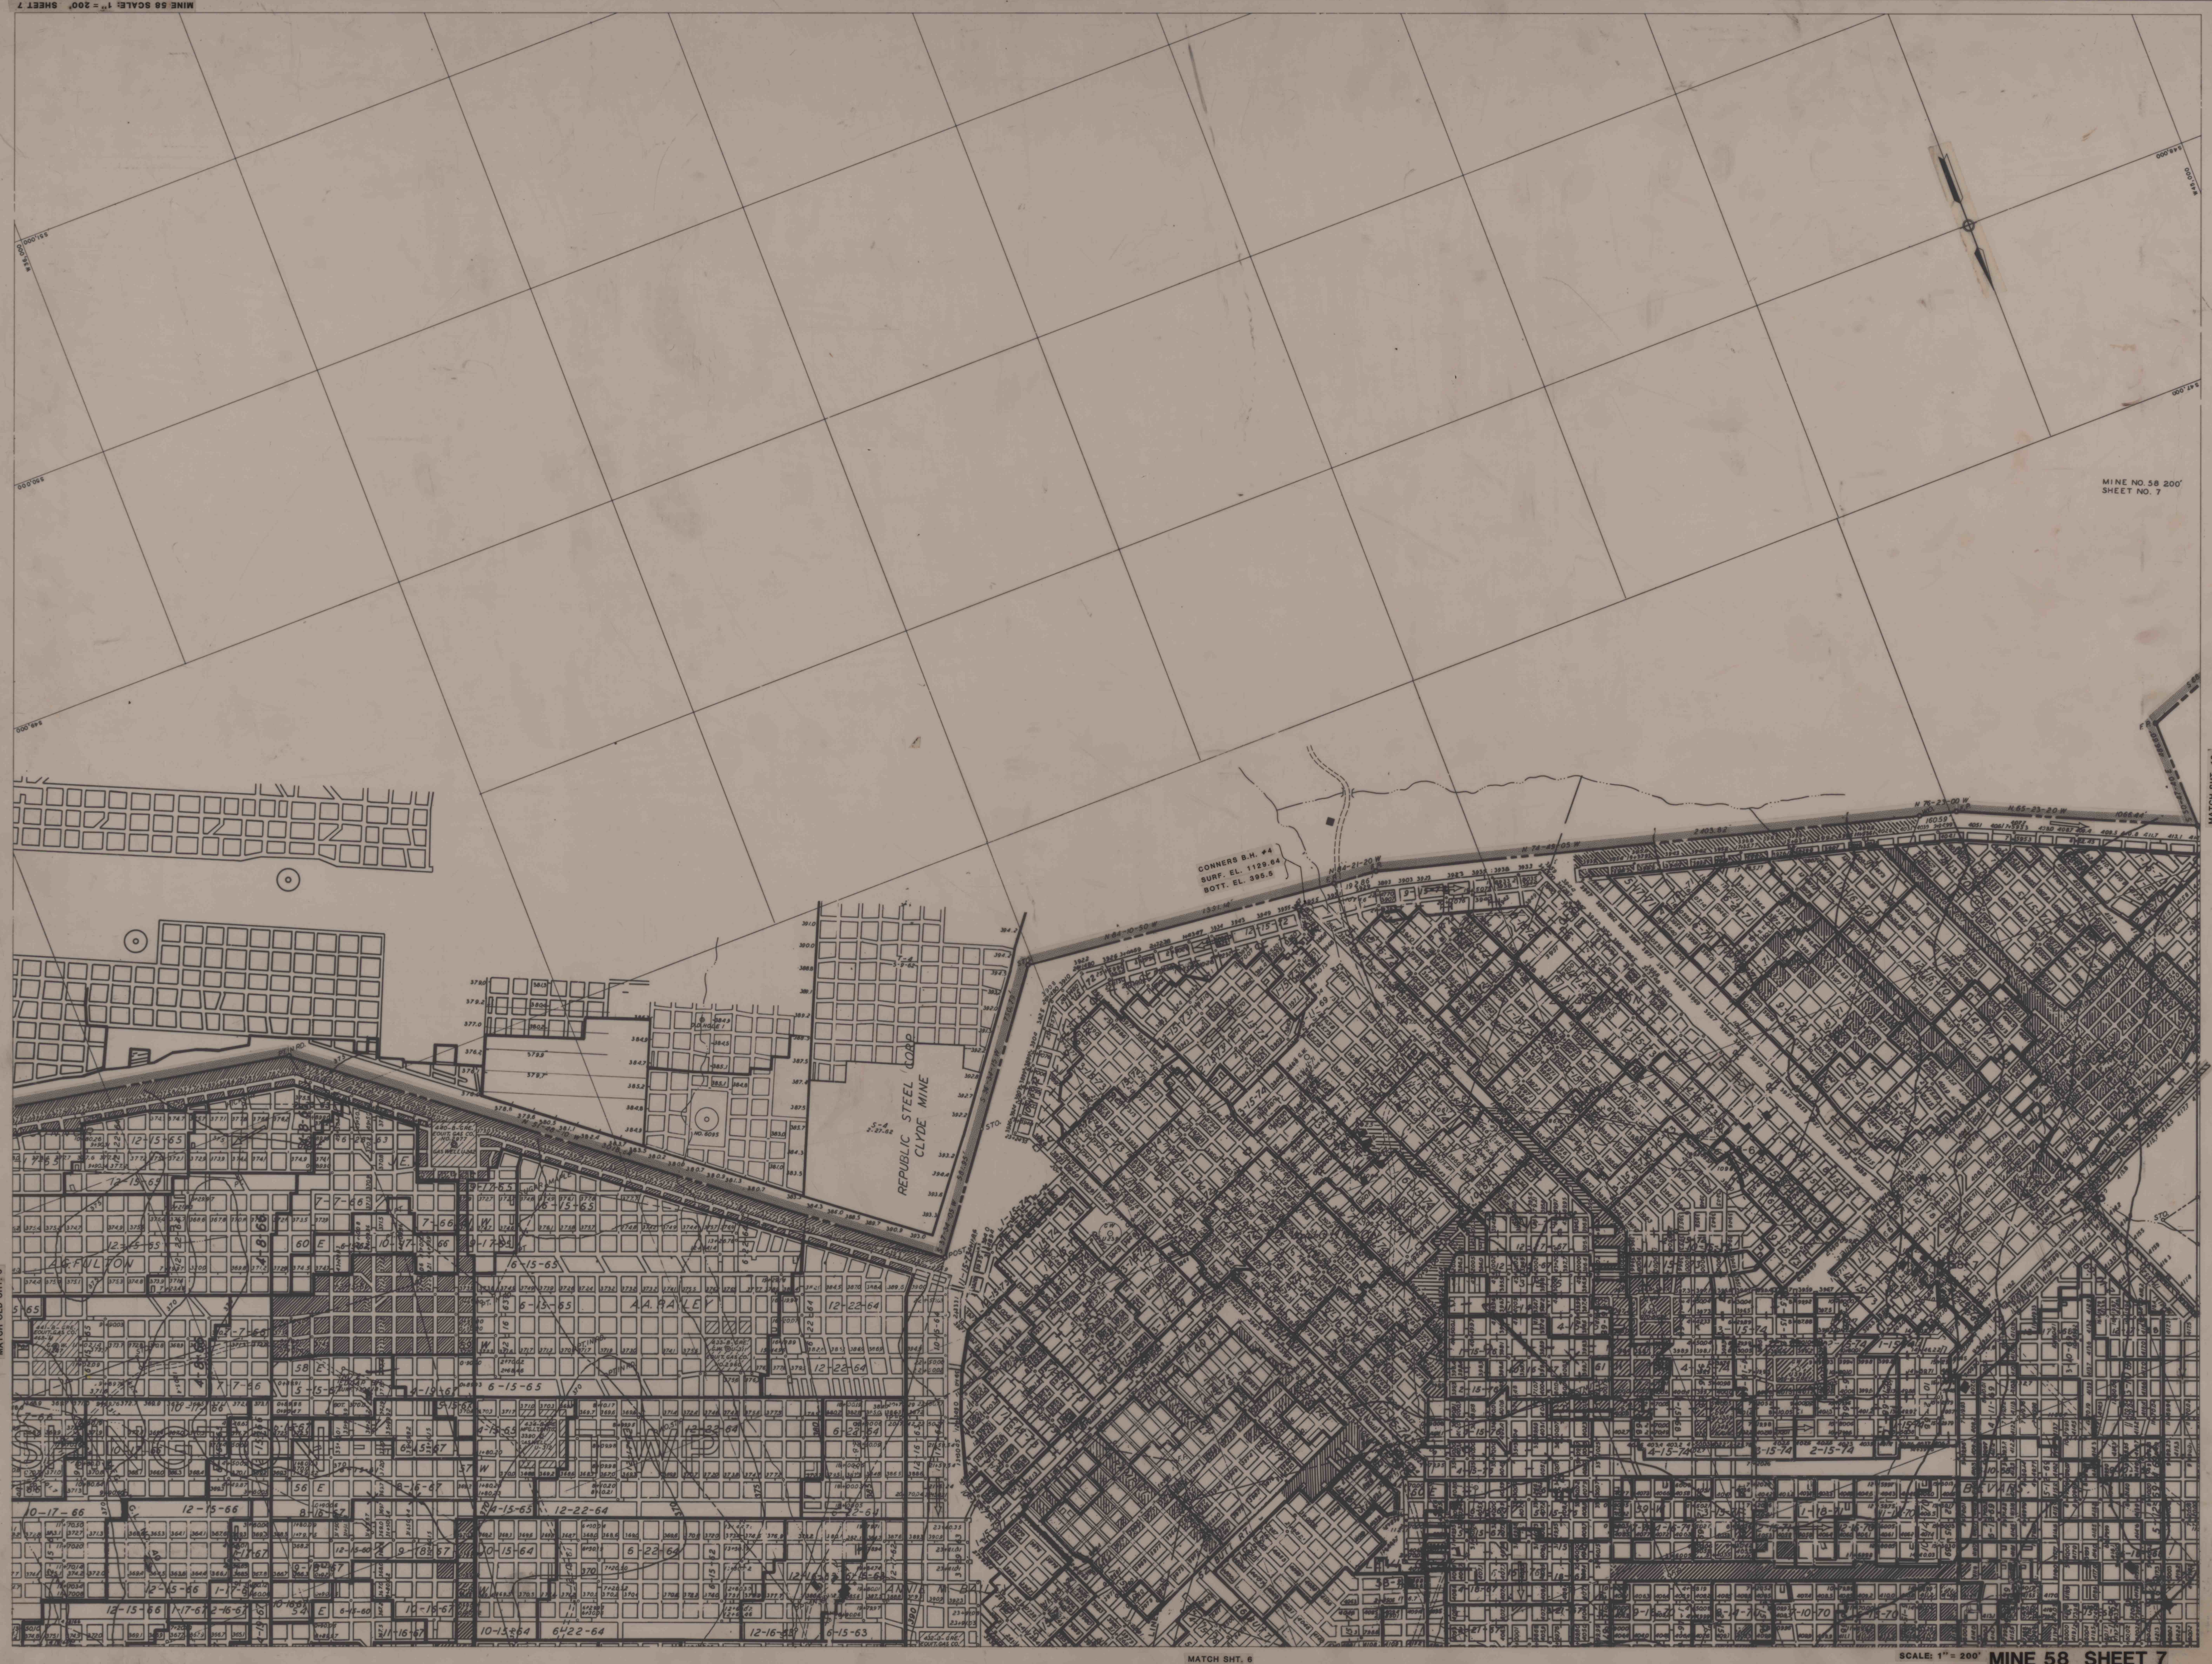

MINE 58 SCALE: 1" = 200' SHEET 7

MINE NO. 58 200' SHEET NO. 7

MATCH OLD SHT. 3

MATCH SHT. 12

MATCH SHT. 6

SCALE: 1" = 200' MINE 58 SHEET 7