


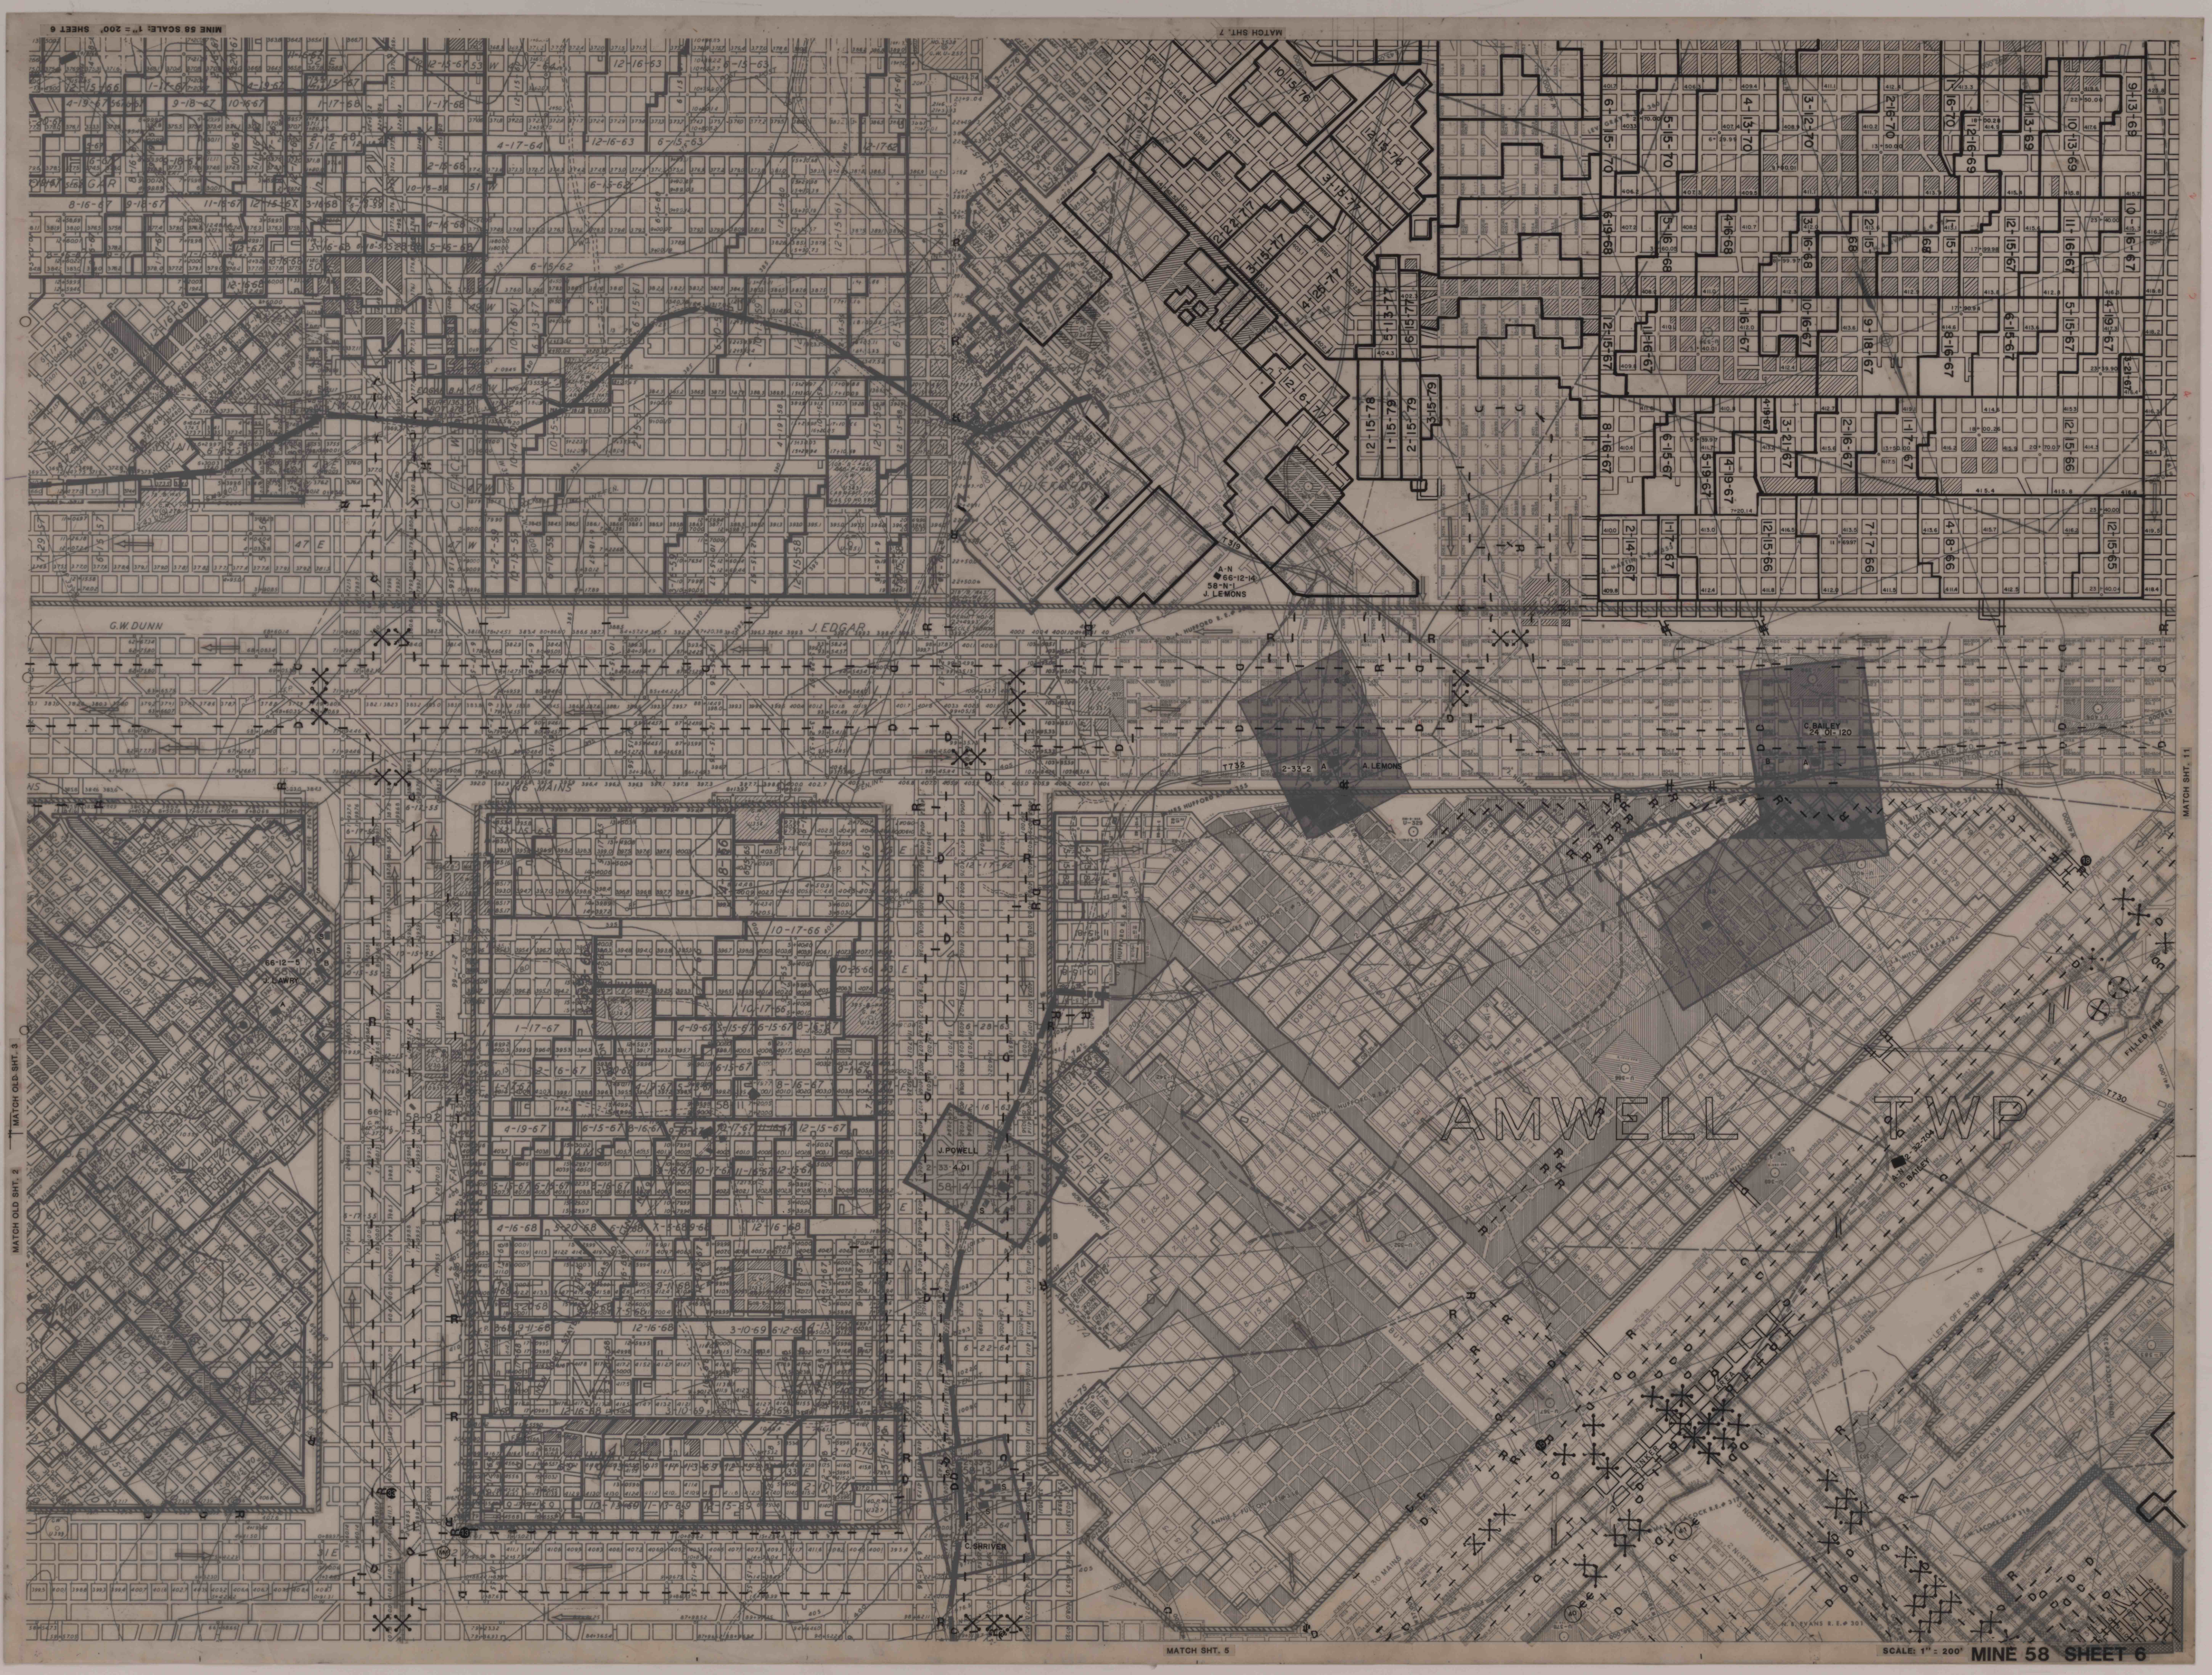

MINE 58 SCALE: 1" = 200' SHEET 6

MATCH SHT. 7

MATCH SHT. 11

MATCH OLD SHT. 2
MATCH OLD SHT. 3

MATCH SHT. 5

SCALE: 1" = 200' MINE 58 SHEET 6