


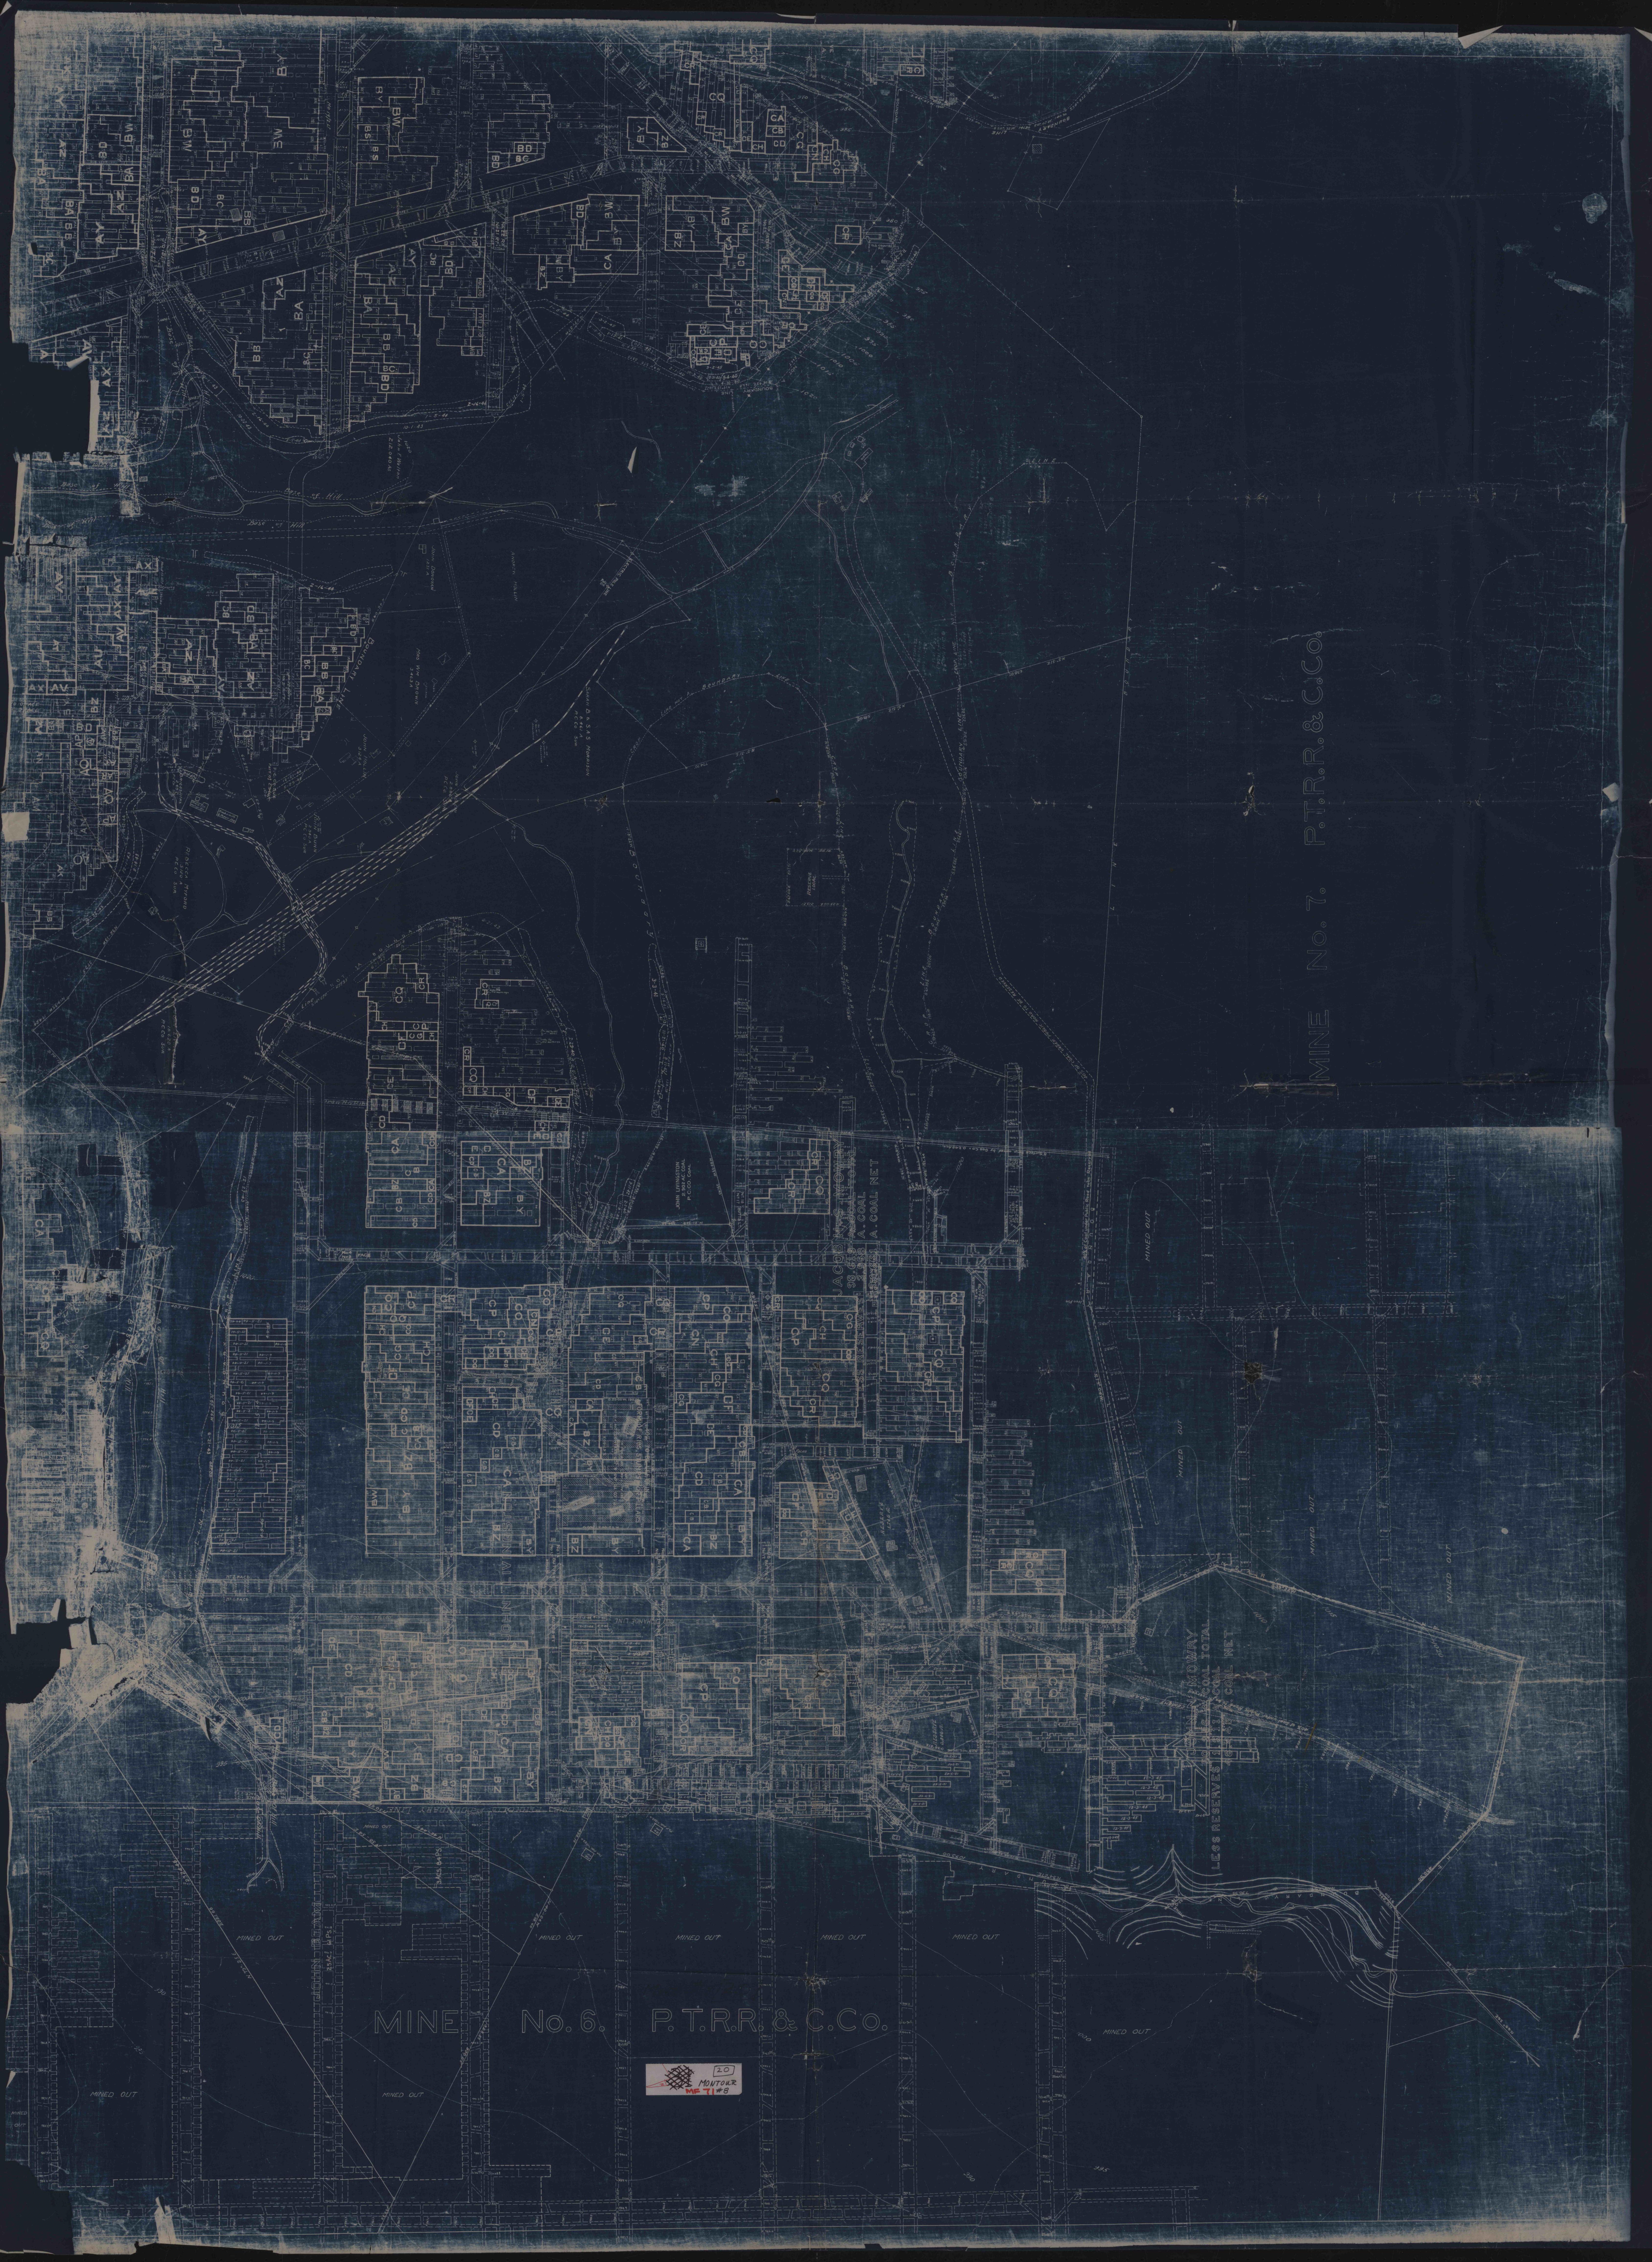

MINE No. 7. P.T.R.R. & C.Co.

MINE No. 6. P.T.R.R. & C.Co.

20

LESS RESERVES
TOTAL
COAL NET