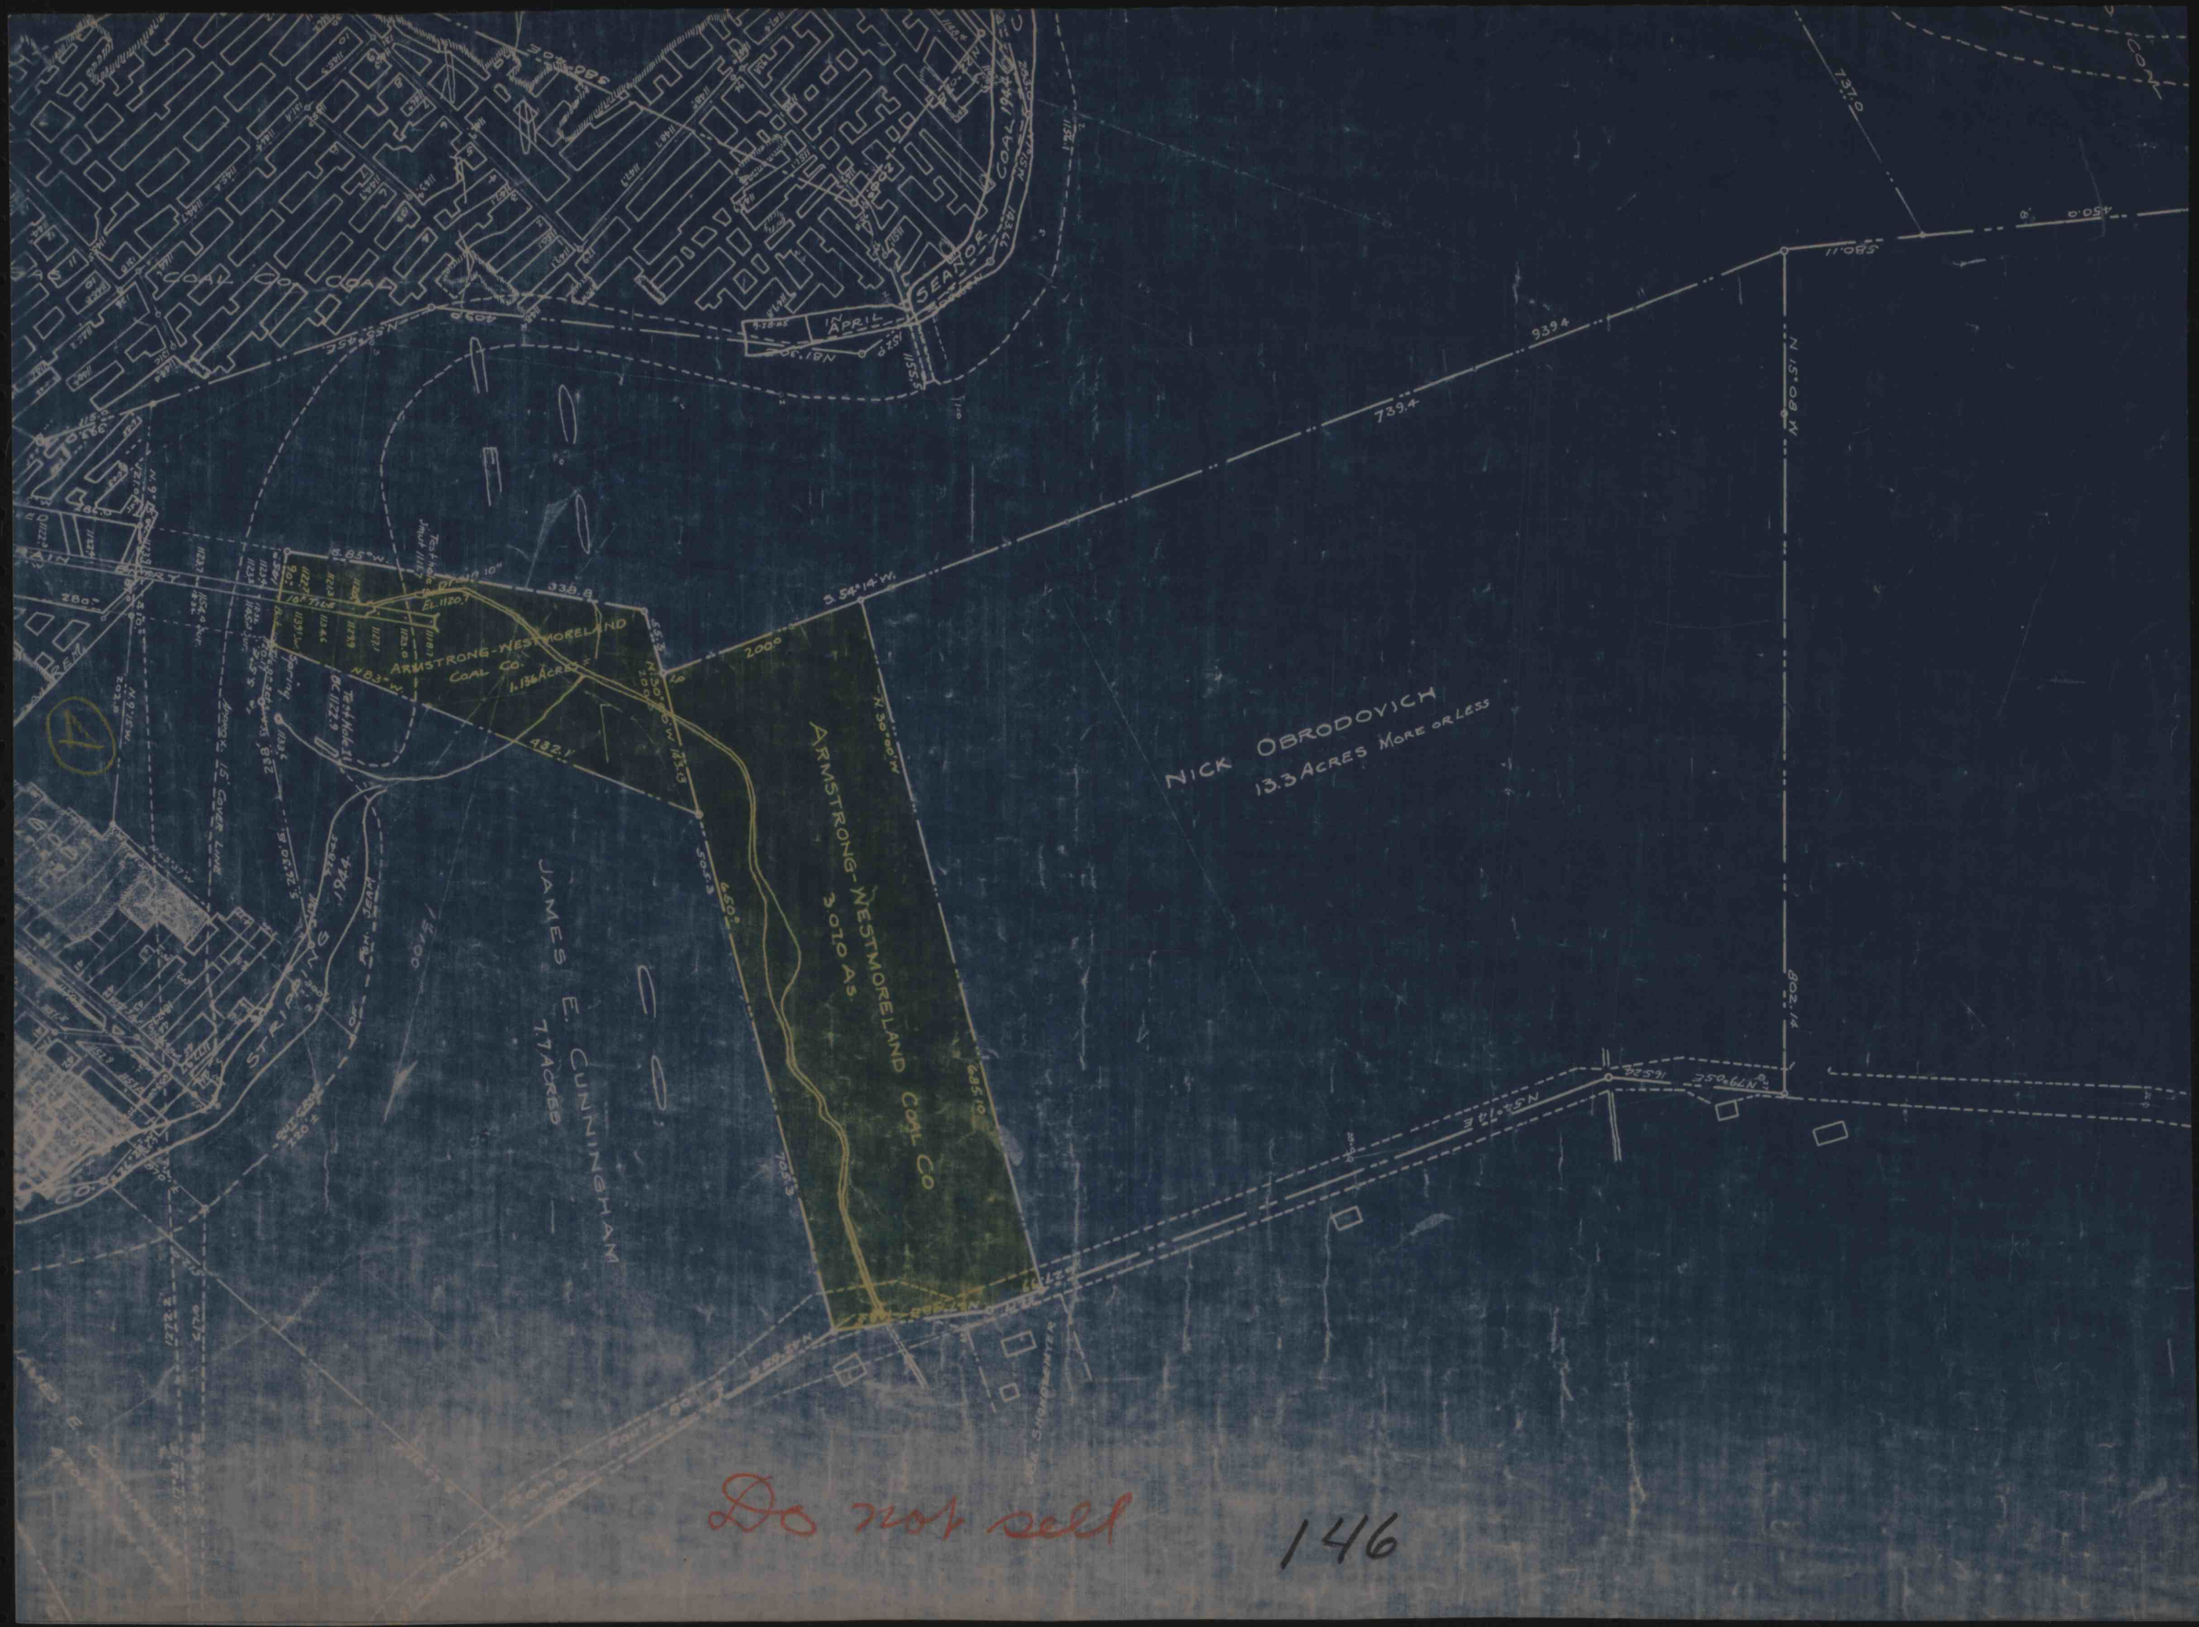
ARMSTRONG-WESTMORELAND COAL CO.
1.136 ACRES
ARMSTRONG-WESTMORELAND COAL CO
3.070 AS.
JAMES E. CUNNINGHAM
77 ACRES
NICK OBRODOVICH
13.3 ACRES MORE OR LESS
STRIPPING 1944
SEANOR
APRIL
COAL 1942
N 30° 00' W
N 58° 13' E
739.4
9394
938.9
432.1
2000
Do not sell
146