


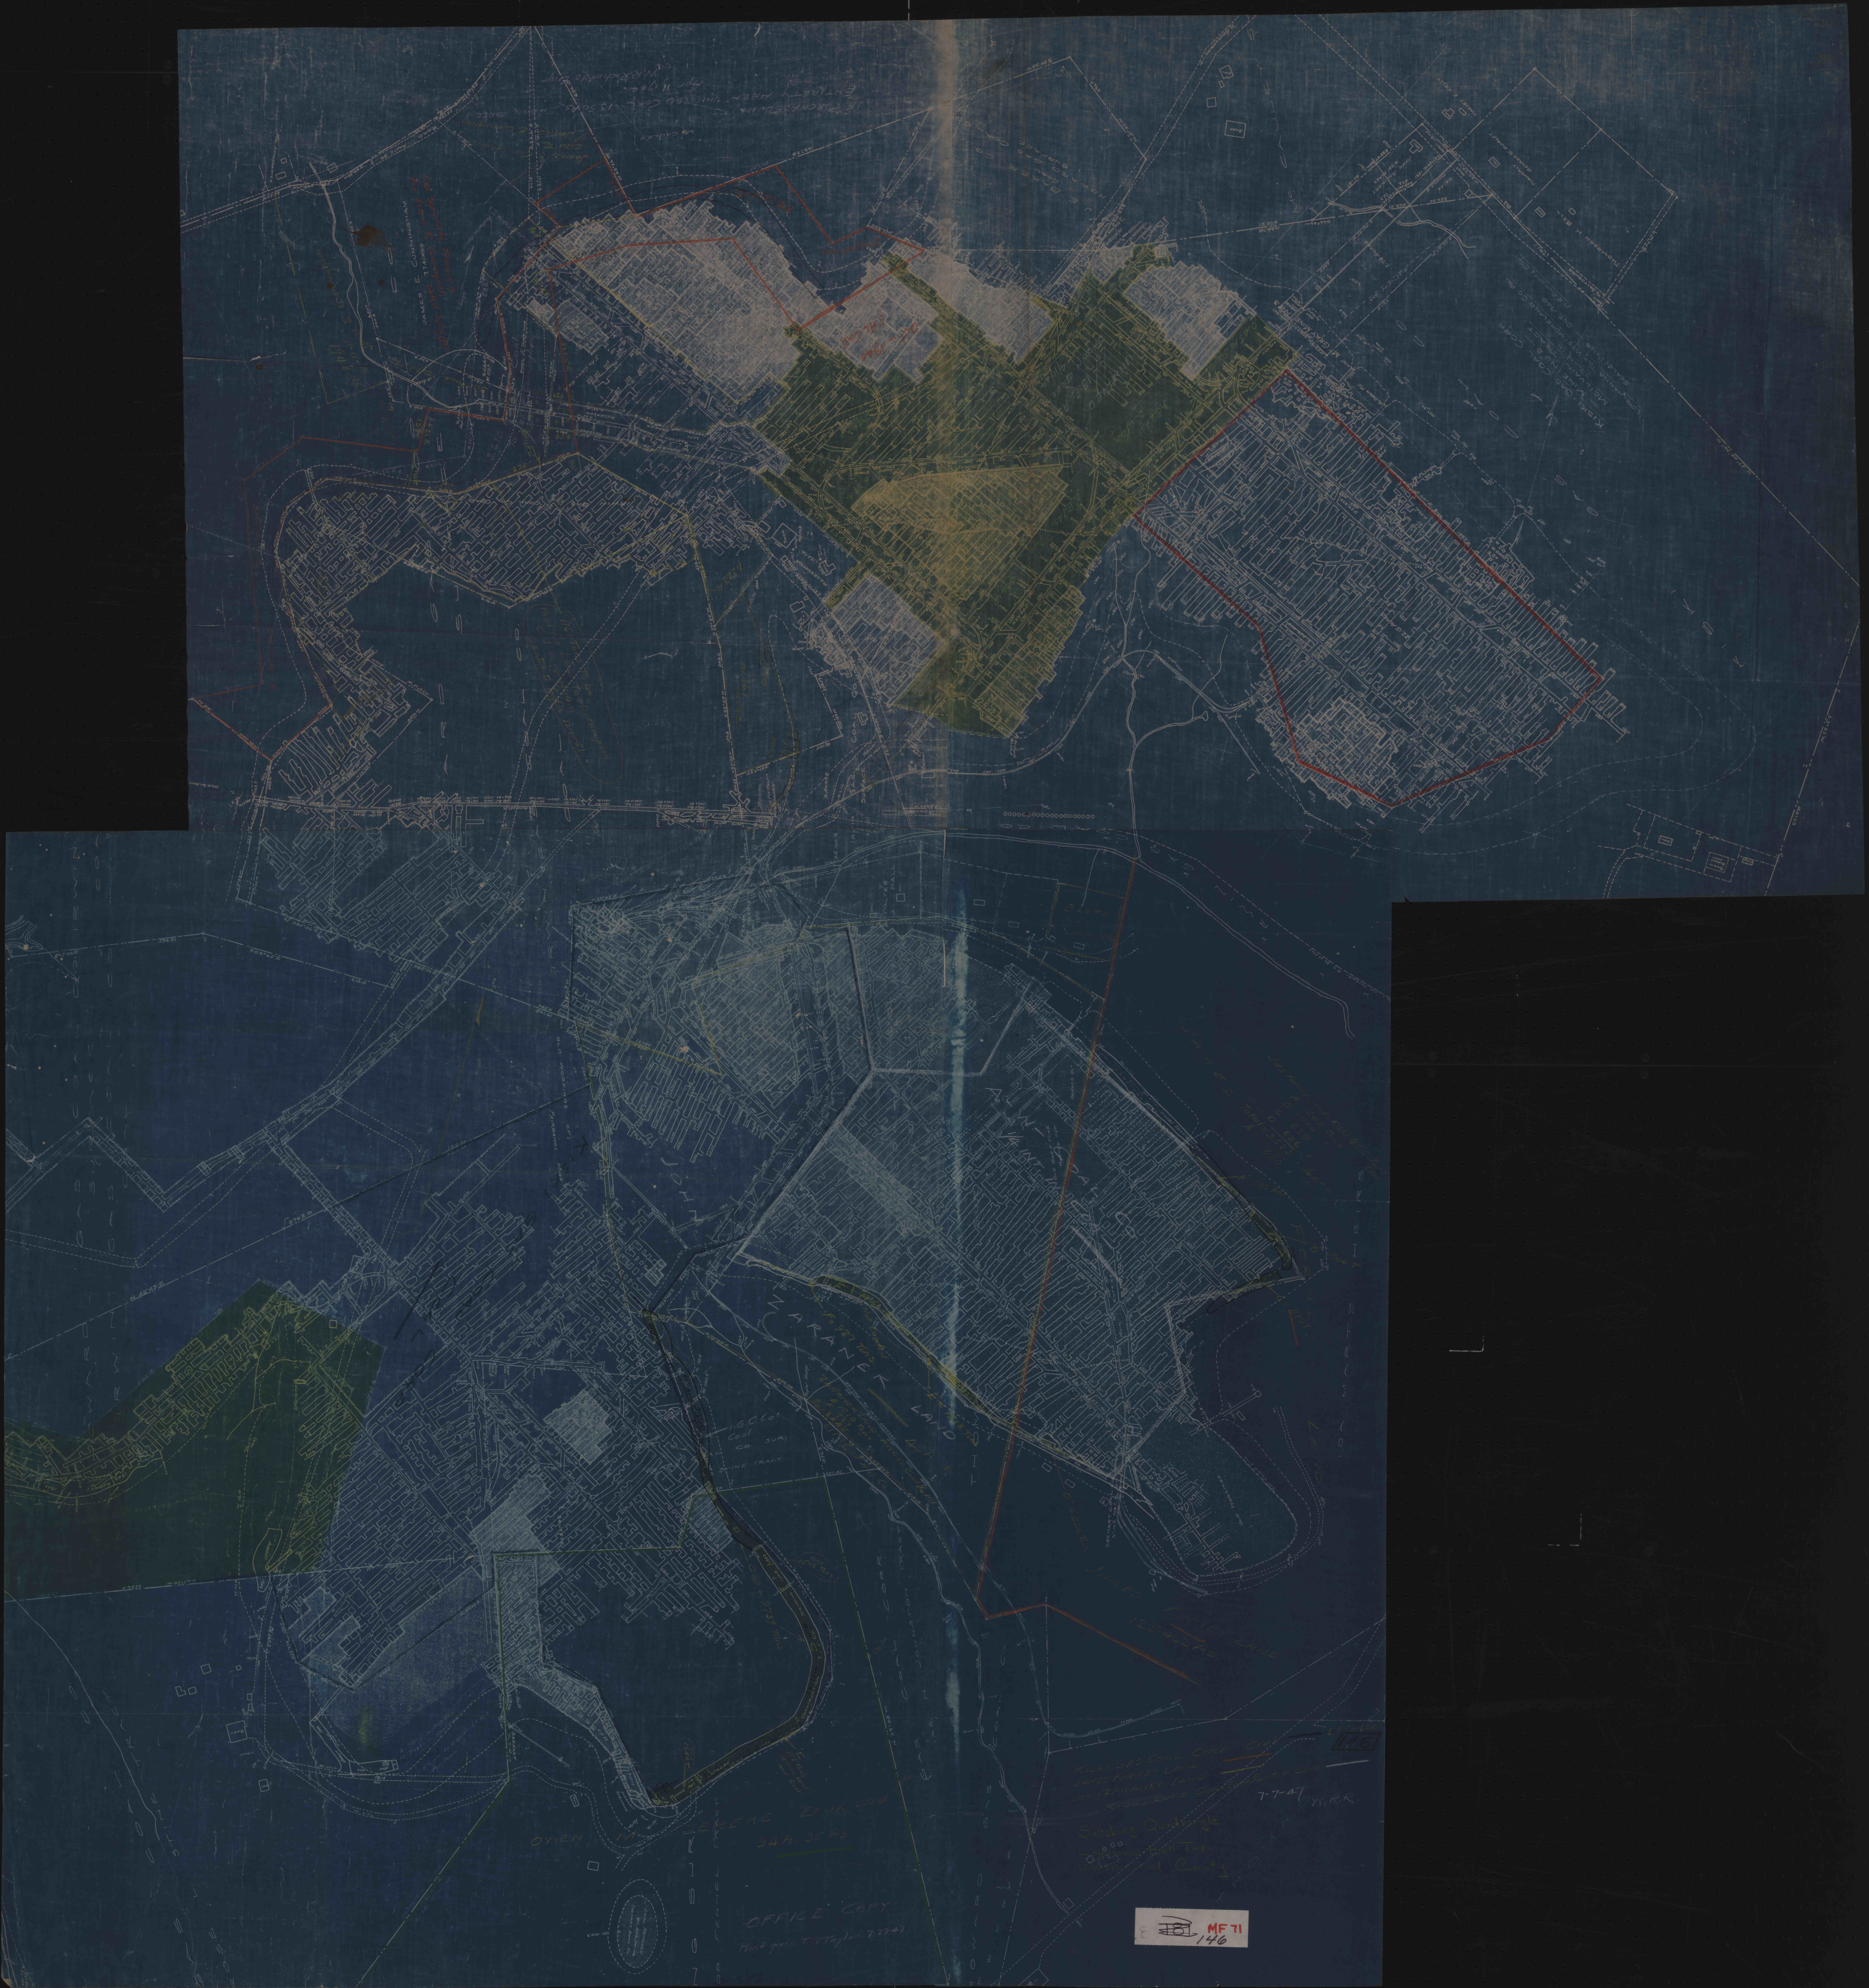

OFFICE COPY
Print from EFTS for 7-7-47

MF 71
146