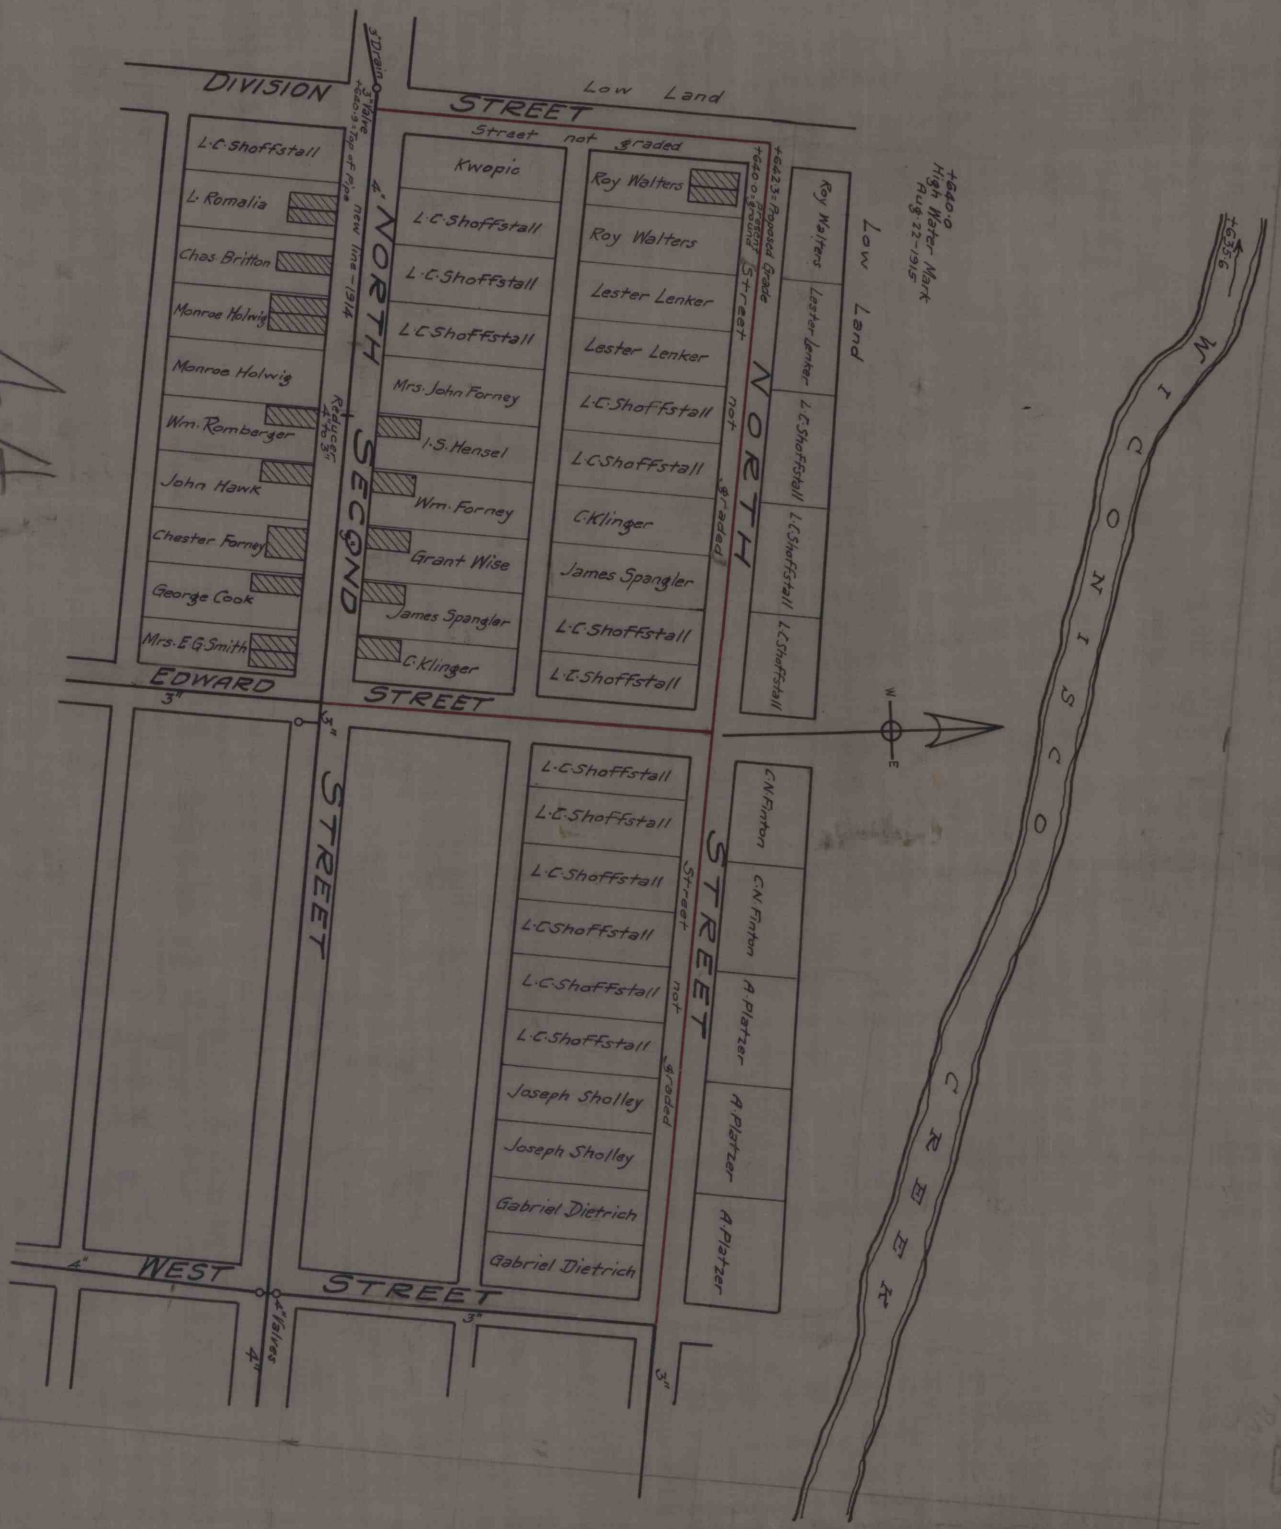

MF
MAR 10 1972