


GRATZ BOROUGH

SPRING GLEN

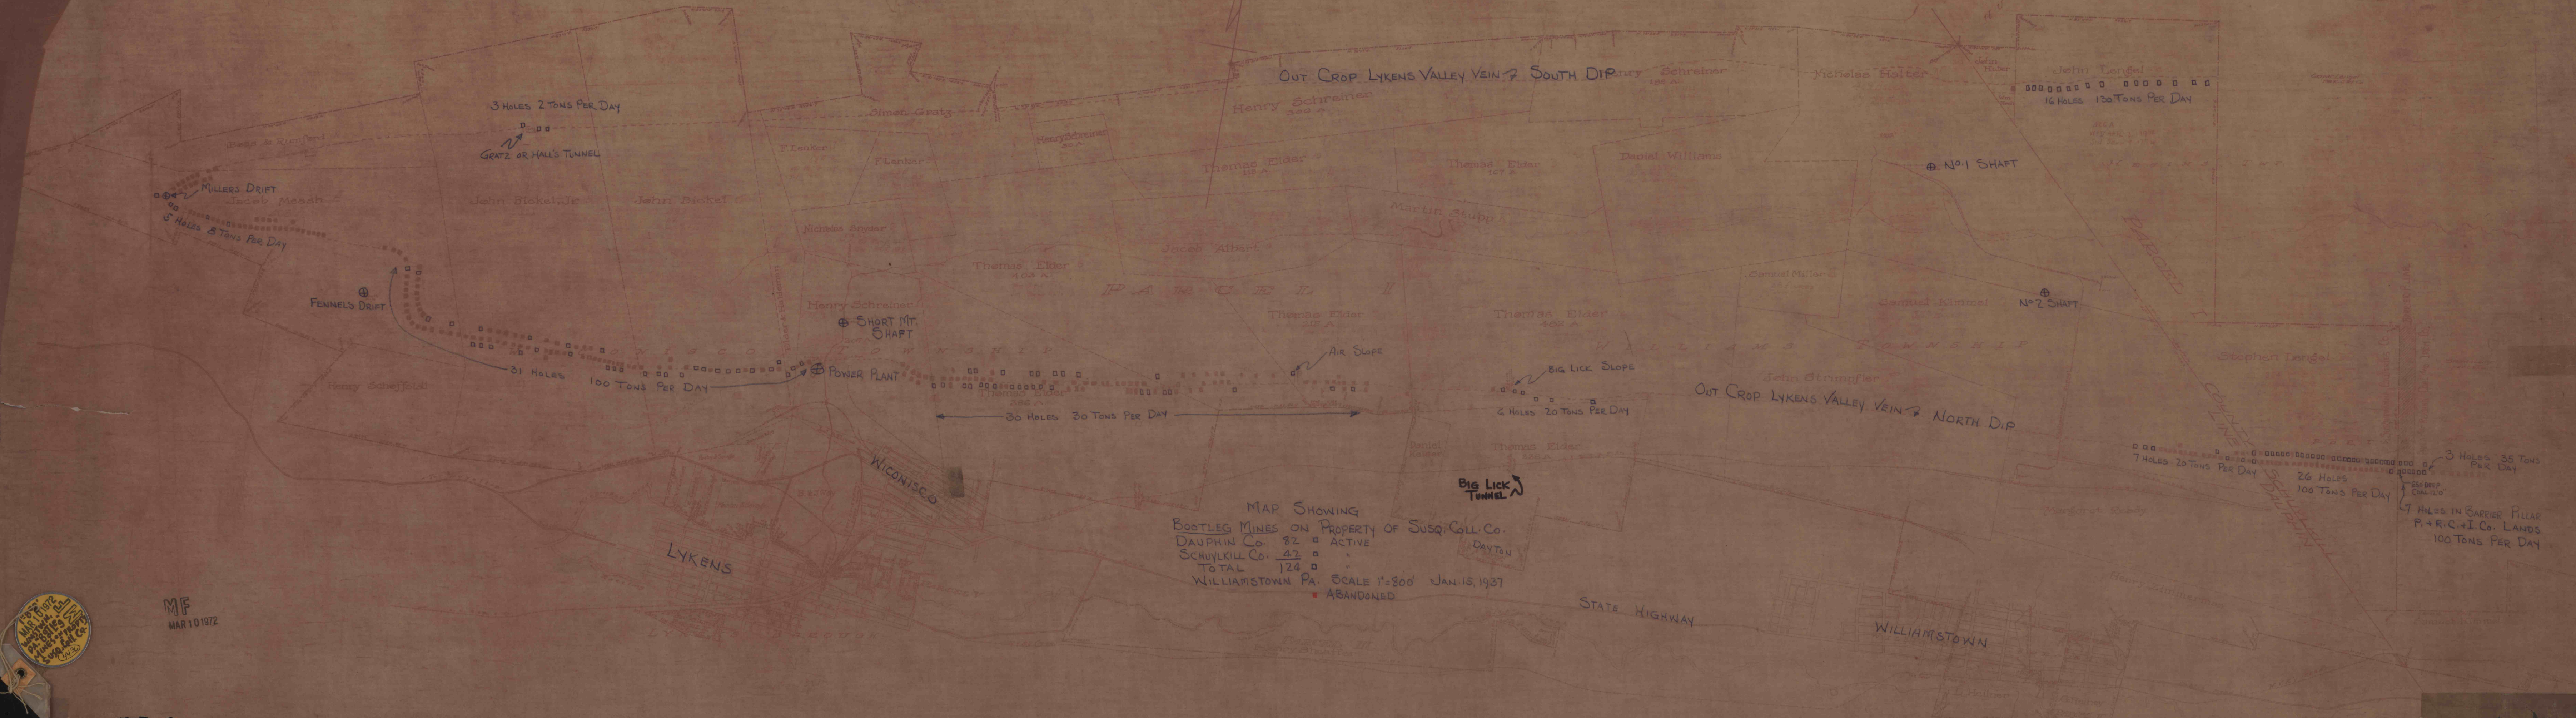

MAP SHOWING
 BOOTLEG MINES ON PROPERTY OF SUSQ. COLL. CO.
 DAUPHIN Co. 82 □ ACTIVE
 SCHUYLKILL Co. 42 □ " "
 TOTAL 124 □ " "
 WILLIAMSTOWN PA. SCALE 1"=800' JAN. 15, 1937
 ■ ABANDONED

1937
 MAR 10 1937
 MF
 MAR 10 1937