


SECTION No. 38
SCALE 1"=100'

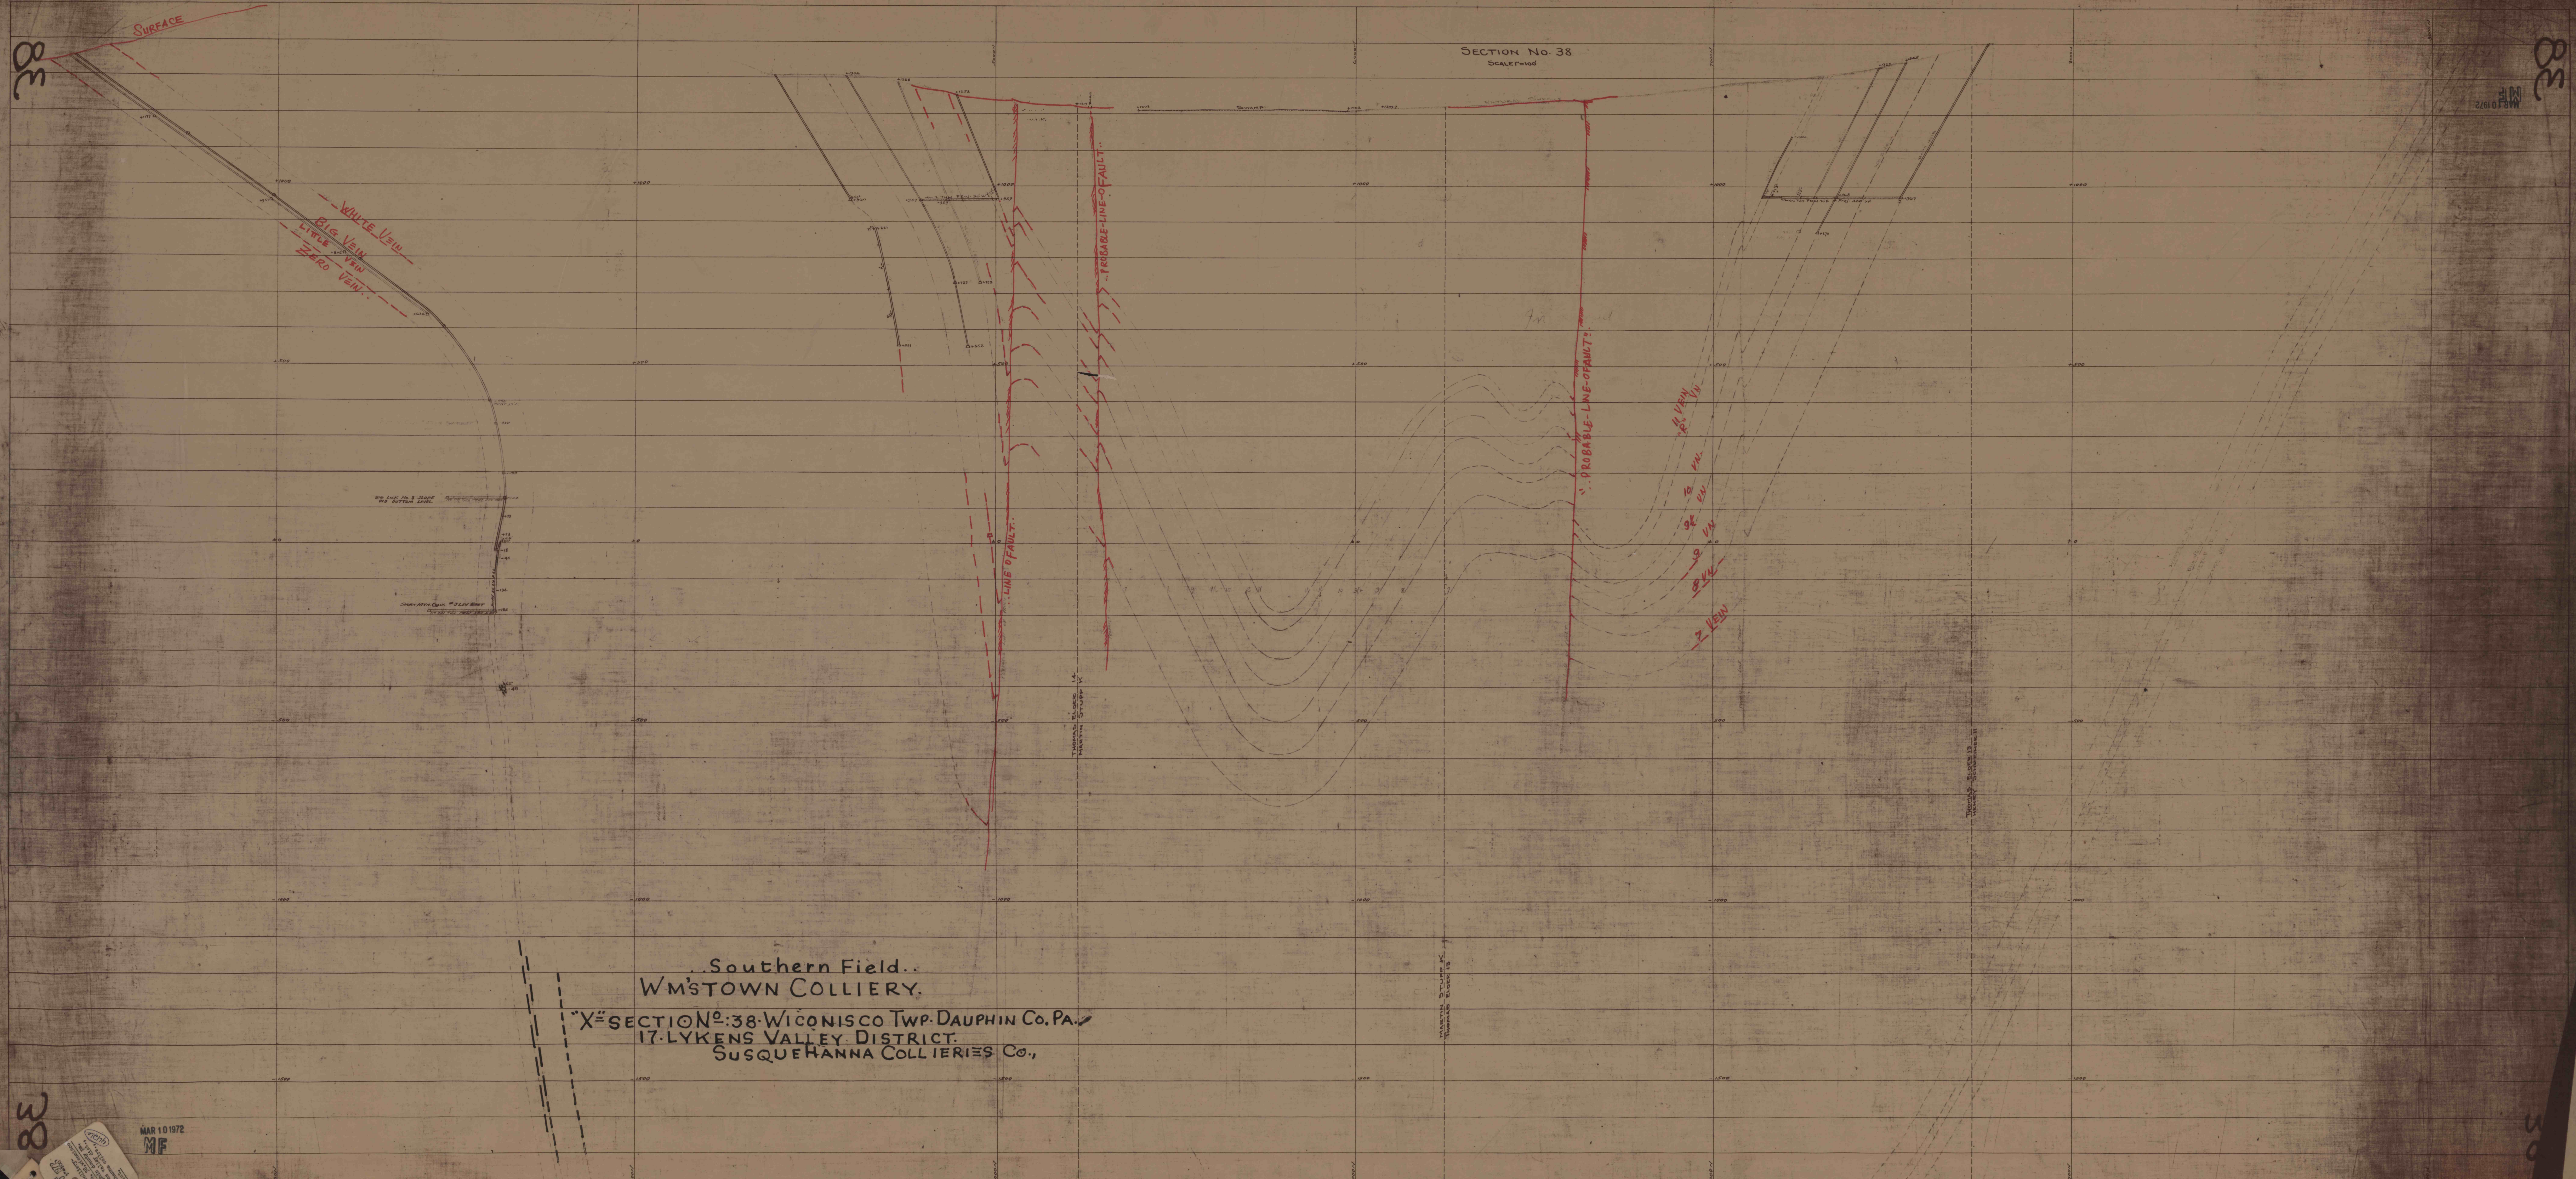

Southern Field.
WM'STOWN COLLIERY.
"X" SECTION No. 38 WICONISCO TWP. DAUPHIN CO. PA.
17 LYKENS VALLEY DISTRICT.
SUSQUEHANNA COLLIERY CO.,

38
MAR 10 1972
MF

38
MAR 10 1972
MF

38