


OTTO #30

OTTO #30

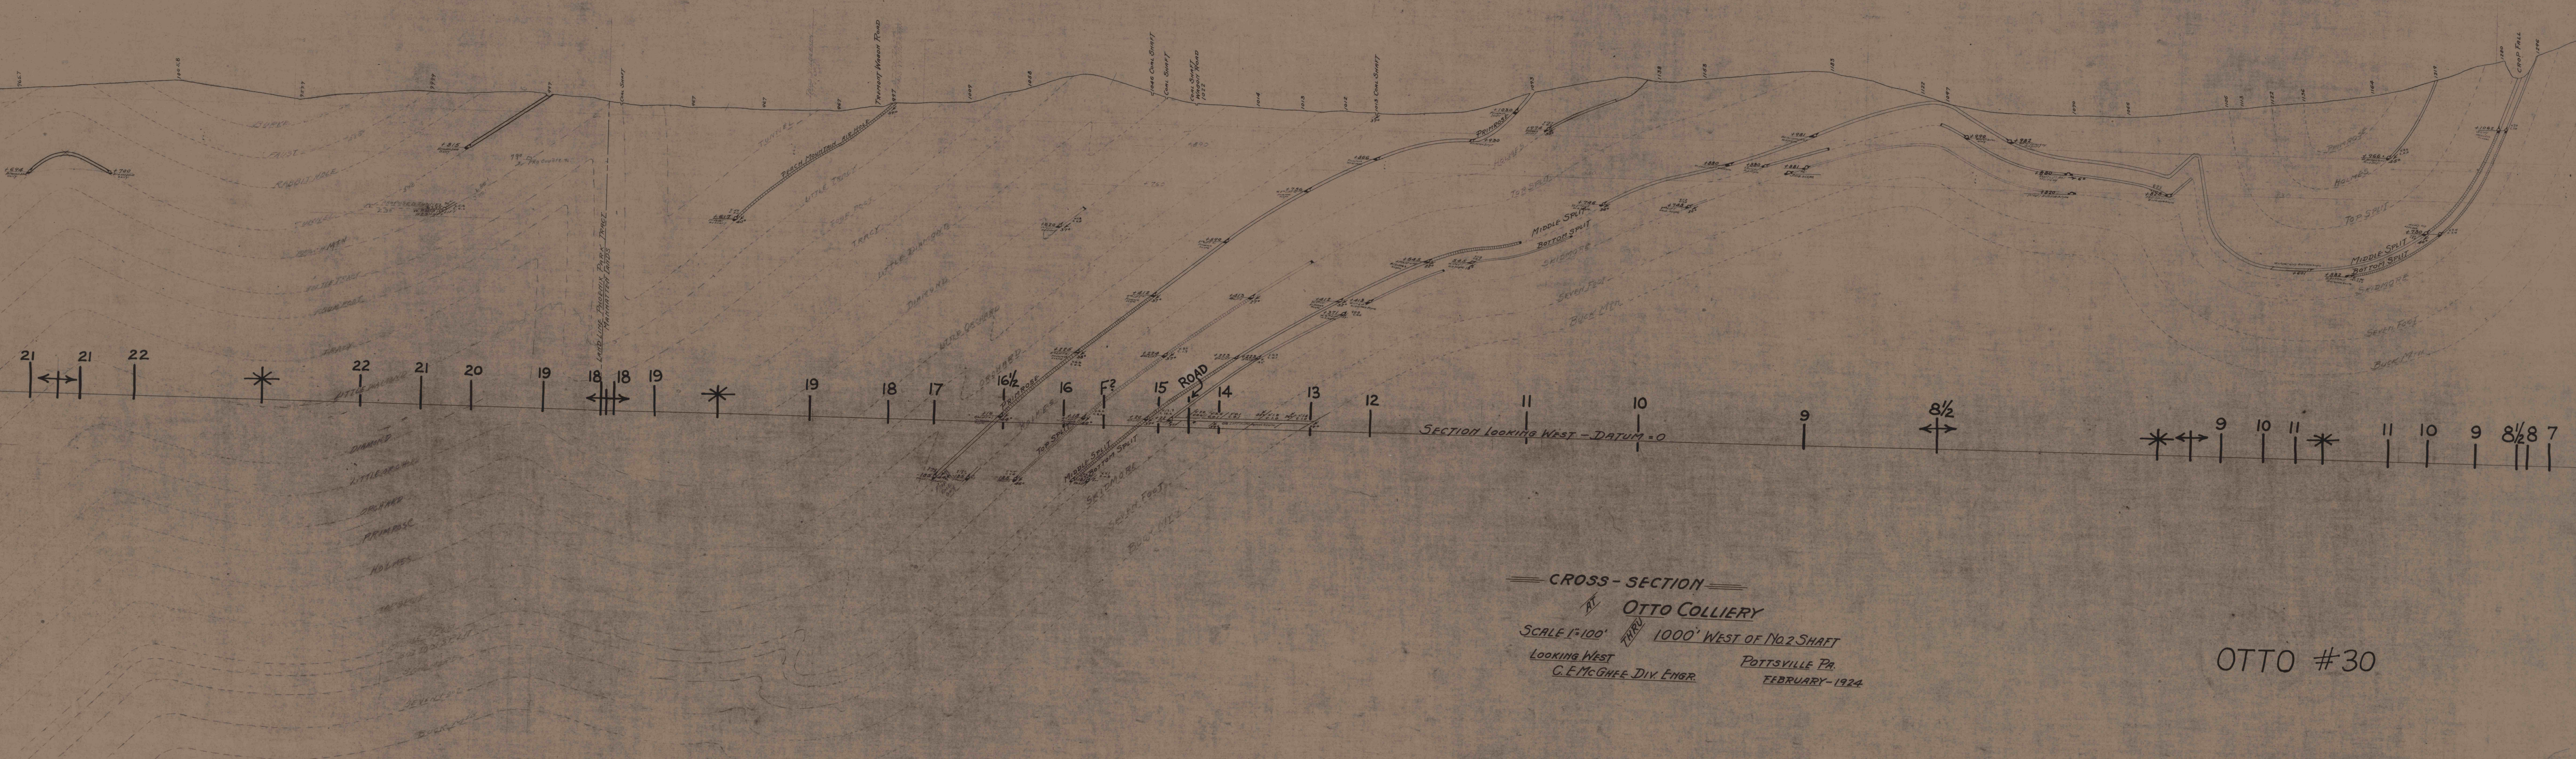

CROSS-SECTION
OTTO COLLIERY
SCALE 1"=100'
LOOKING WEST
C. E. MCGHEE DIV. ENGR.
1000' WEST OF NO. 2 SHAFT
POTTSVILLE PA.
FEBRUARY-1924

OTTO #30

OTTO # 30

OTTO # 30