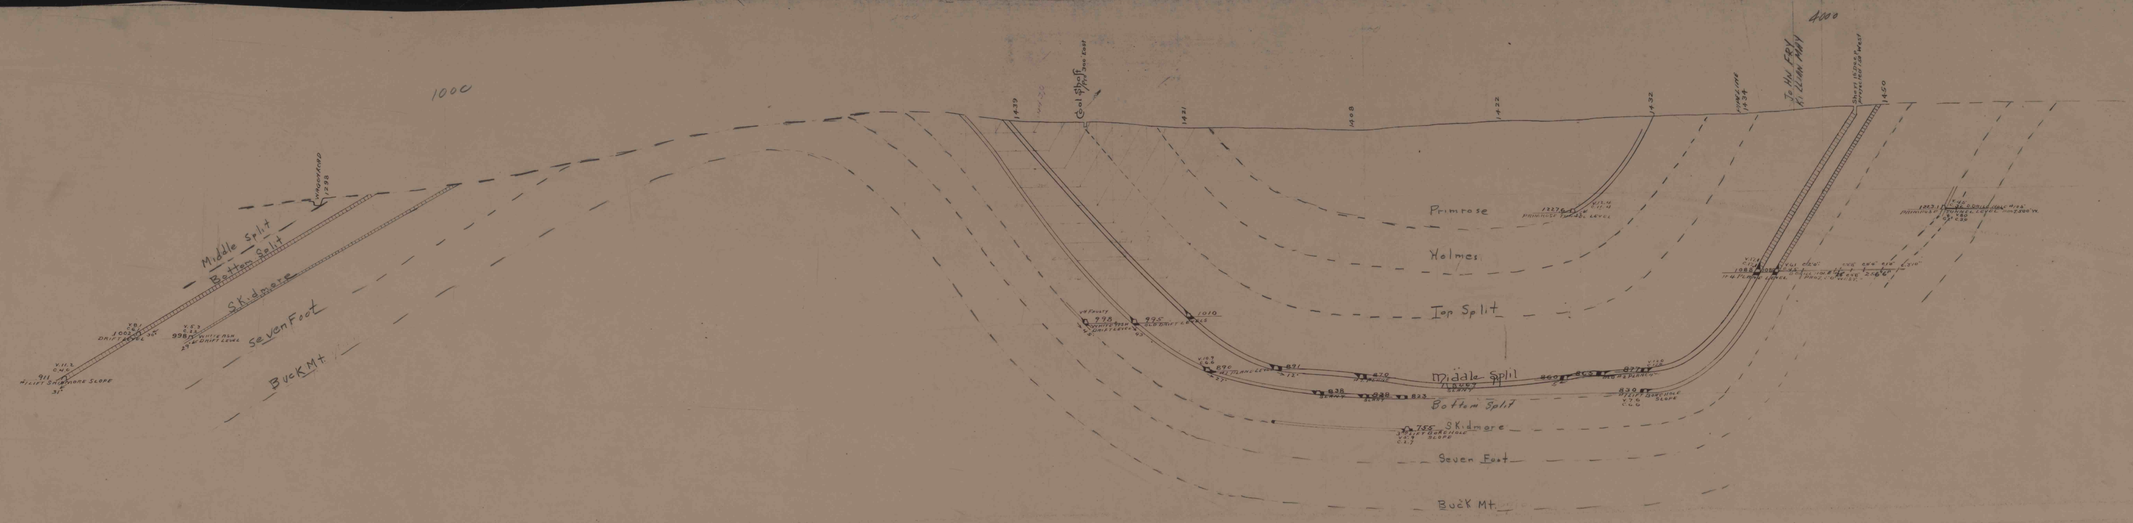

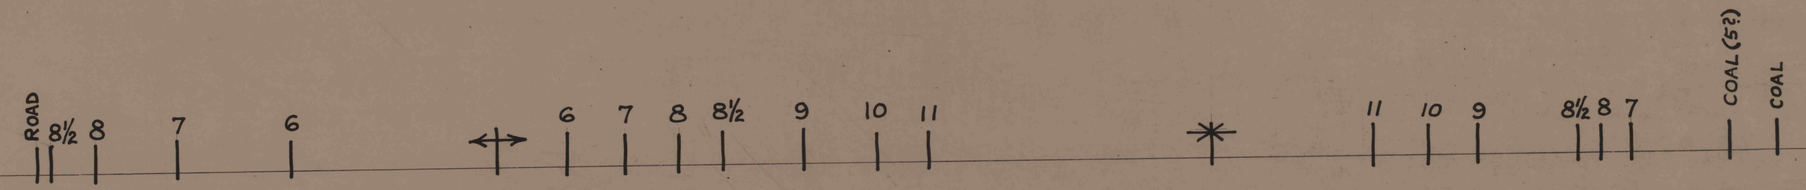

OTTO #34

CROSS-SECTION

AT OTTO COLLIERY

SCALE 1"=100' THRU 4500' WEST OF #2 SHAFT

LOOKING WEST POTTSVILLE, PA.

C.F. McGHEE D.E. MARCH-1924