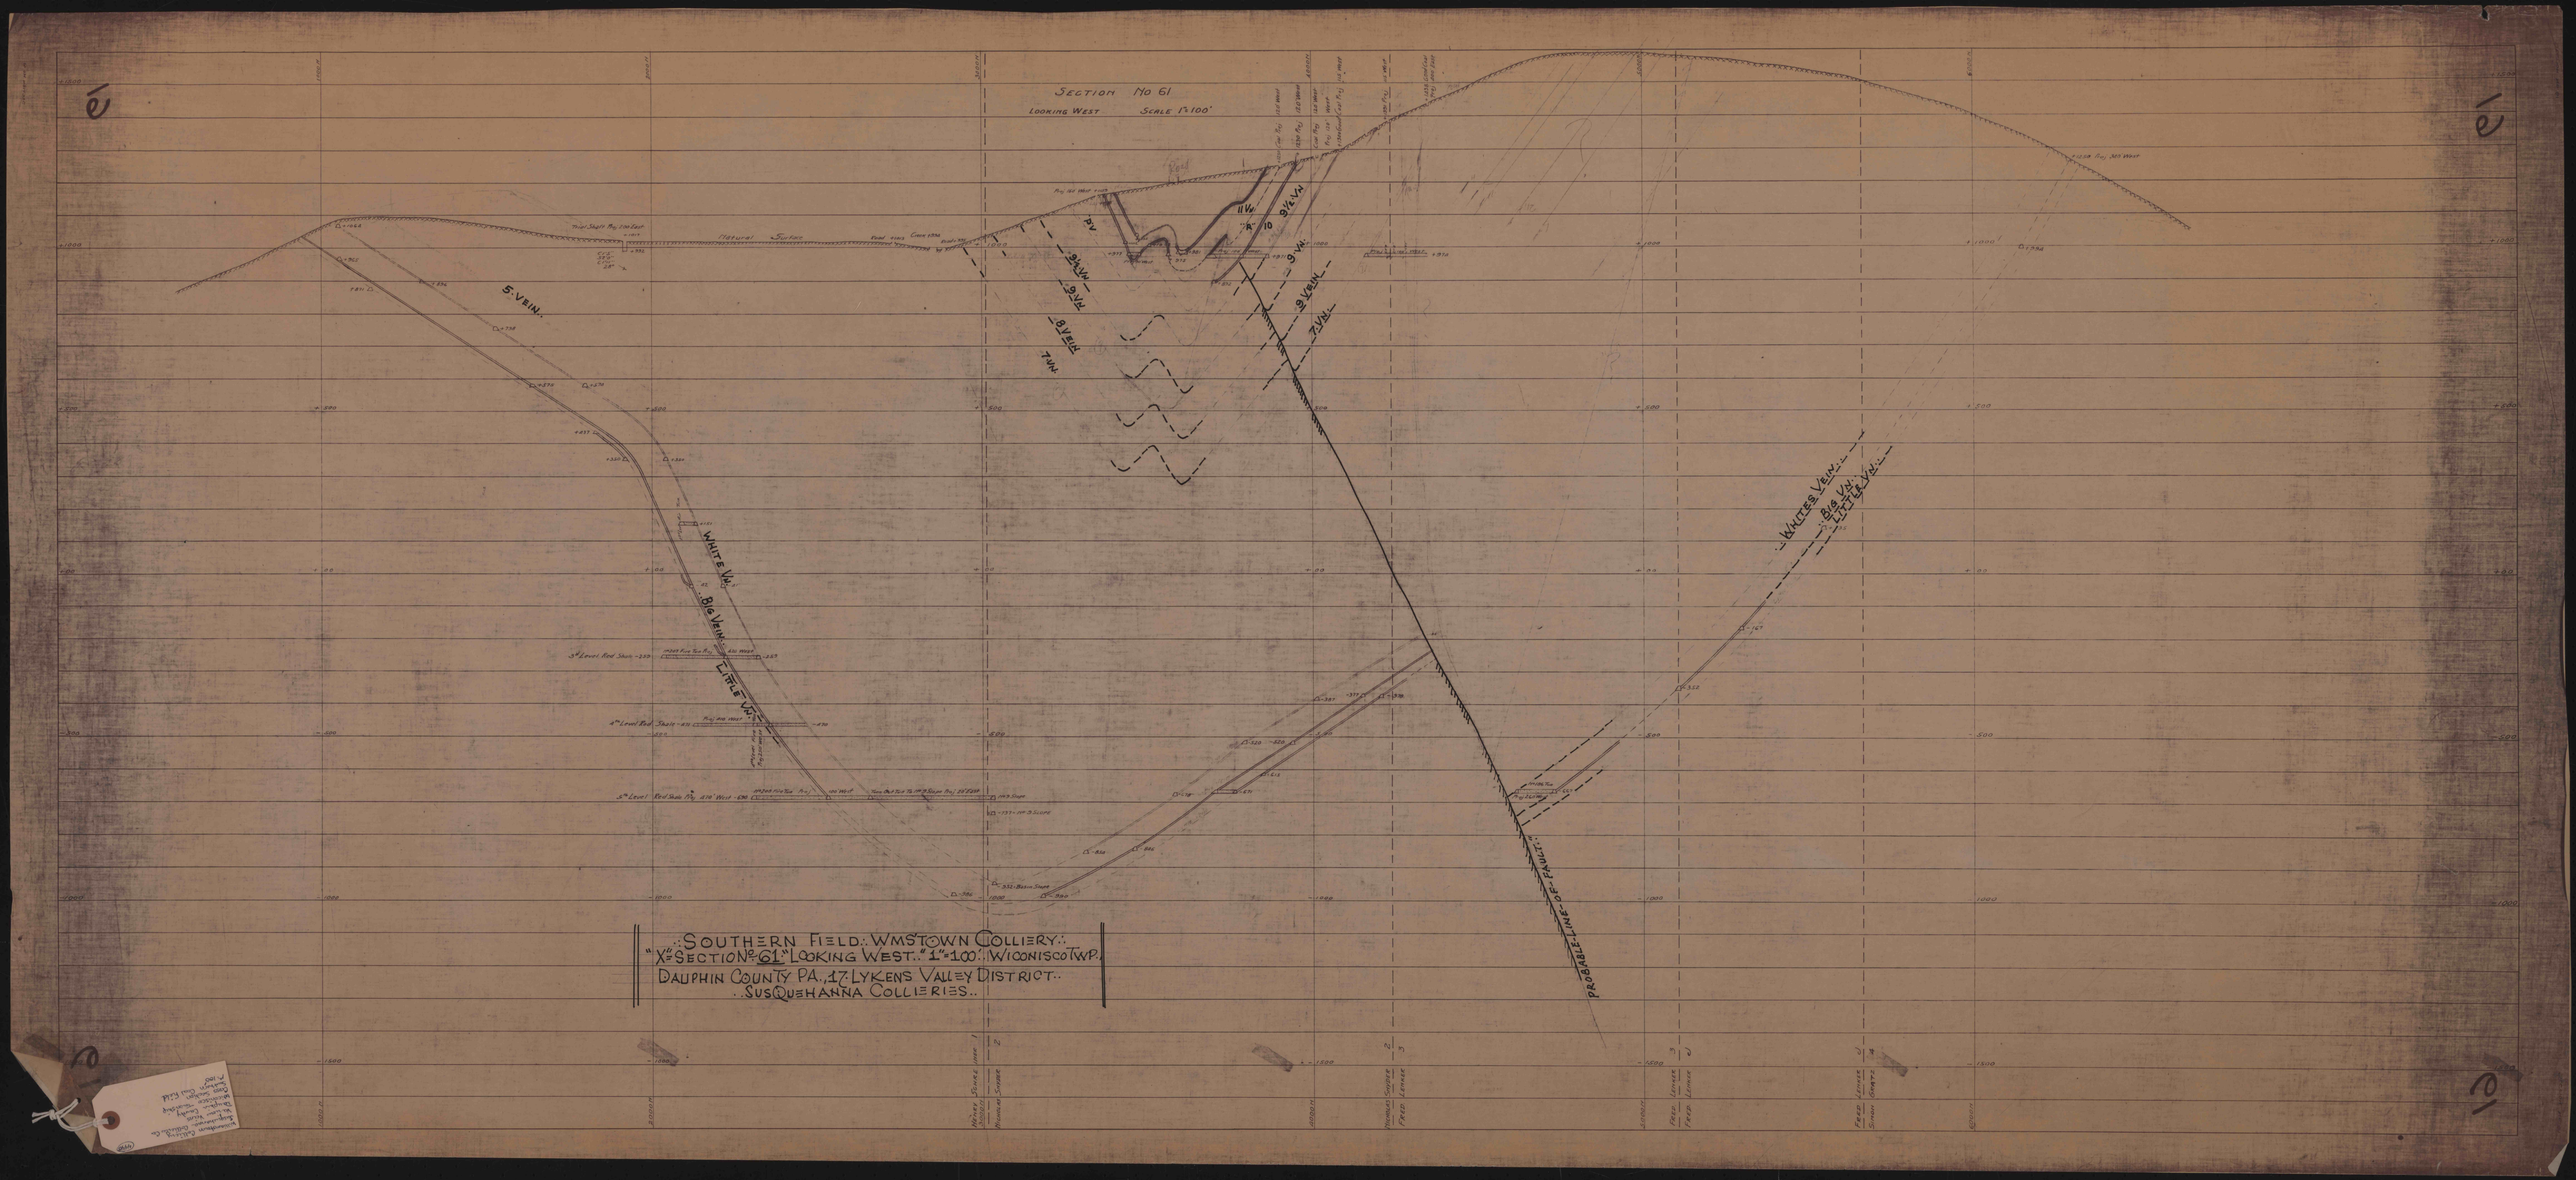
SECTION No 61
LOOKING WEST SCALE 1"=100'
5' VEIN
WHITE VN.
BIG VEIN
LITTLE VN.
11 VN.
10
9½ VN.
9 VEIN
7½ VN.
7 VN.
WHITES VEIN
BIG VN.
LITTLE VN.
PROBABLE LINE OF FAULT
SOUTHERN FIELD: WMSTOWN COLLIERY:
"X" SECTION No 61 "LOOKING WEST." 1"=100'. WIconisco TWP.
DAUPHIN COUNTY PA., 17 LYKENS VALLEY DISTRICT.
SUSQUEHANNA COLLIERIES.