


Map of Reiff & Hoff Stone Crusher
 and area of stone removed
 Dauphin County
 Lykens Township
 Surface Southern Coal field
 1"=100'

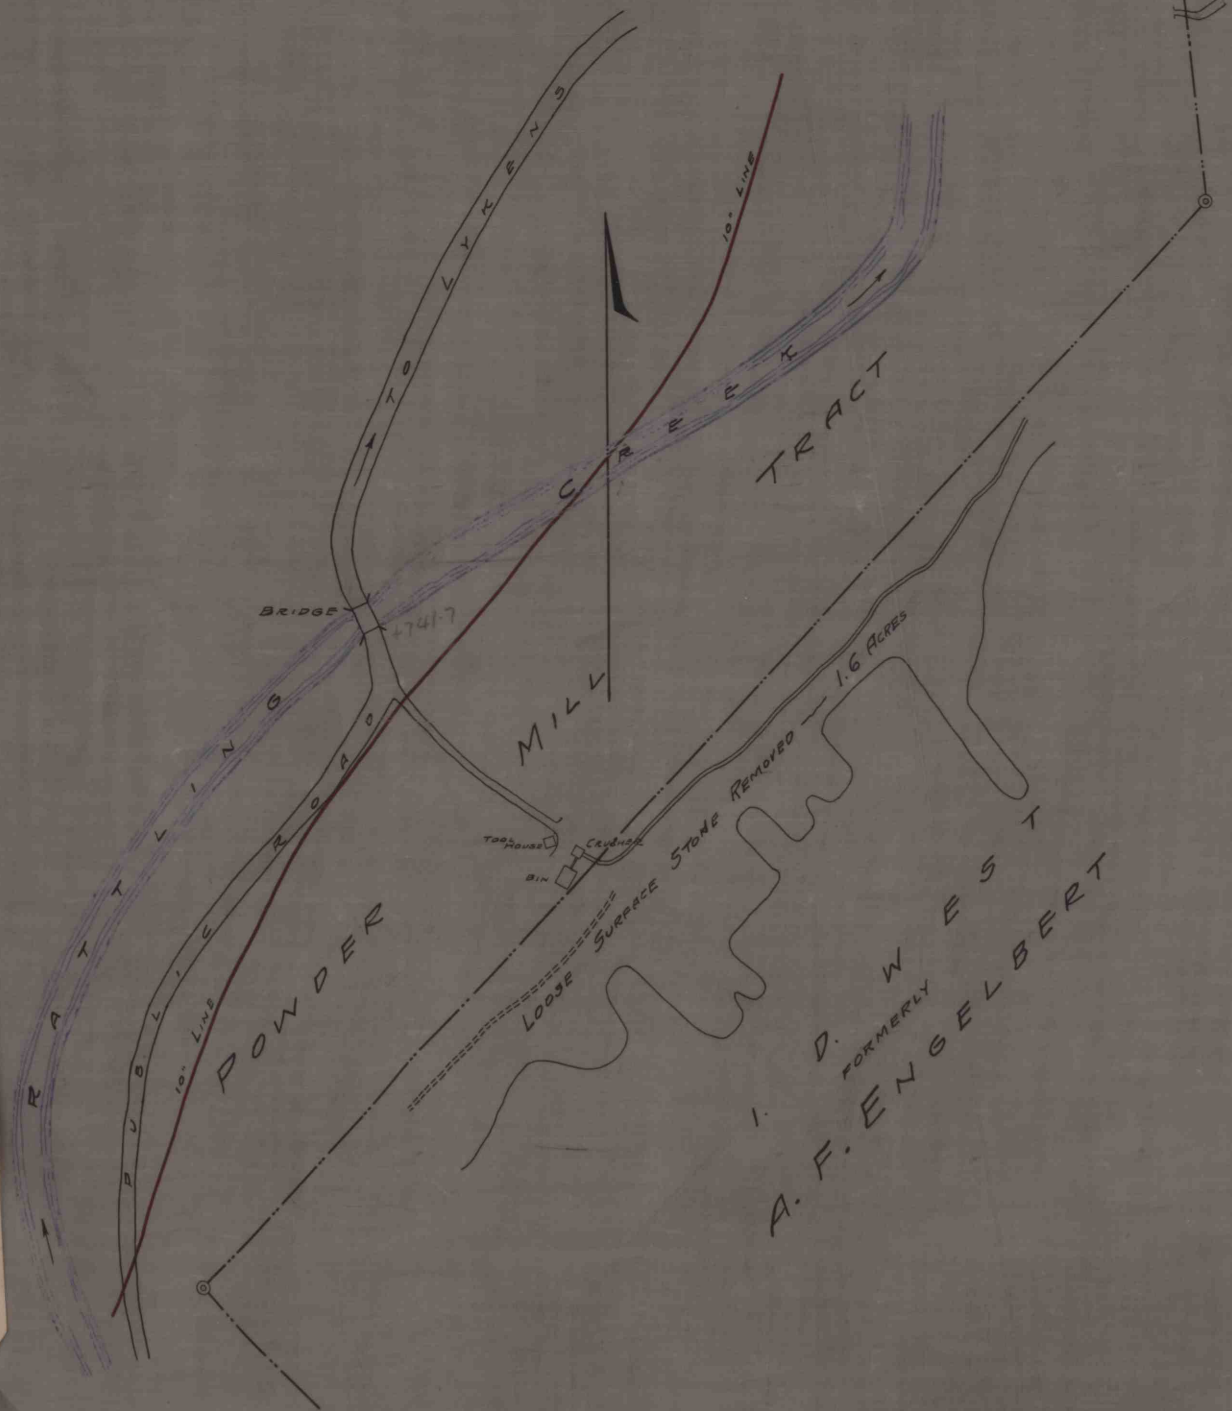

MAP SHOWING LOCATION OF REIFF & HOFF STONE CRUSHER
 ALSO SHOWING AREA OF STONE REMOVED.
 Lykens, Pa. Scale 1"=100'