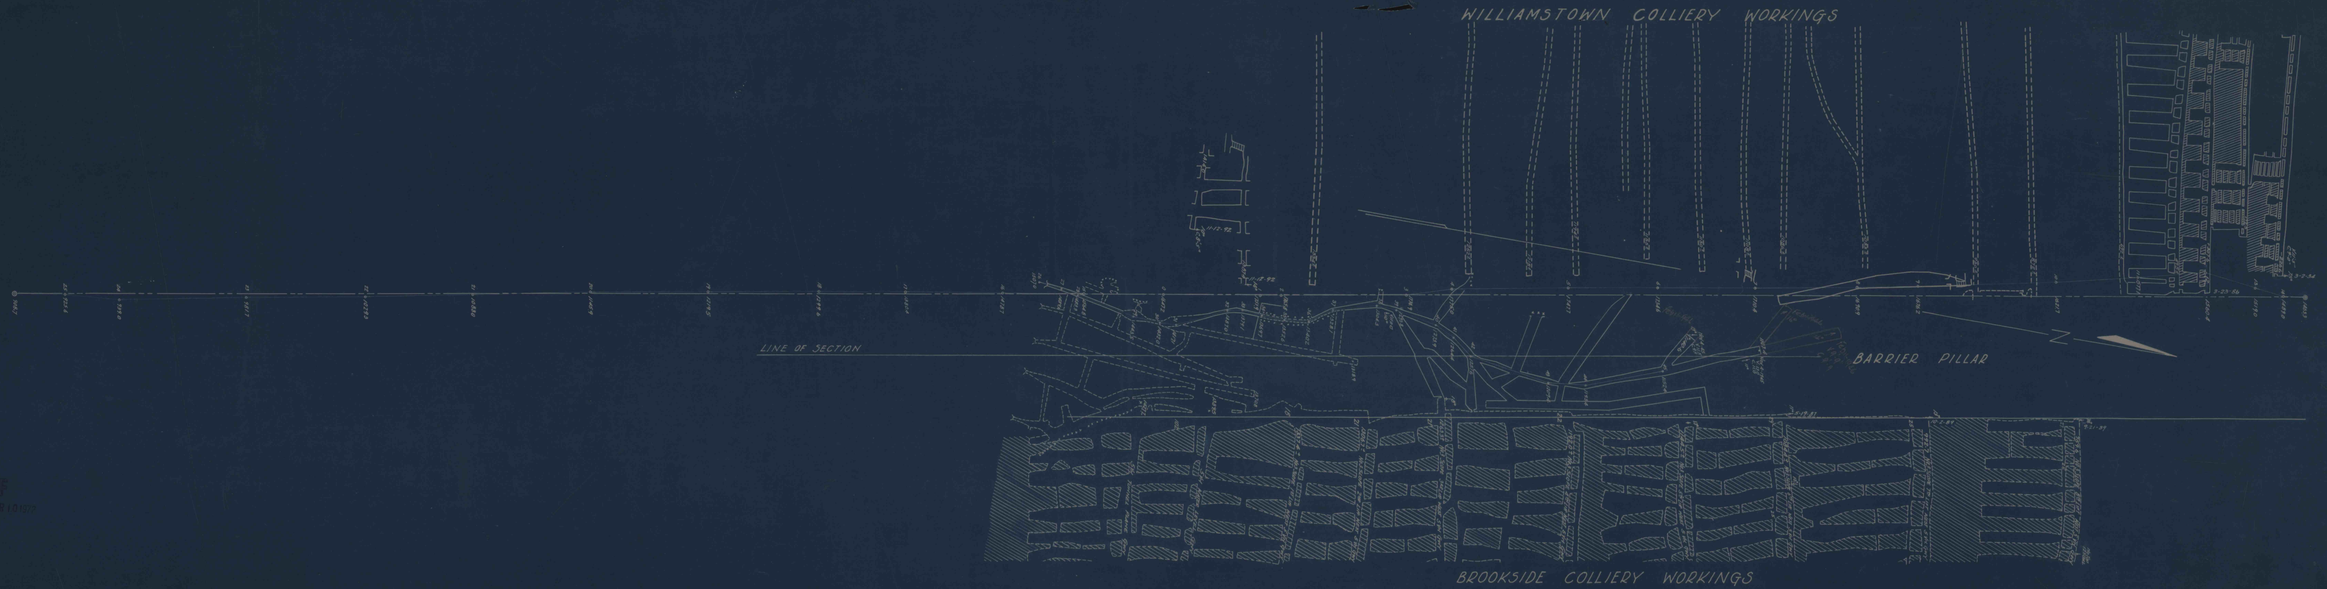

MAP SHOWING MINE WORKINGS IN LYKENS VALLEY WESTERN
IN BARRIER PILLAR BETWEEN
WILLIAMSTOWN AND BROOKSIDE COLLIERIES
SCALE 1" = 100 FT.
NOVEMBER 4 - 1965
THOMAS J. LEPPO, CONSULTING ENGINEER
PALMYRA, PA.

MAR 13 1972