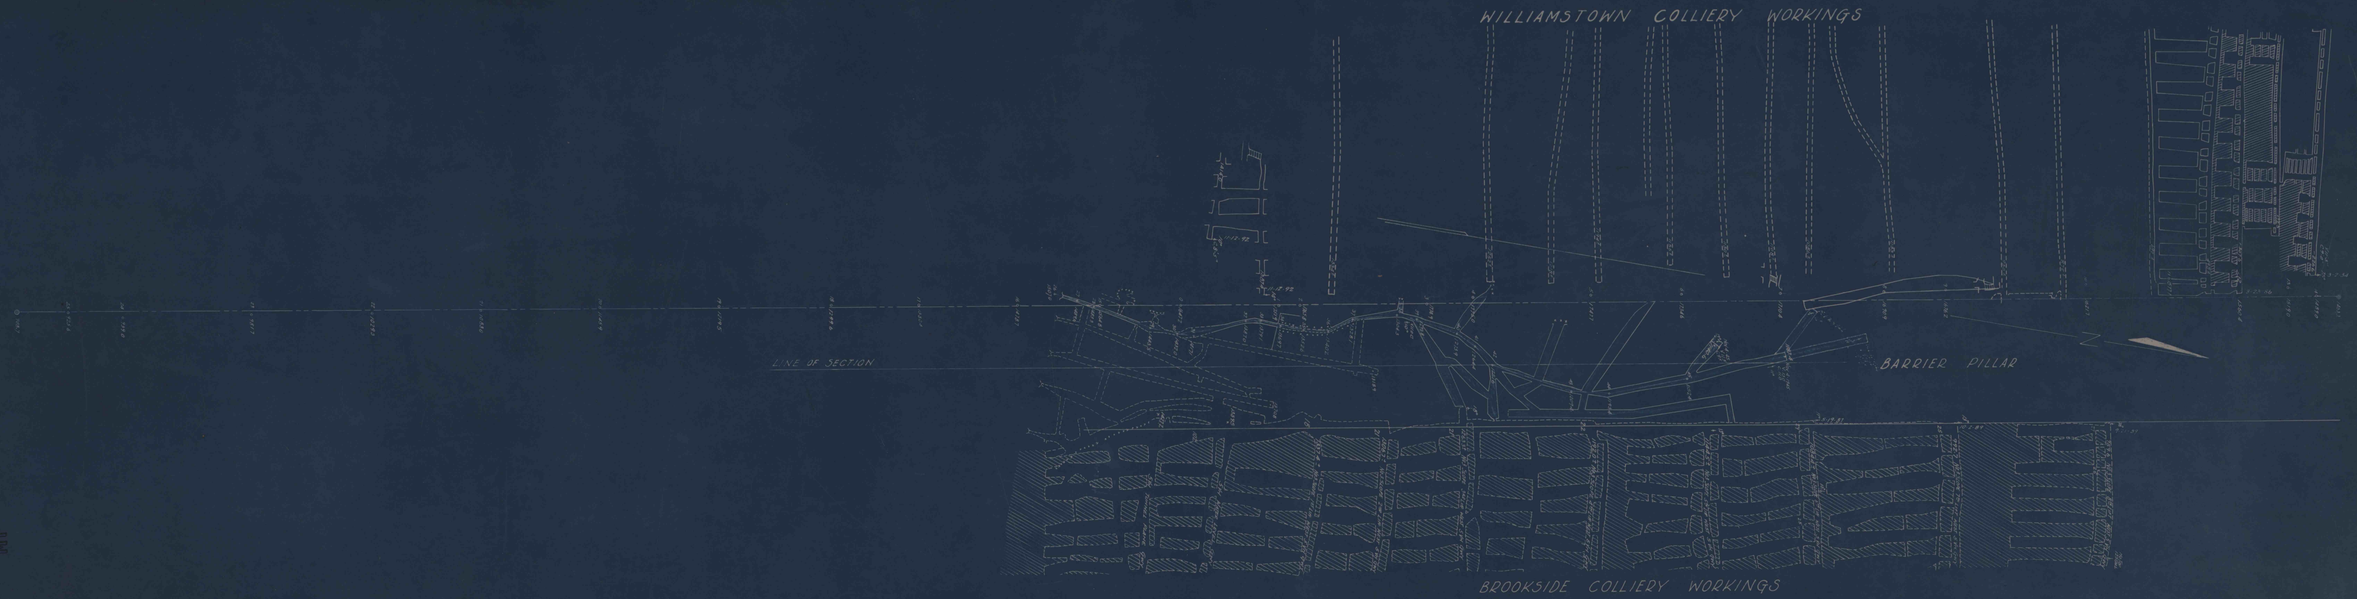

MAP SHOWING MINE WORKINGS IN MYKERS VALLEY W.S.I.CN
& BARRIER PILLAR SAFEWAY
WILLIAMSTOWN AND BROOKSIDE COLLIERIES