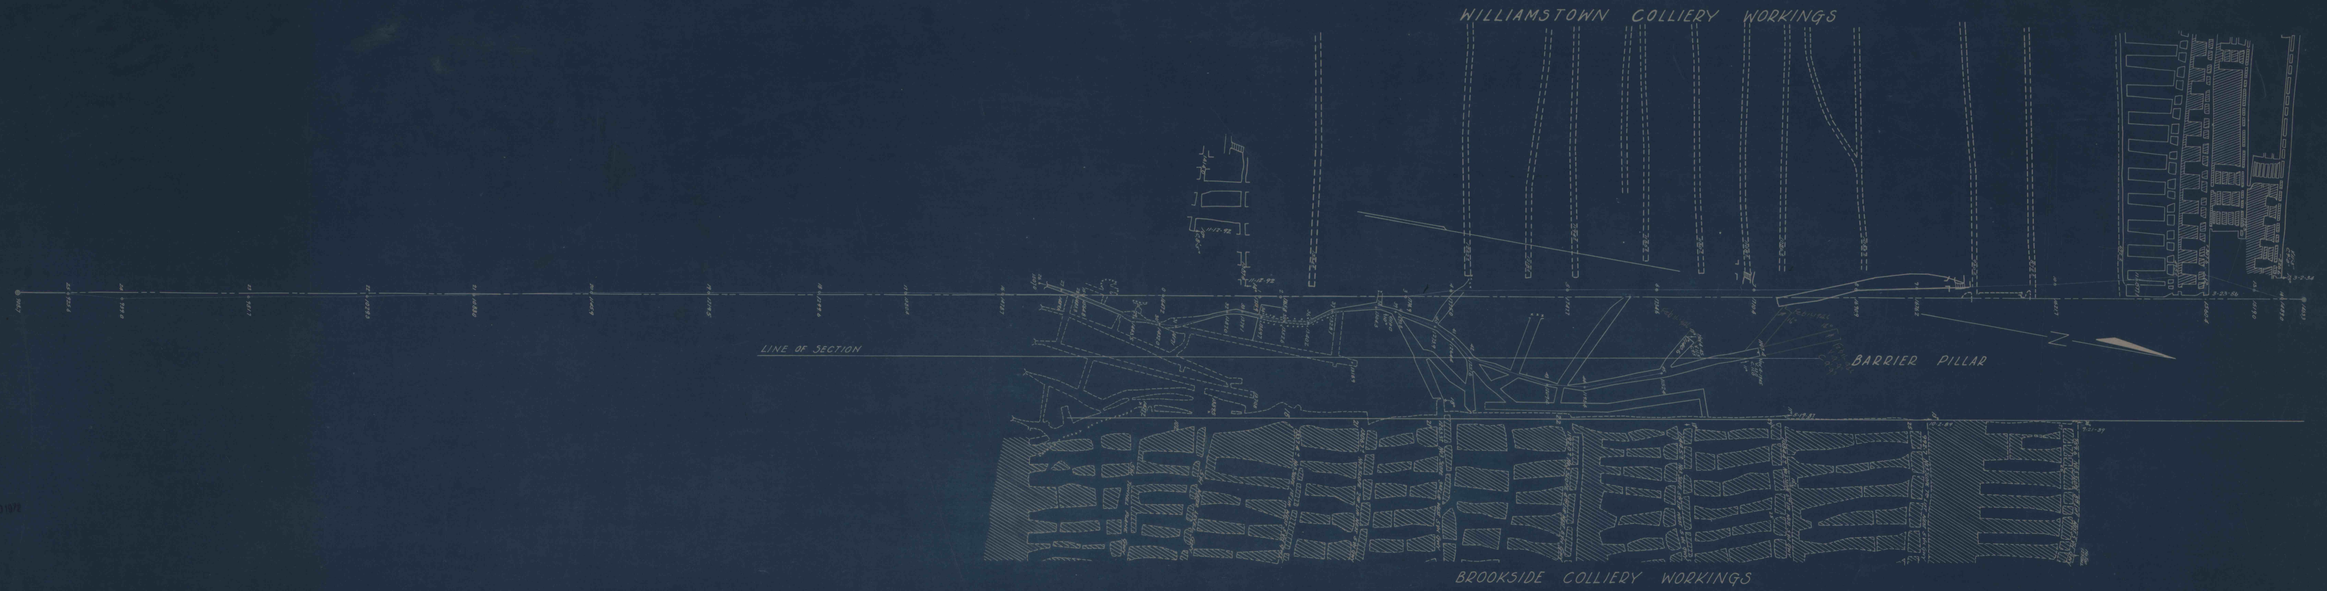

MAP SHOWING MINE WORKINGS IN VEINS MAULY & SKEIN
IN BARRIER PILLAR BETWEEN
WILLIAMSTOWN AND BROOKSIDE COLLIERIES
SCALE 1"=100'-0" NOVEMBER 4-1908
THOMAS U. LEWIS, CONSULTING ENGINEER
PACKSVILLE PA.

MAR 19 1918