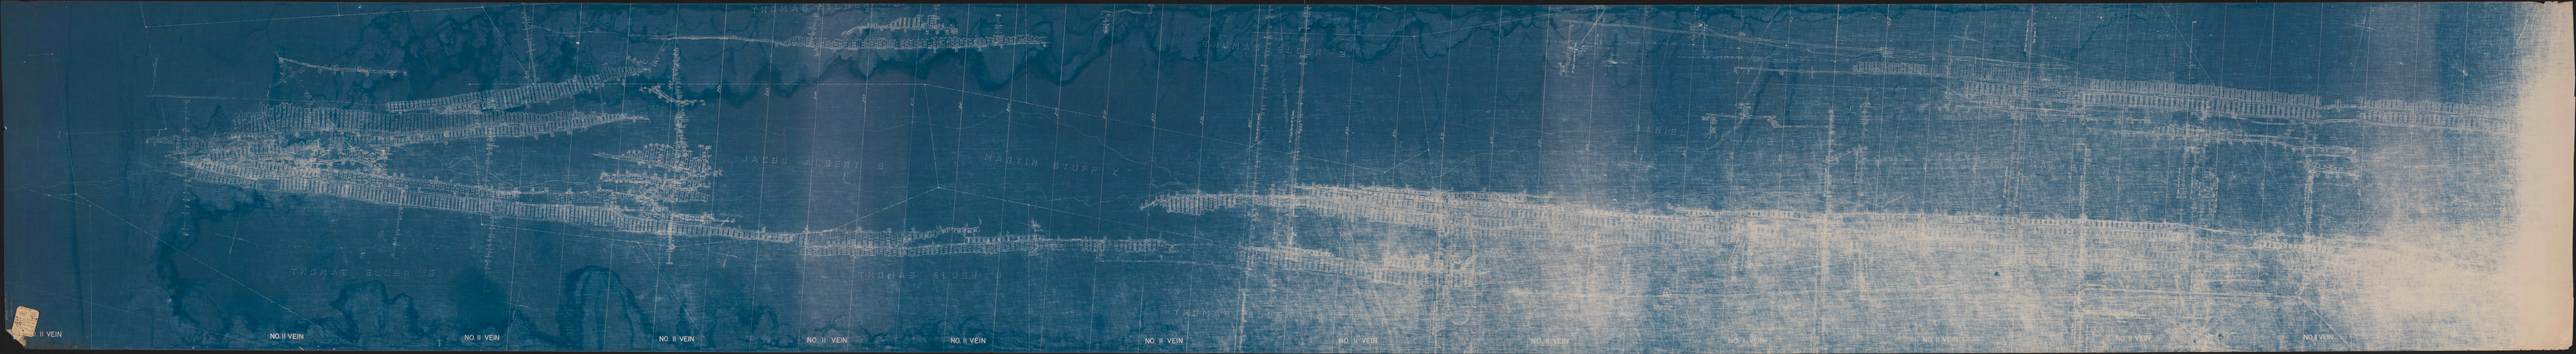
II VEIN
NO. II VEIN
NO. II VEIN
NO. II VEIN
NO. II VEIN
NO. II VEIN
NO. II VEIN
NO. II VEIN
NO. II VEIN
NO. II VEIN
NO. II VEIN
NO. I VEIN
THOMAS ELDER
JACOB ALBERT
MARTIN STUPP