


Map Showing
Where Oil pipe line Survey Crosses
Schuylkill and Susquehanna Lands

Scale 100' inch

Volleril Feb 23rd 1883.

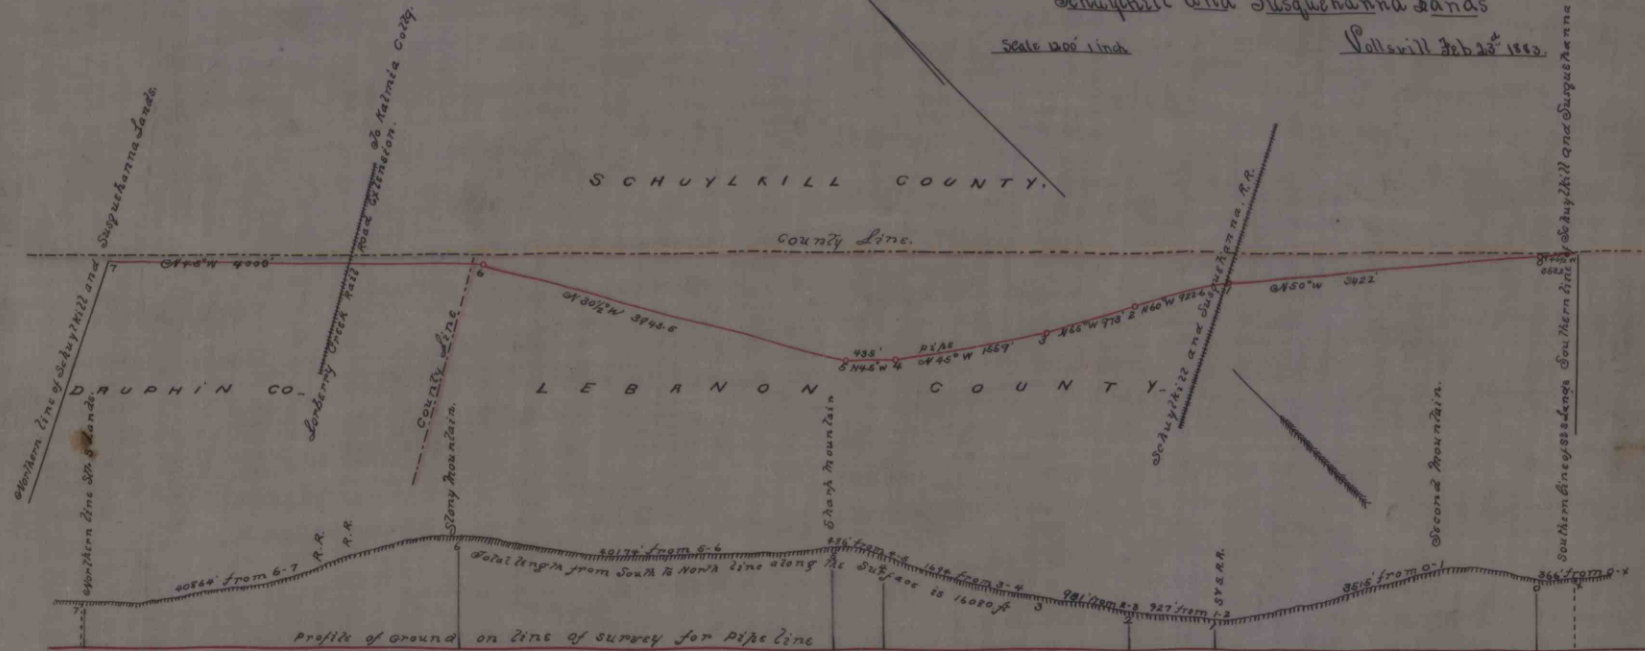

Traced from Original map on file in Recorder's Office
Deed Book G, Vol. 6, Page 350

October 10, 1905

MF

MAR 10 1972