SECTION SHOWING CONSTRUCTION OF DAM ACROSS WEST BRANCH

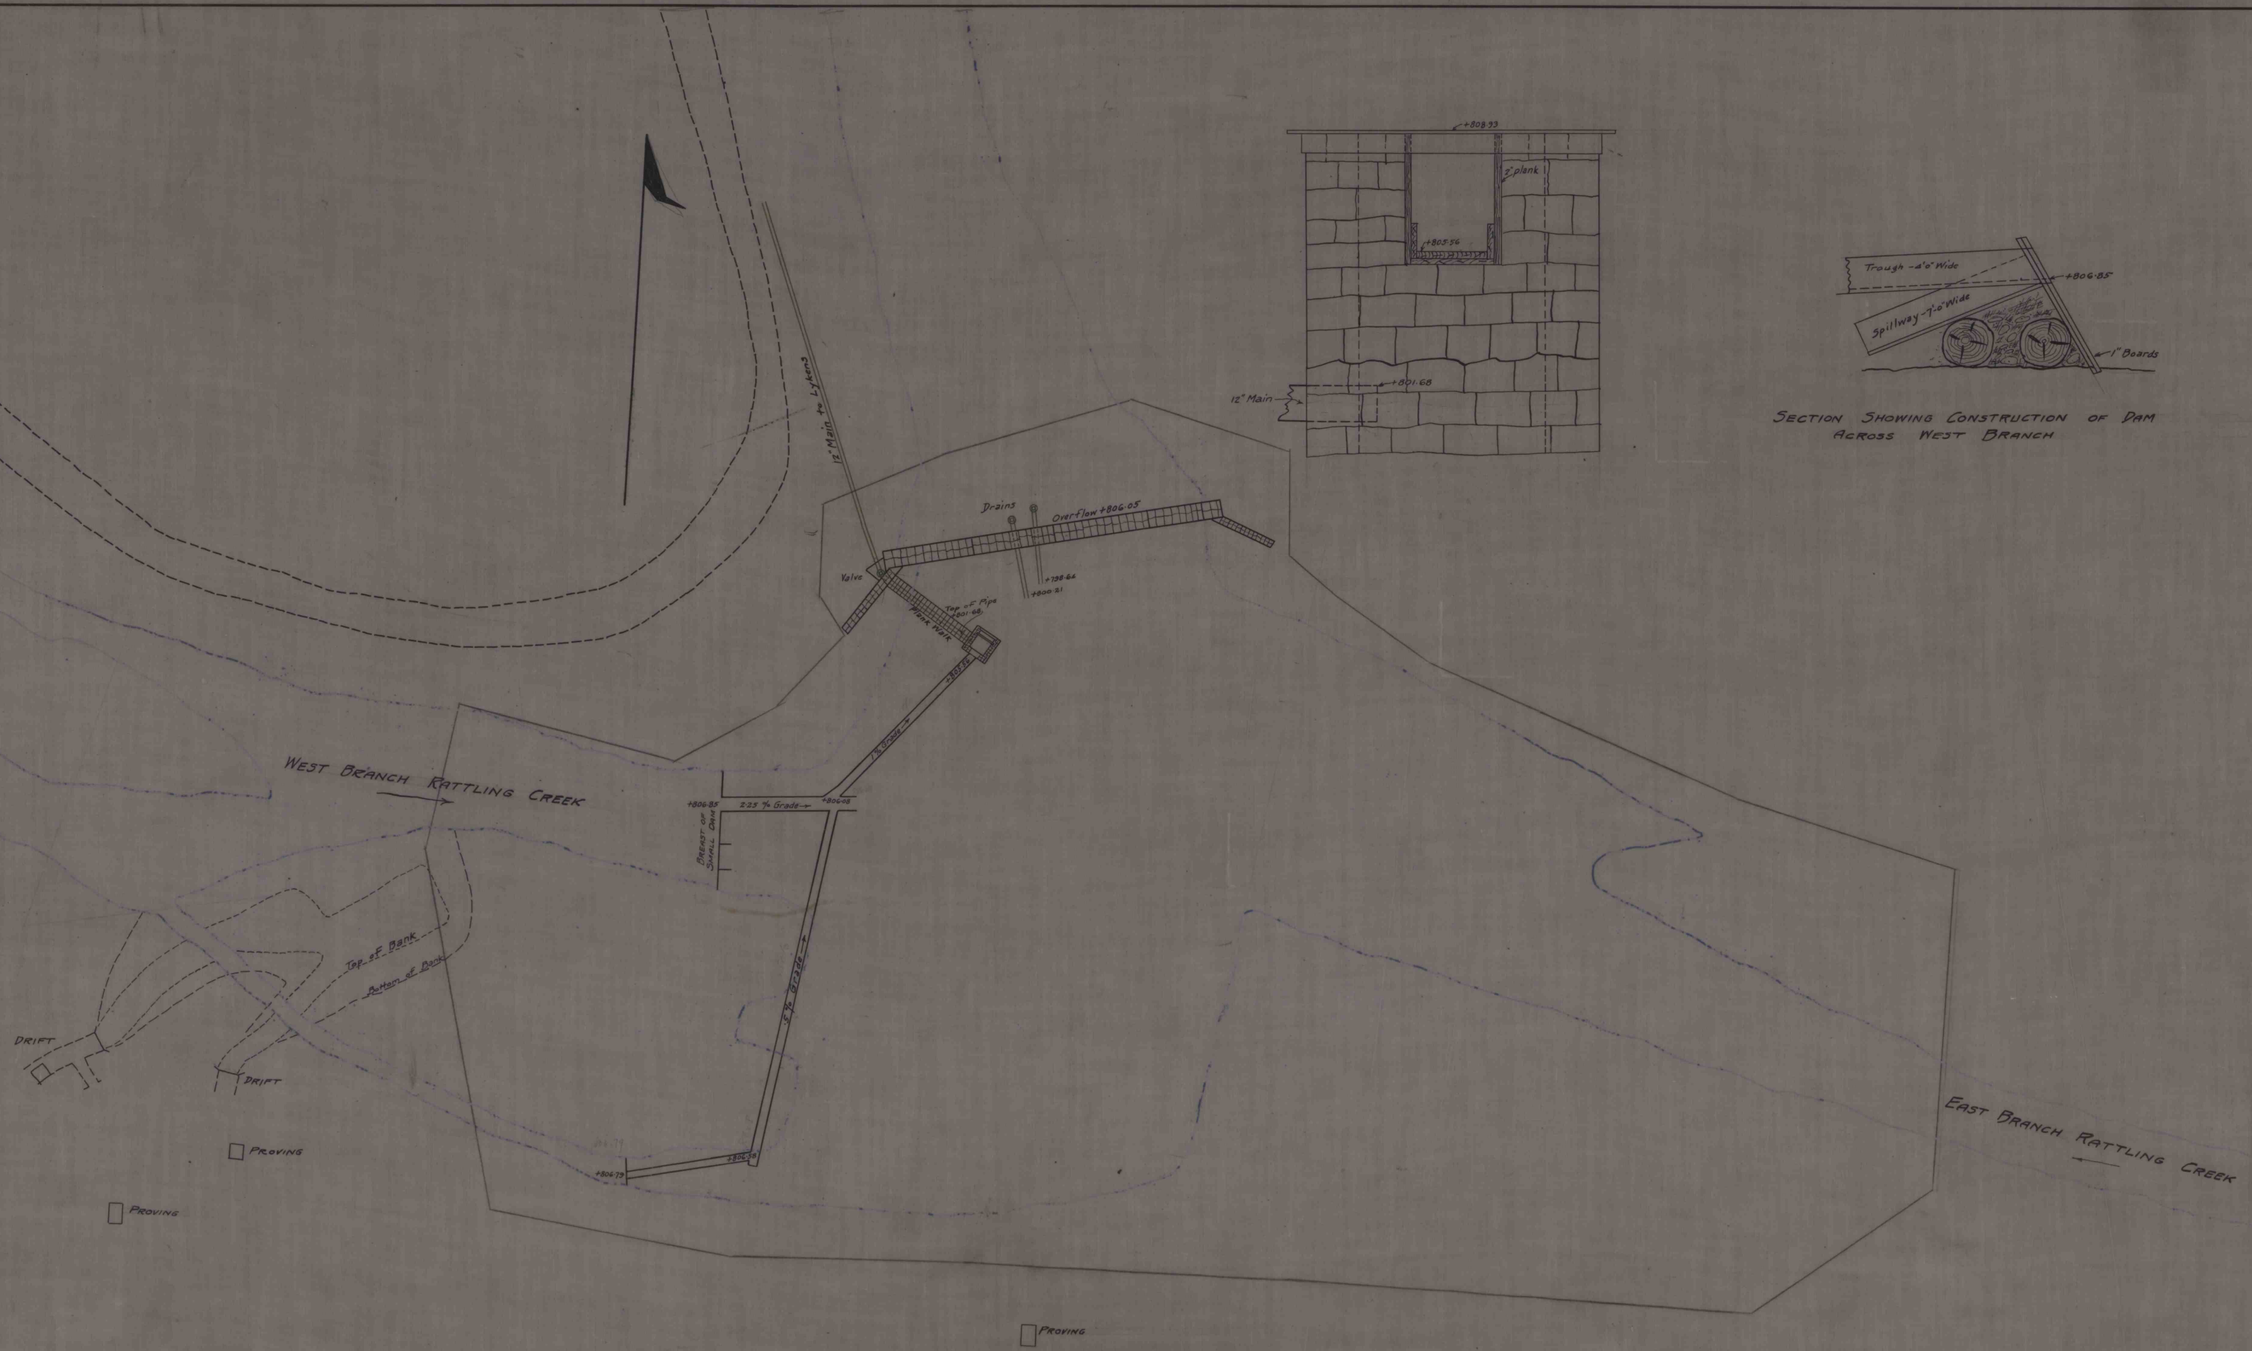

MAP OF LYKENS WATER Co's. RESERVOIR
SHOWING TROUGHS AND DAMS
BUILT FOR PURPOSE OF CLEANING RESERVOIR
LYKENS PA. SEPT. 19, 1913 SCALE 1"=20'

X/32

X/32