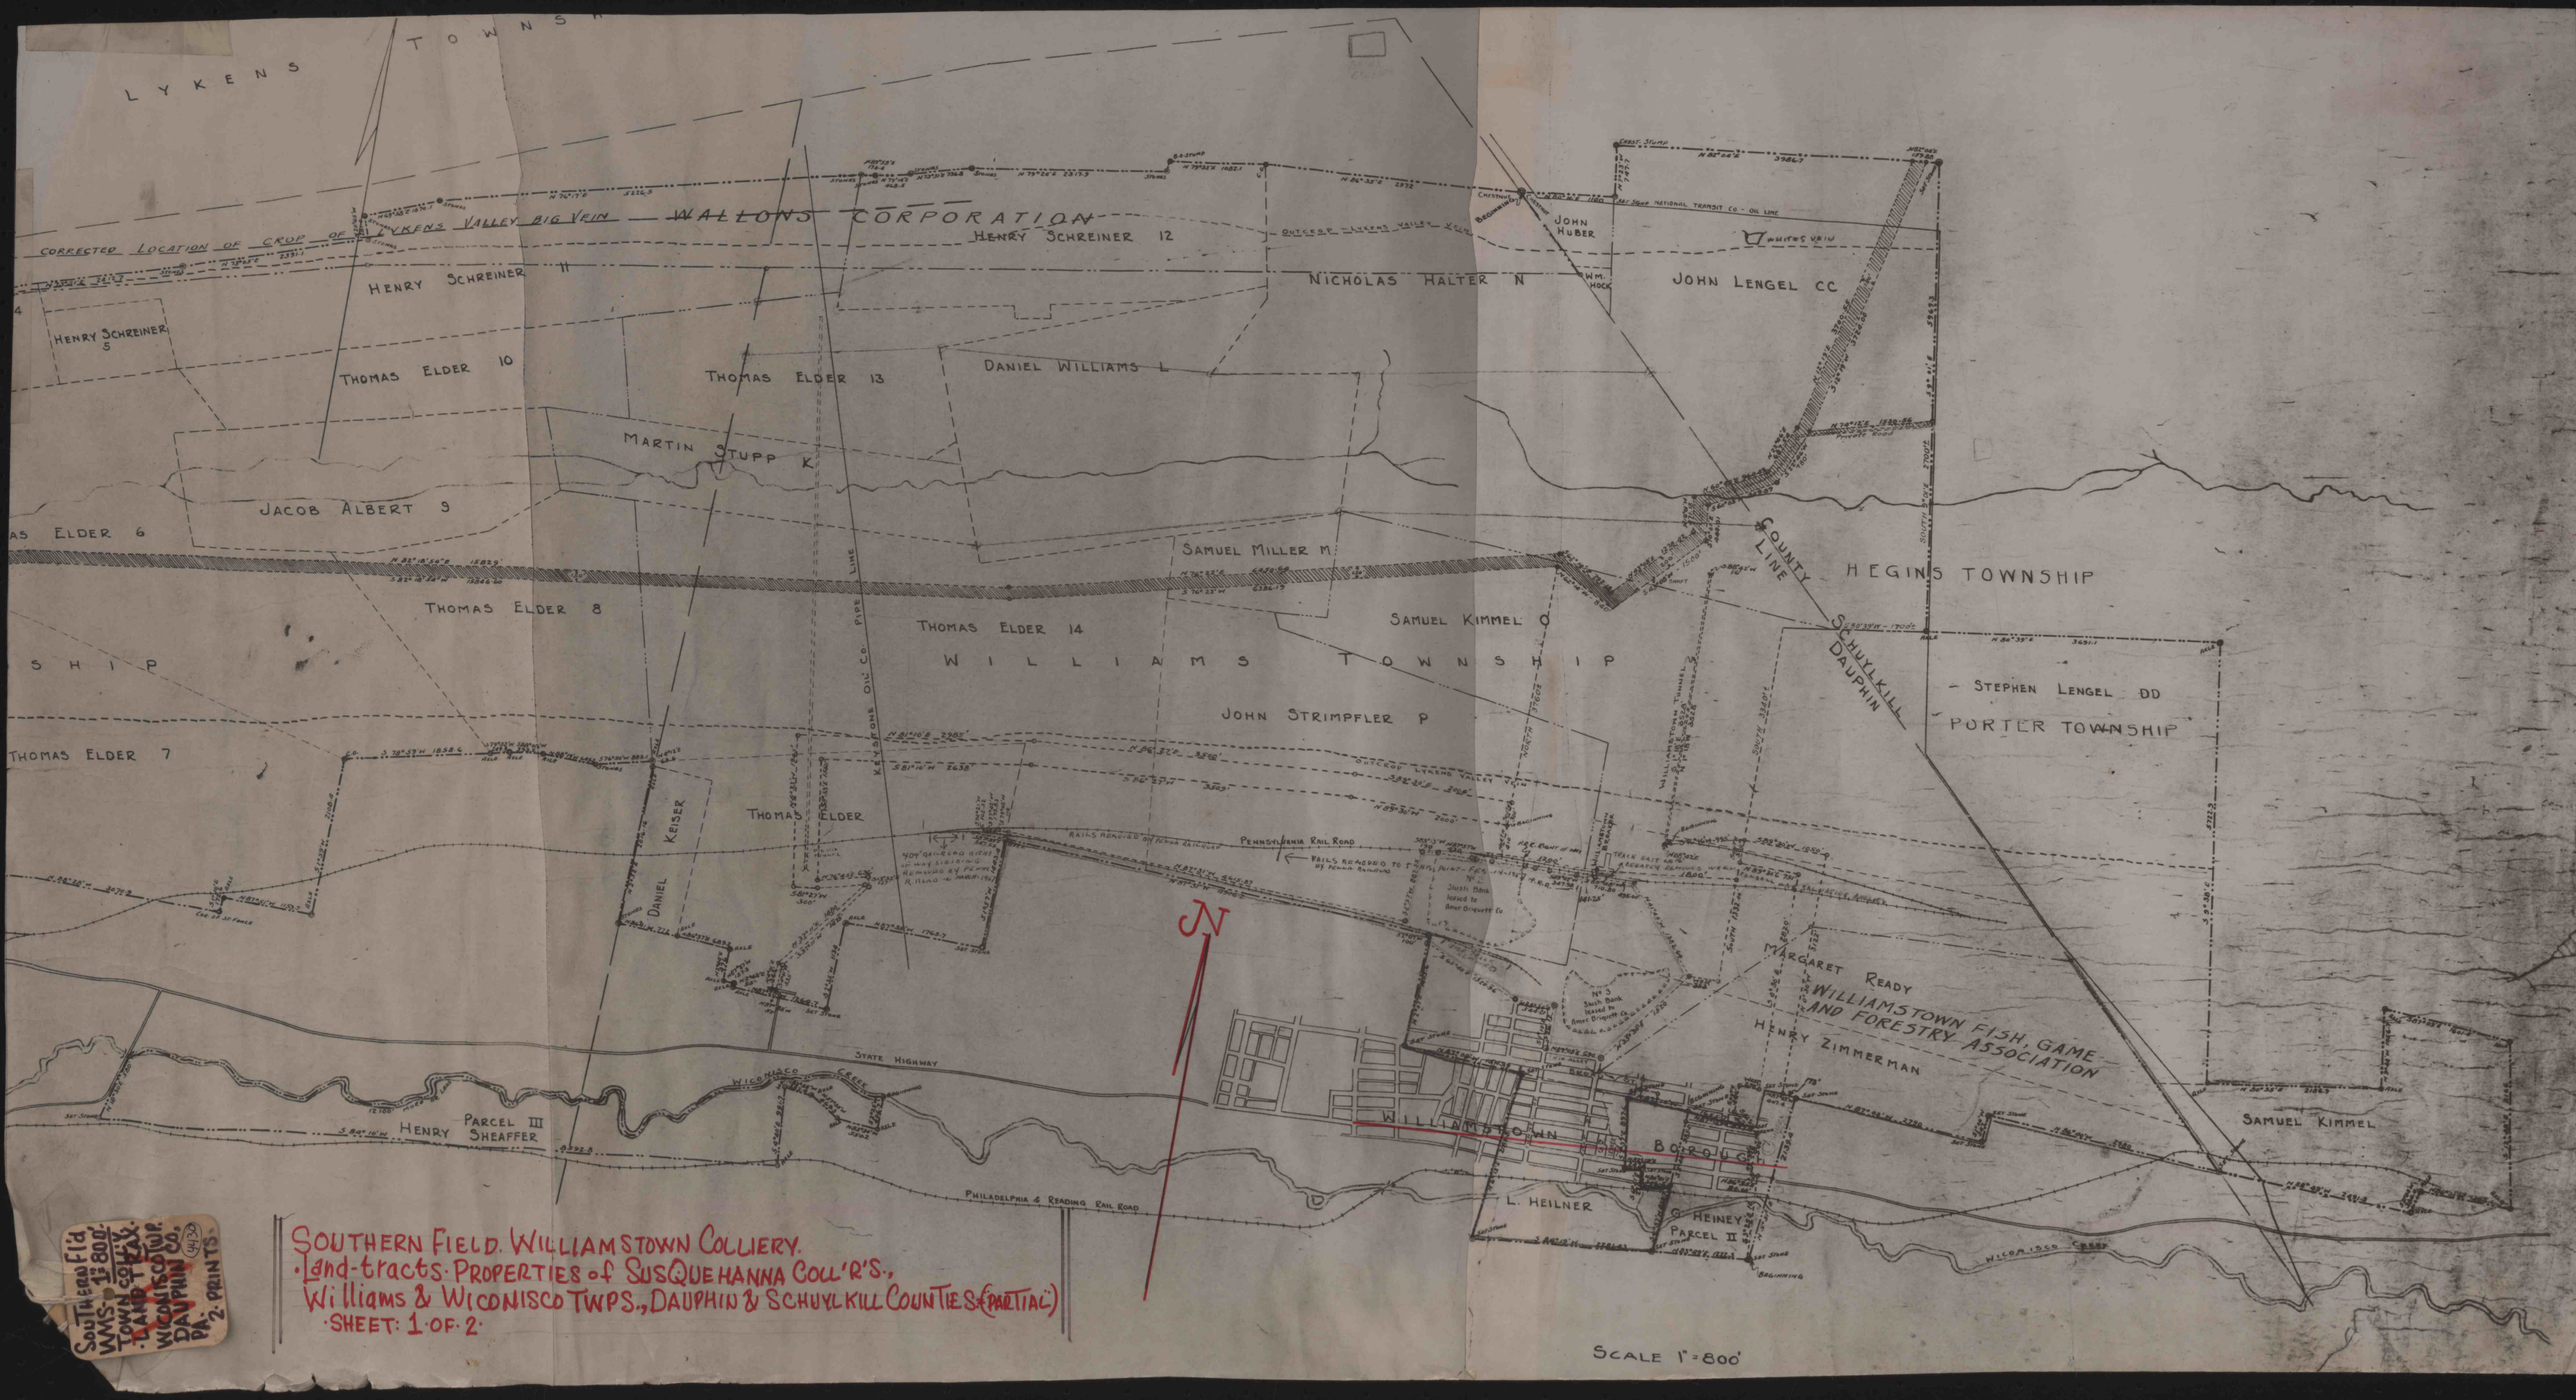

SOUTHERN FIELD. WILLIAMSTOWN COLLIERY.
·Land-tracts·Properties of SUSQUEHANNA COAL CO'S.,
Williams & WICONISCO TWPS., DAUPHIN & SCHUYLKILL COUNTIES (PARTIAL)
·SHEET: 1 OF 2·

SOUTHERN FLD. WMS. TOWN COLLY. 1"=800' LAND PROP. WICONISCO TWP. DAUPHIN CO. PA. 2 PRINTS.