

MAP H-7
MINE 77

N 27 000
E 12 000

N 26 000

E 12 000


N 25 000

N 24 000

E 12 000

N 23 000

S 2 PANEL

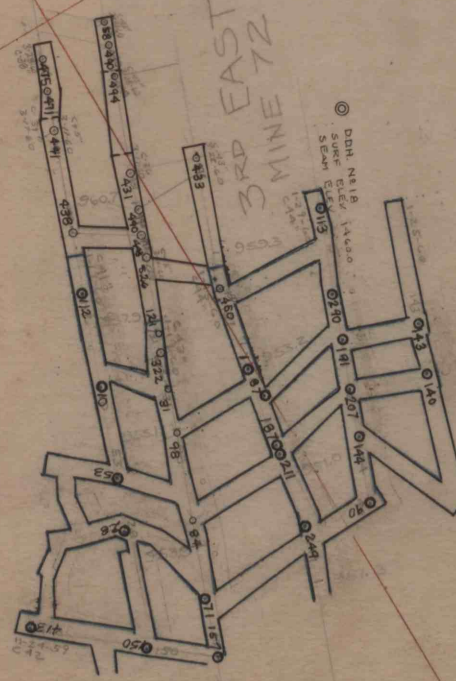

MAP H-7
MINE 77