


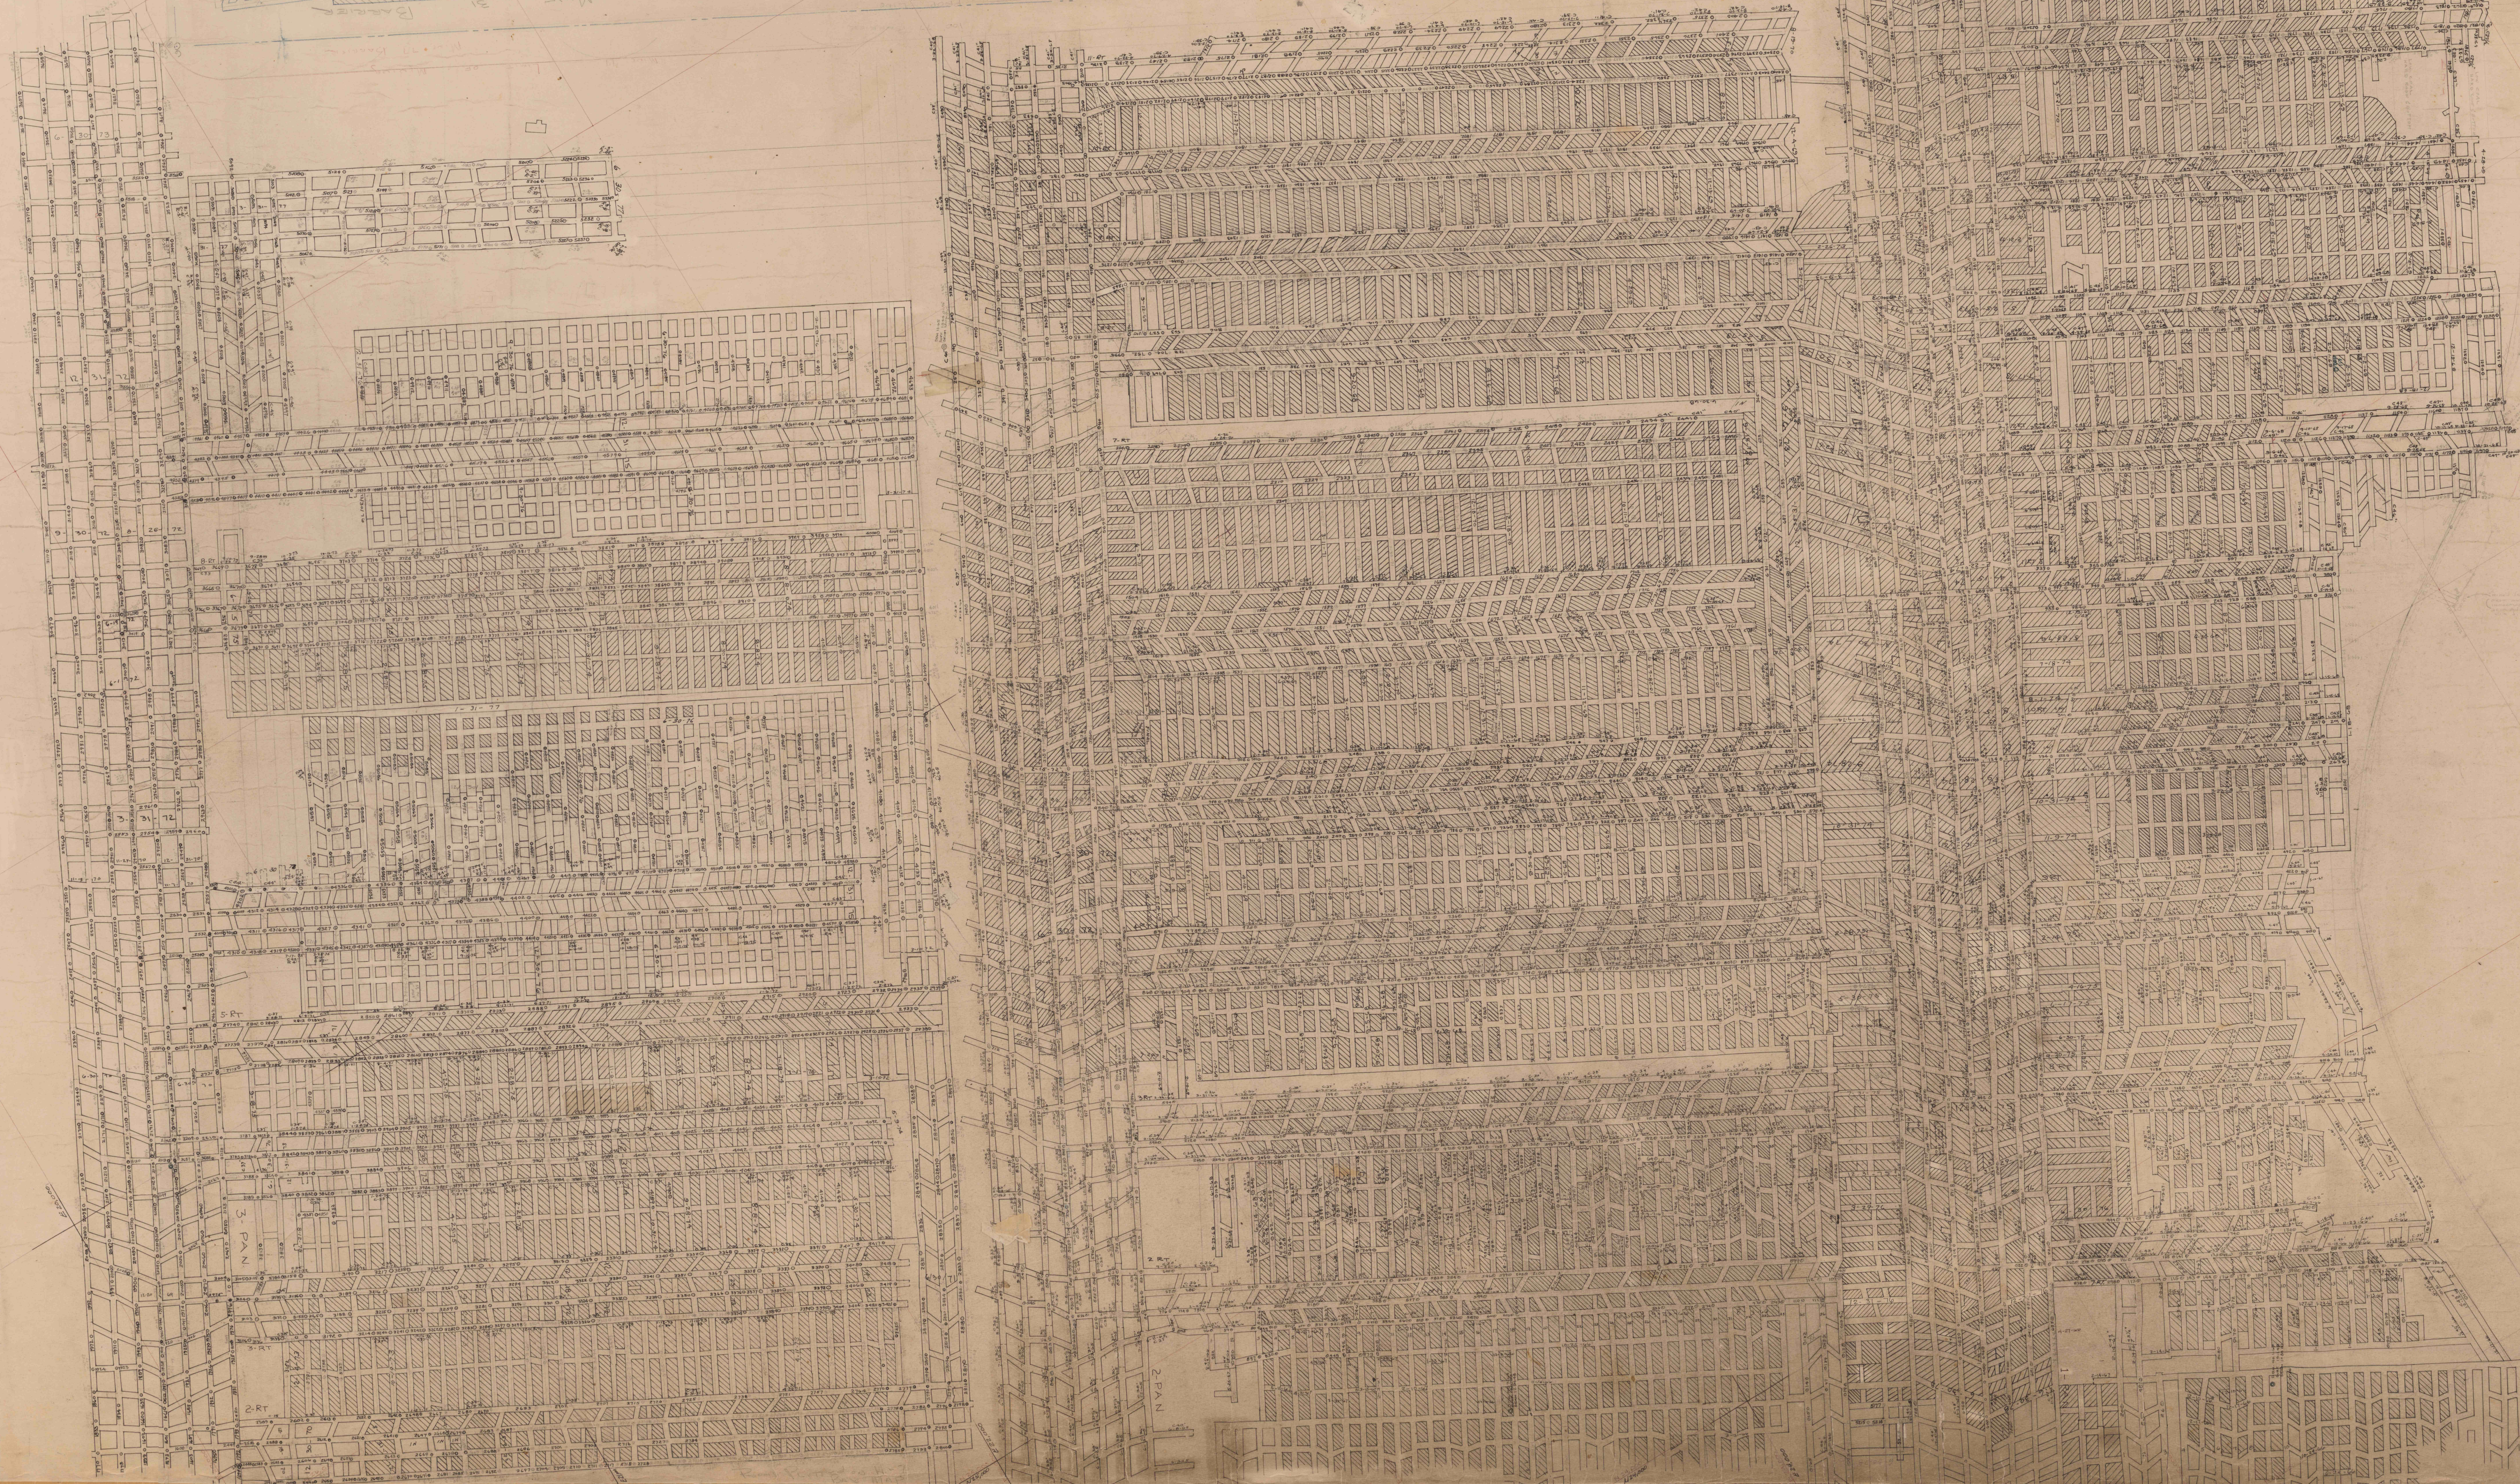

MINE 77
MAP G-6



MINE 77
MAP G-6

MINE 77
MAP G-6