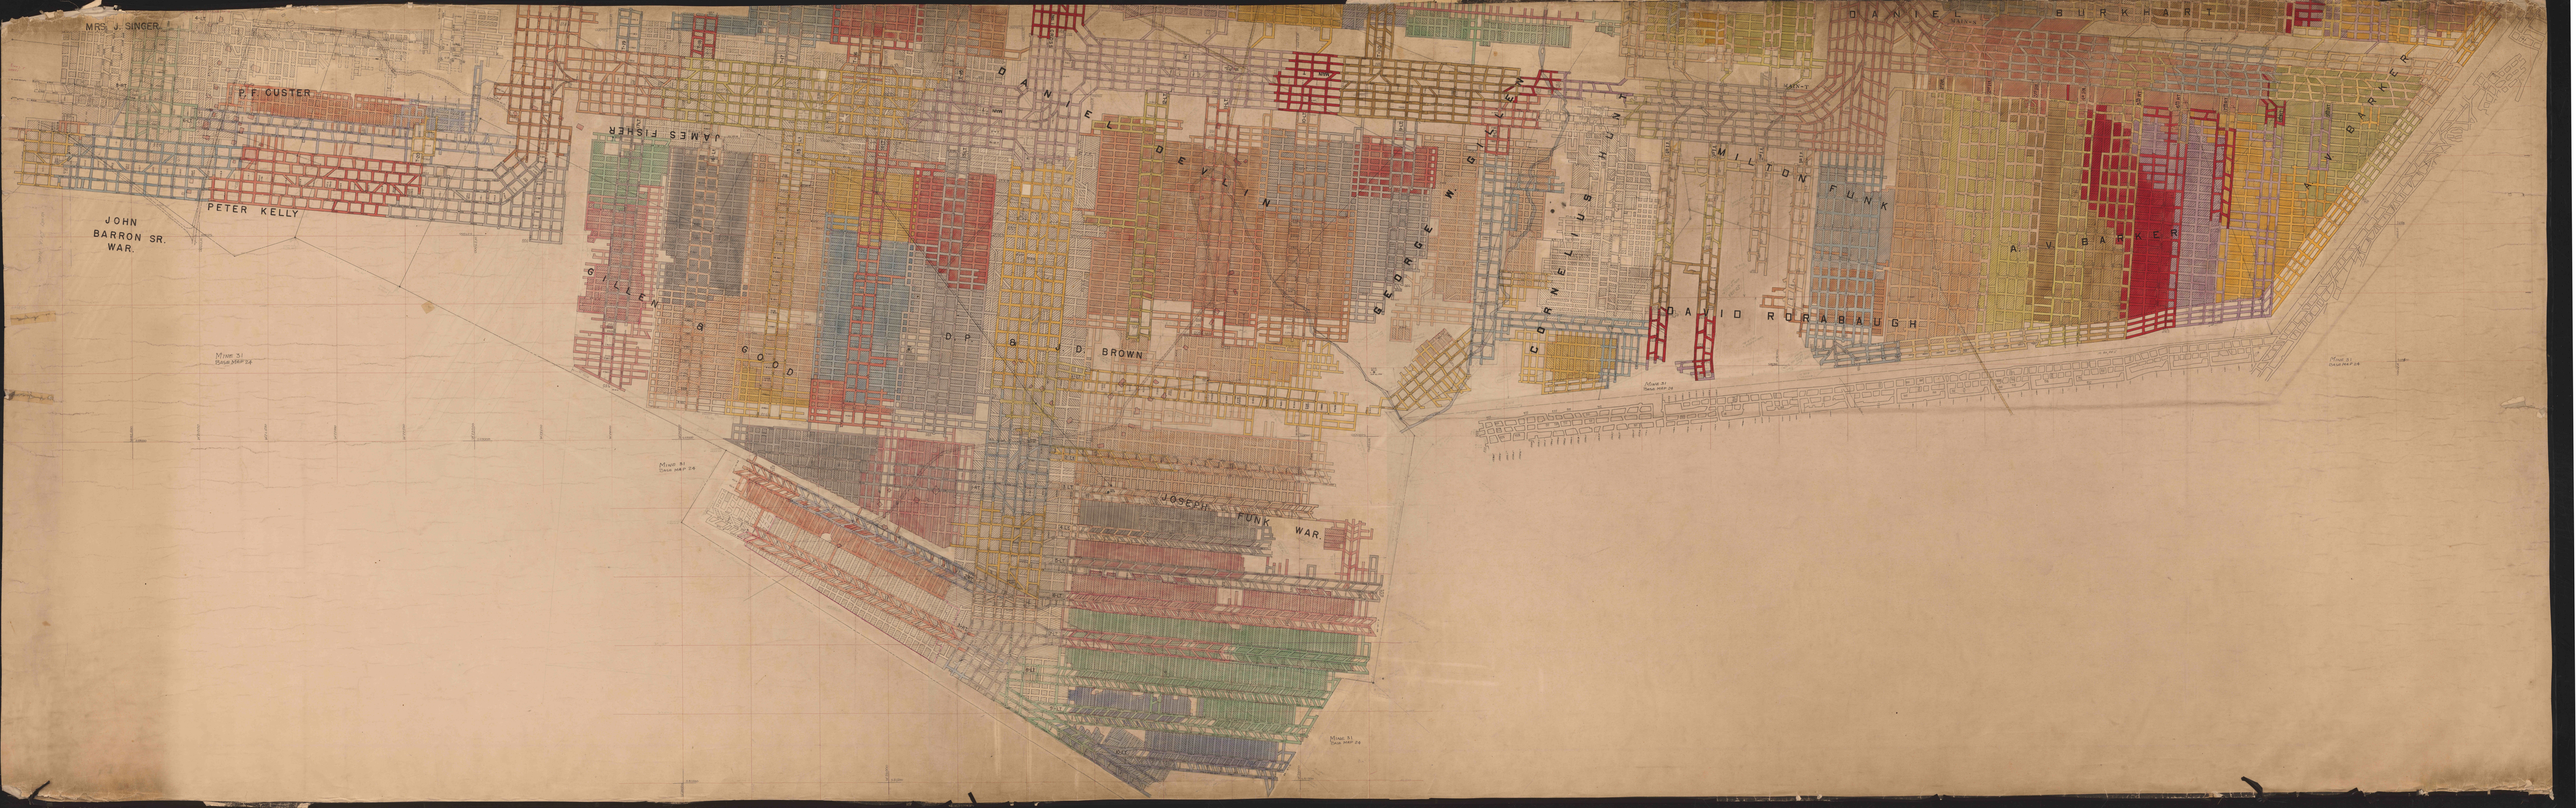

MRS. J. SINGER
P. F. CUSTER
PETER KELLY
JOHN BARRON SR. WAR.
JAMES FISHER
DANIEL DEVLIN
GILLEN & GOOD
D. P. & J. D. BROWN
CORNELIUS HUNT
MILTON FUNK
DAVID RORABAUGH
DANIEL BURKHART
A. V. BAKER
JOSEPH FUNK WAR.