


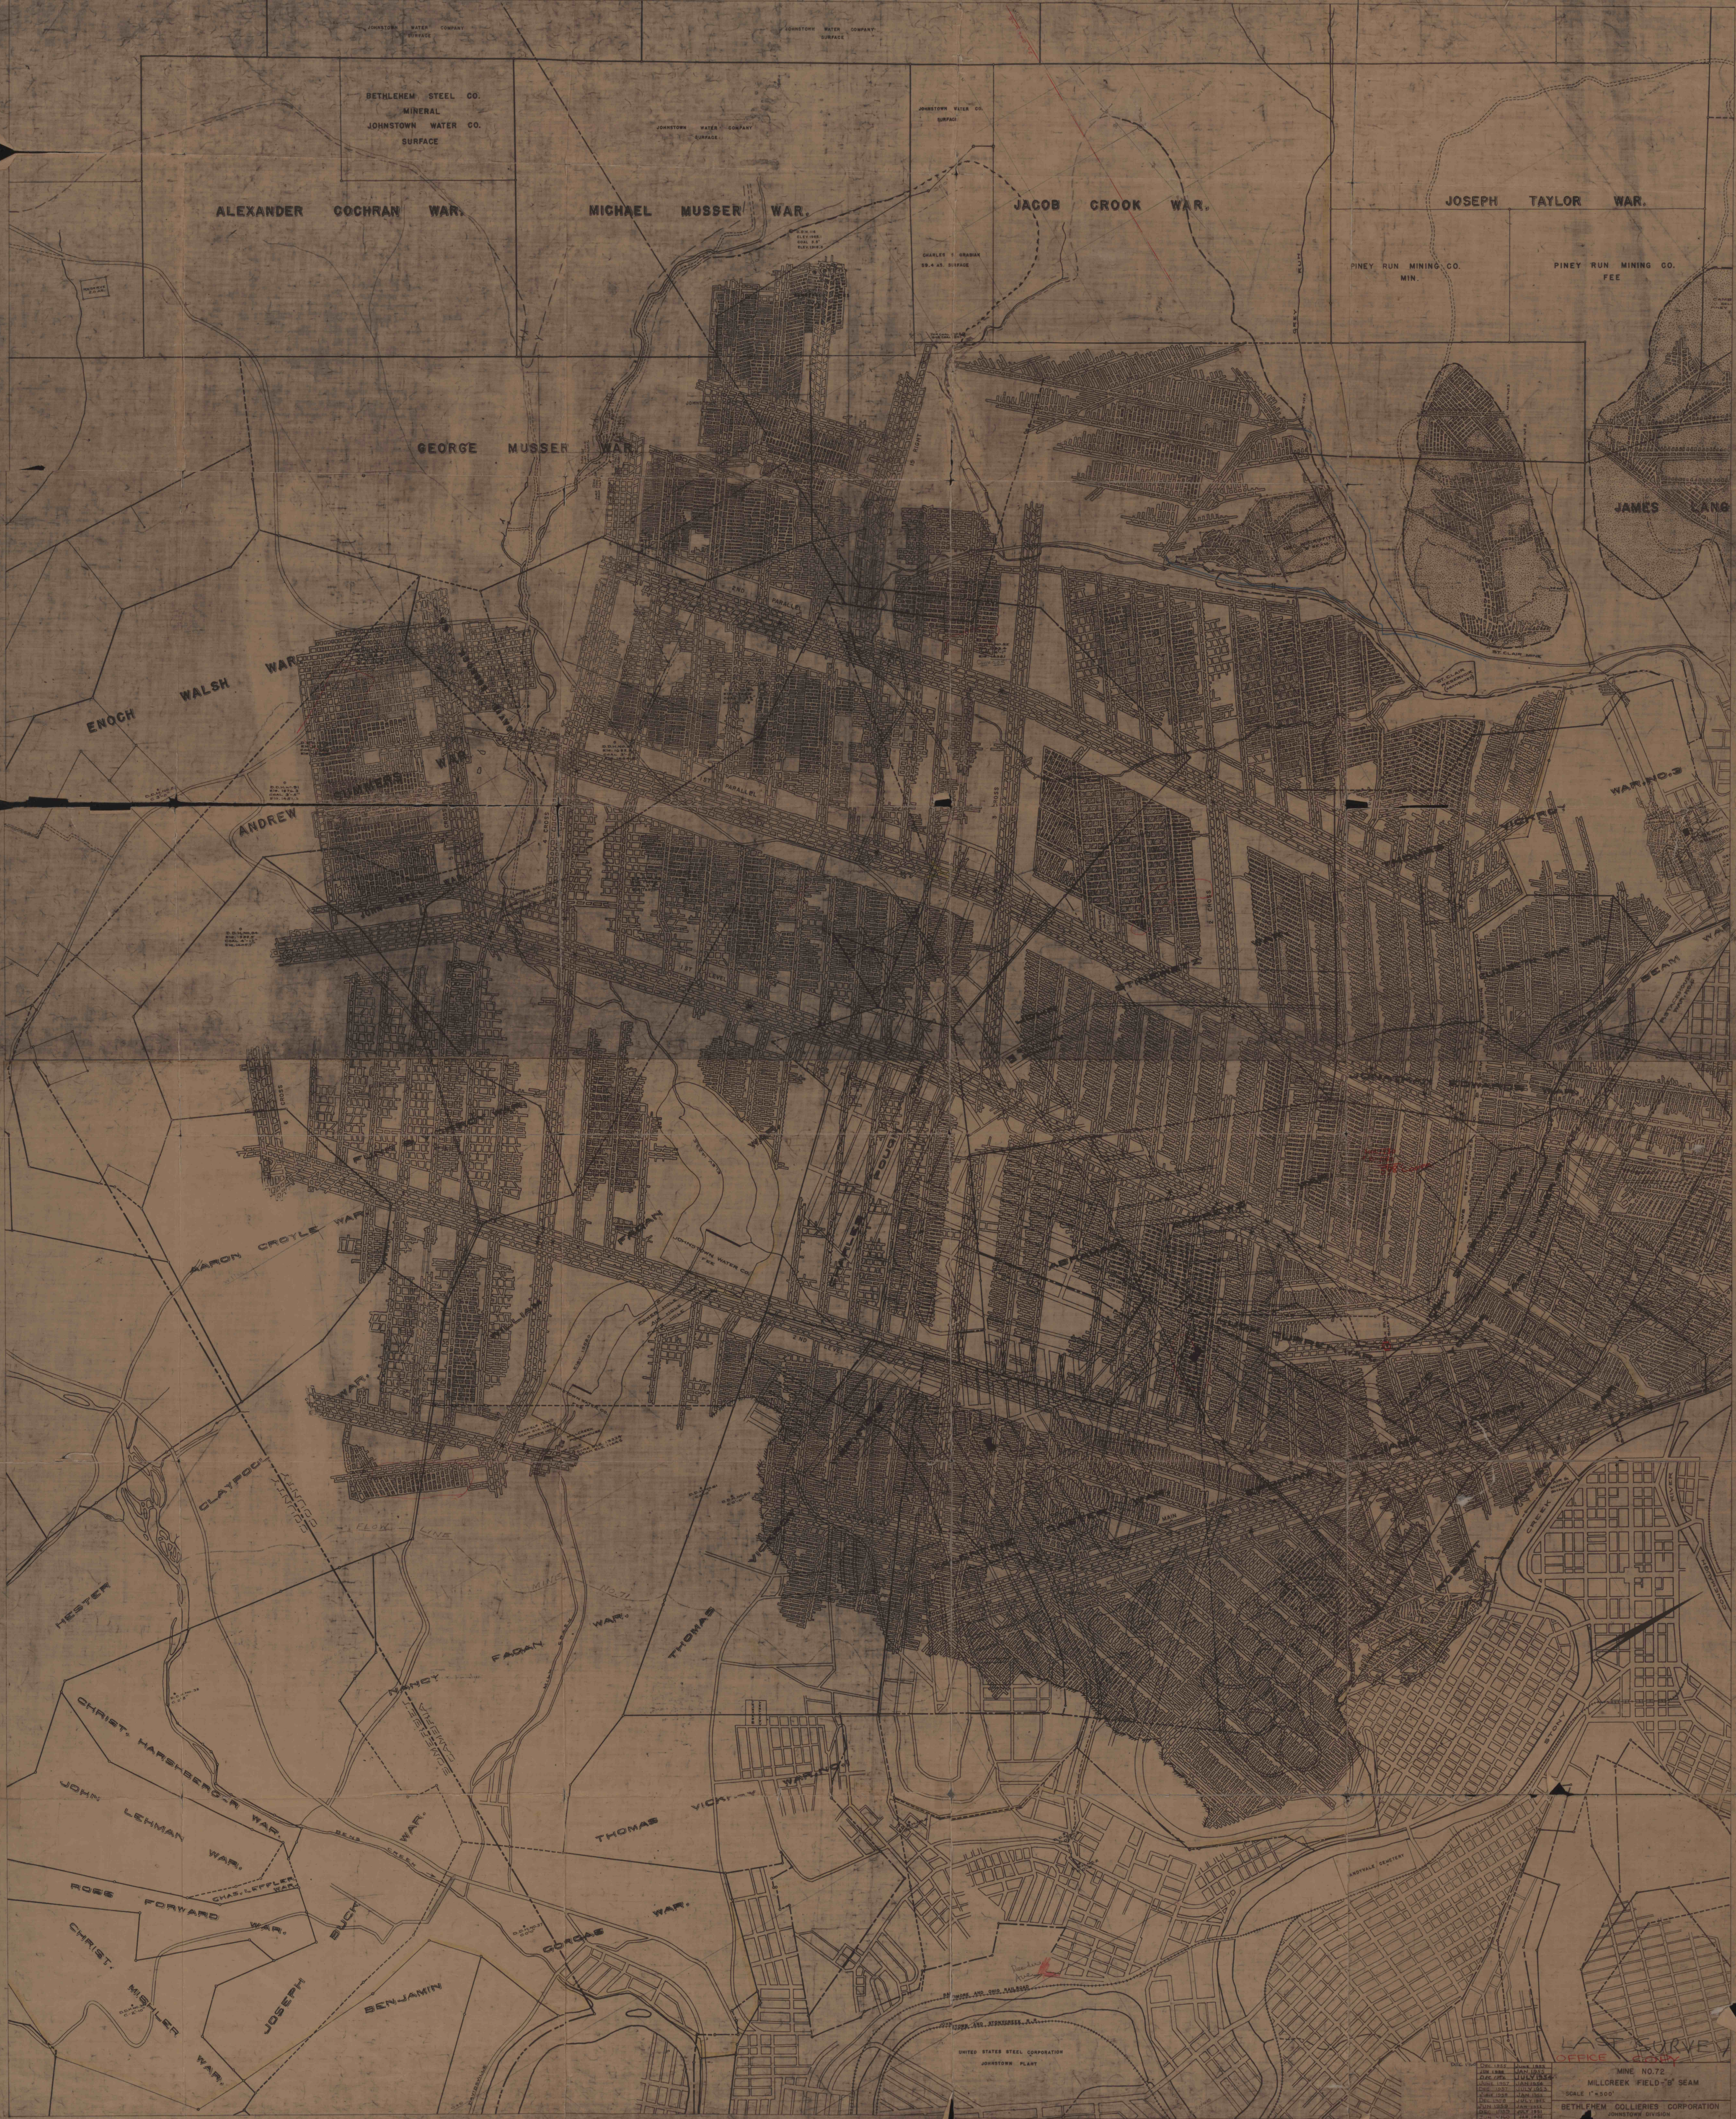

BETHLEHEM STEEL CO.
MINERAL
JOHNSTOWN WATER CO.
SURFACE

JOHNSTOWN WATER COMPANY
SURFACE

JOHNSTOWN WATER CO.
SURFACE

ALEXANDER COCHRAN WAR.

MICHAEL MUSSER WAR.

JACOB CROOK WAR.

JOSEPH TAYLOR WAR.

PINEY RUN MINING CO.
MIN.

PINEY RUN MINING CO.
FEE

GEORGE MUSSER WAR.

ENOCH WALSH WAR.

ANDREW

KARON CROYLE WAR.

CLAYPOOL

HESTER

CHRIST. HAREBERGER WAR.

JOHN LEHMAN WAR.

ROSE FORWARD WAR.

CHRIST. MEHLER WAR.

JOSEPH

BENJAMIN

THOMAS VICK

GORGAS WAR.

UNITED STATES STEEL CORPORATION
JOHNSTOWN PLANT

LAST SURVEY
OFFICE COPY
MINE NO. 72
MILLCREEK FIELD "B" SEAM
SCALE 1"=500'
BETHLEHEM COLLIERIES CORPORATION
JOHNSTOWN, PENNSYLVANIA