


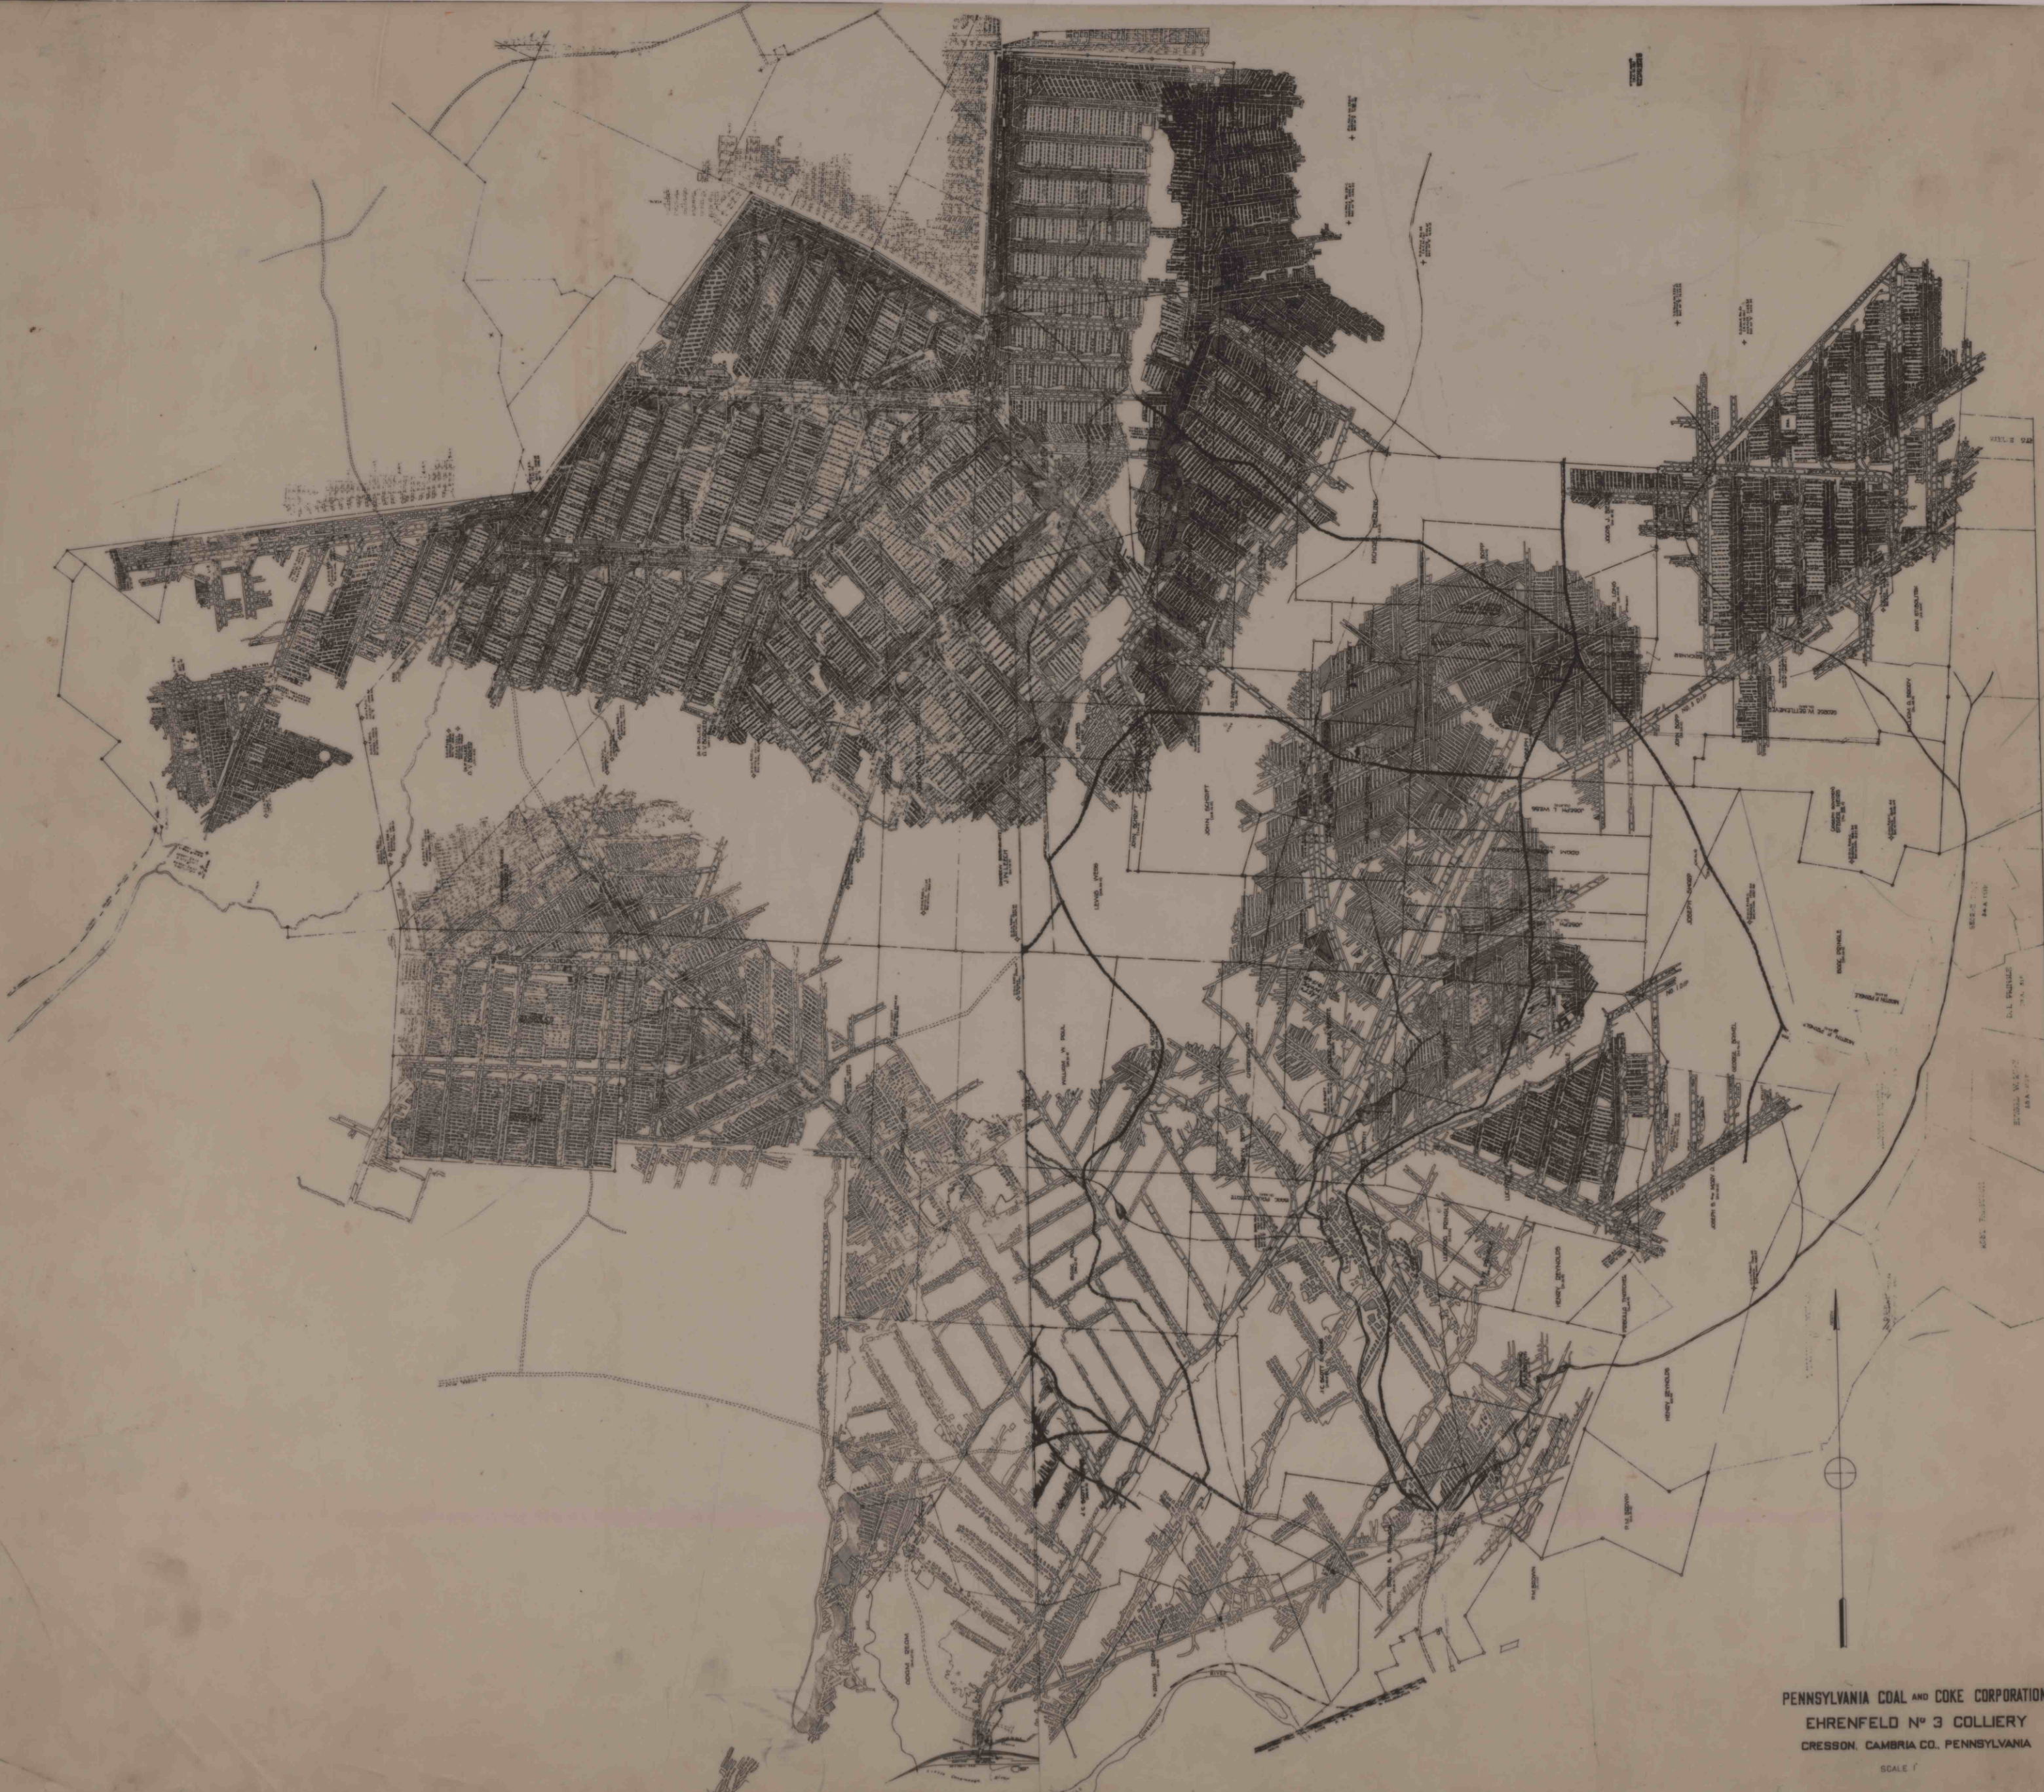

PENNSYLVANIA COAL AND COKE CORPORATION
EHRENFELD N° 3 COLLIERY
CRESSON, CAMBRIA CO., PENNSYLVANIA

SCALE 1"