


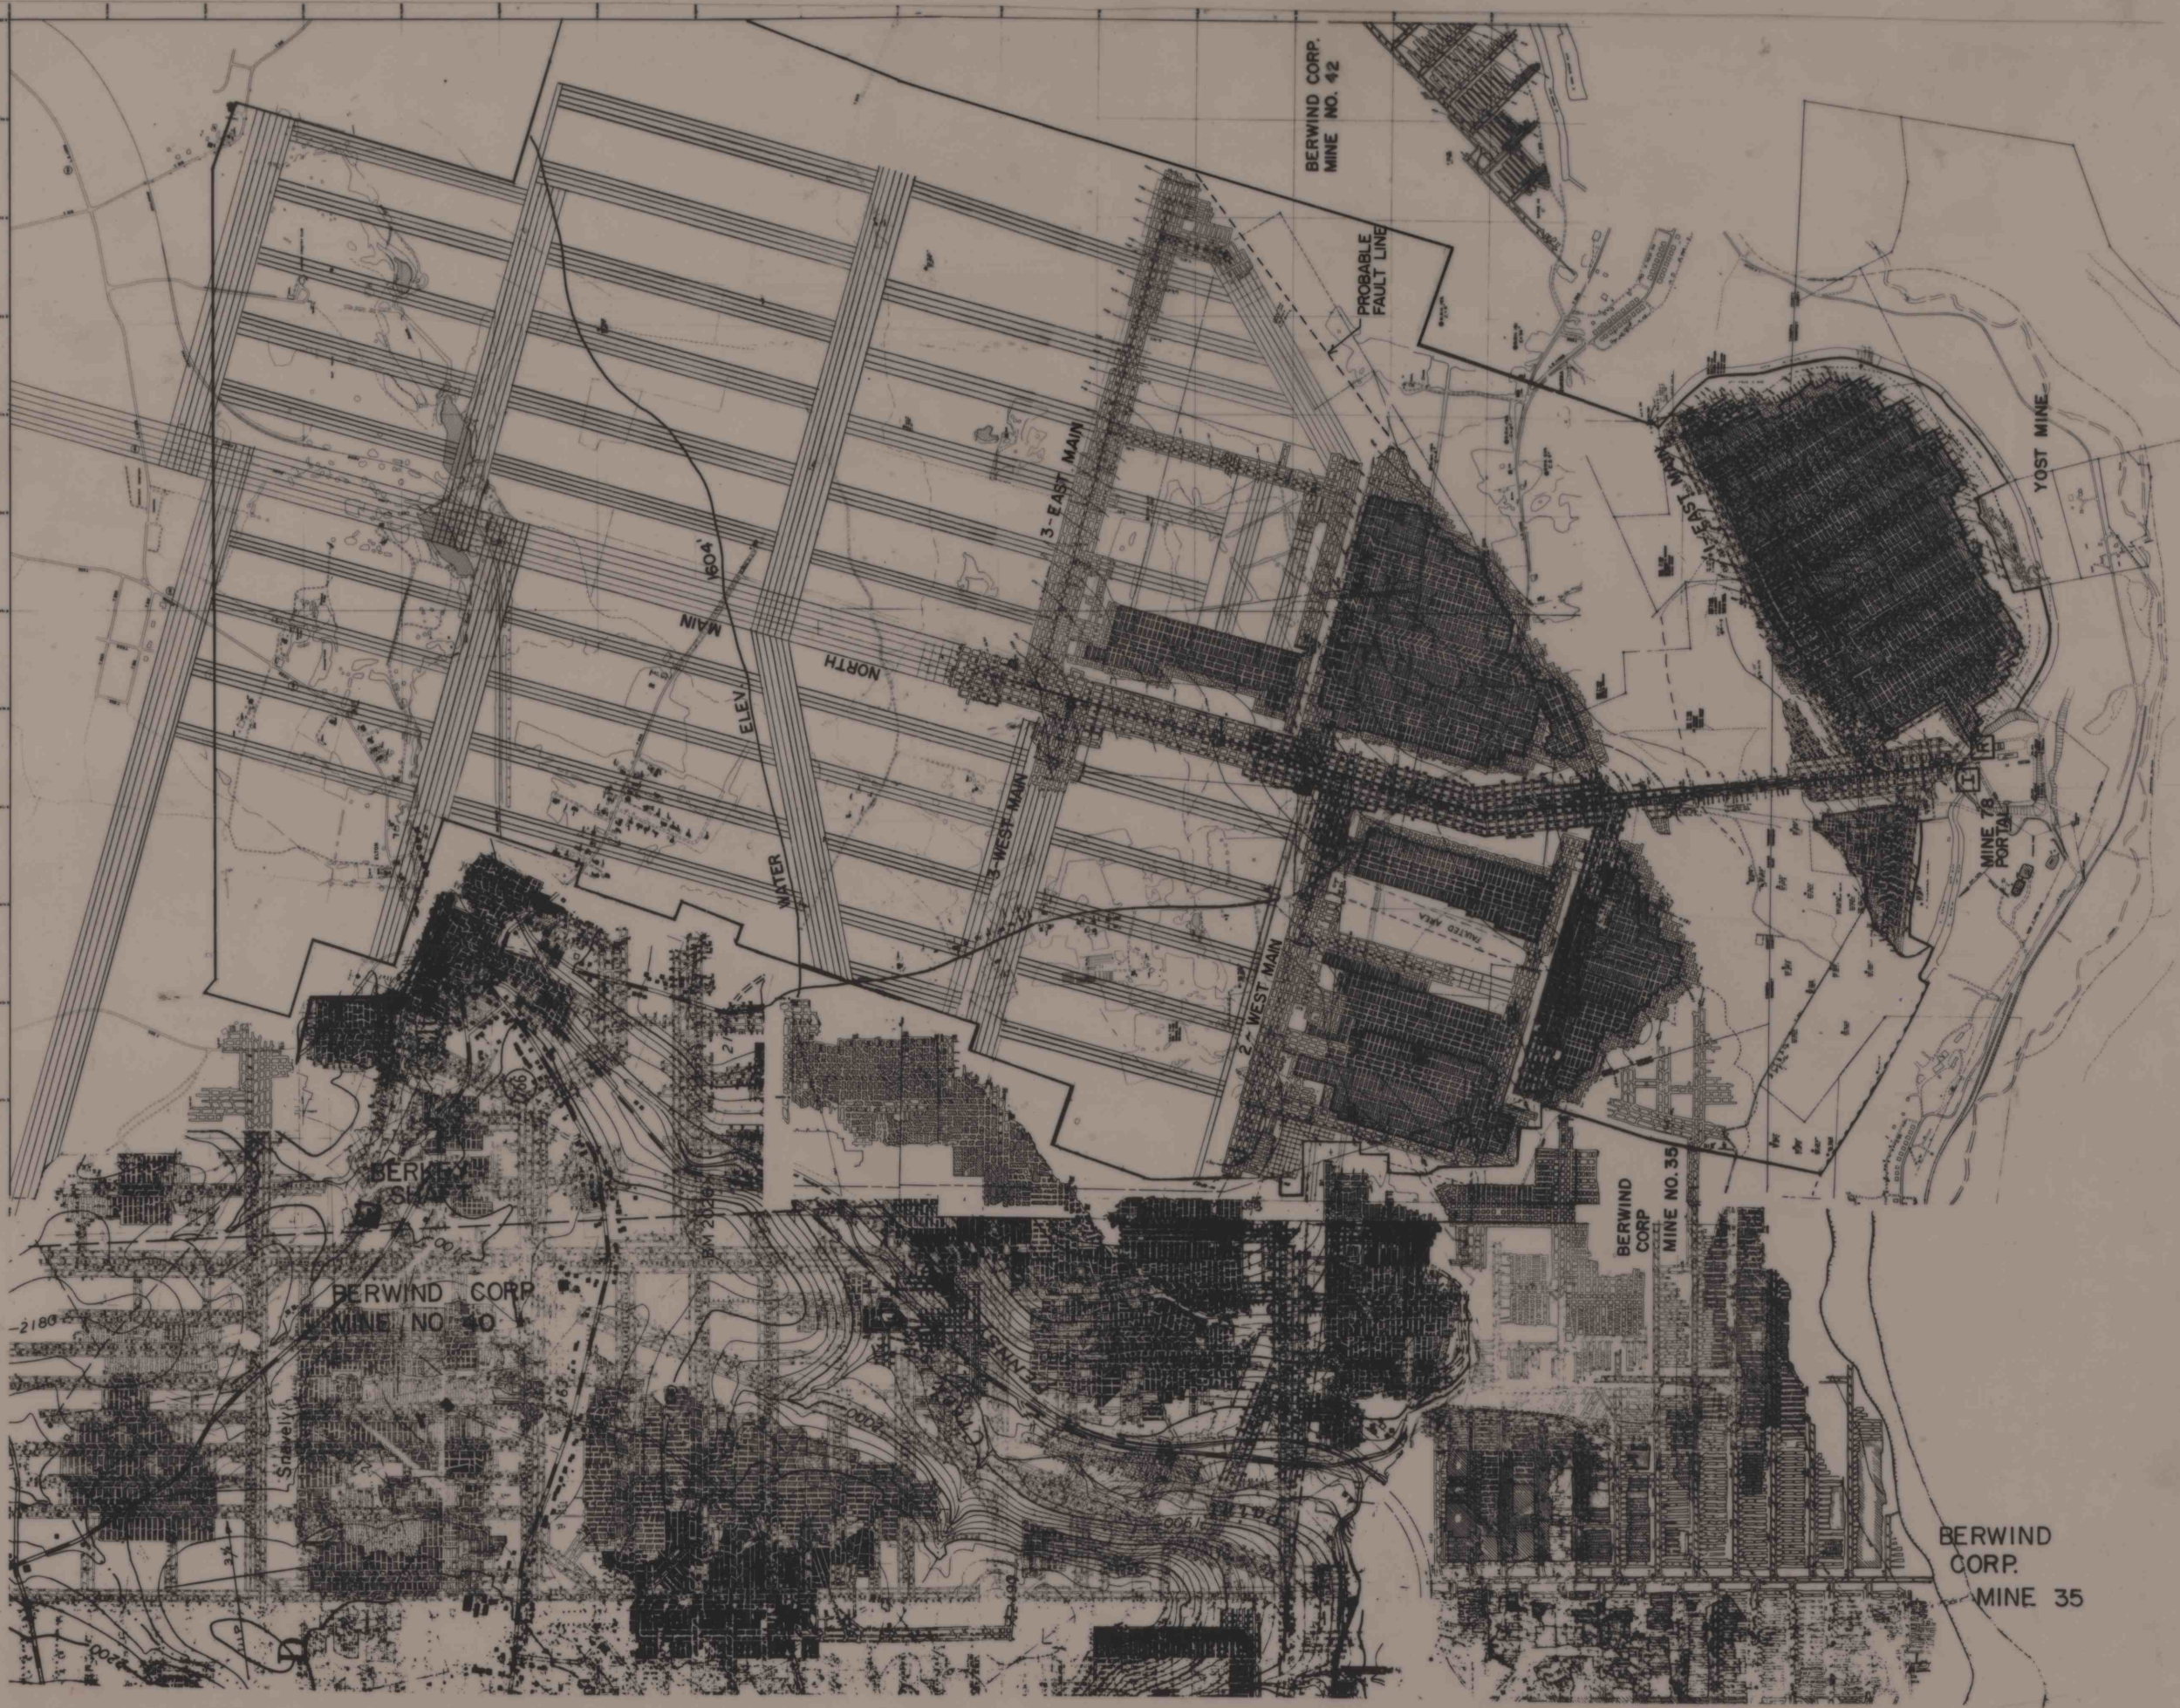

BETHENERGY MINES INC.
EBENSBURG, PA.
MINE NO. 78
UPPER KITTANNING SEAM
SCALE: 1"=1000' DATE: 12-15-87