


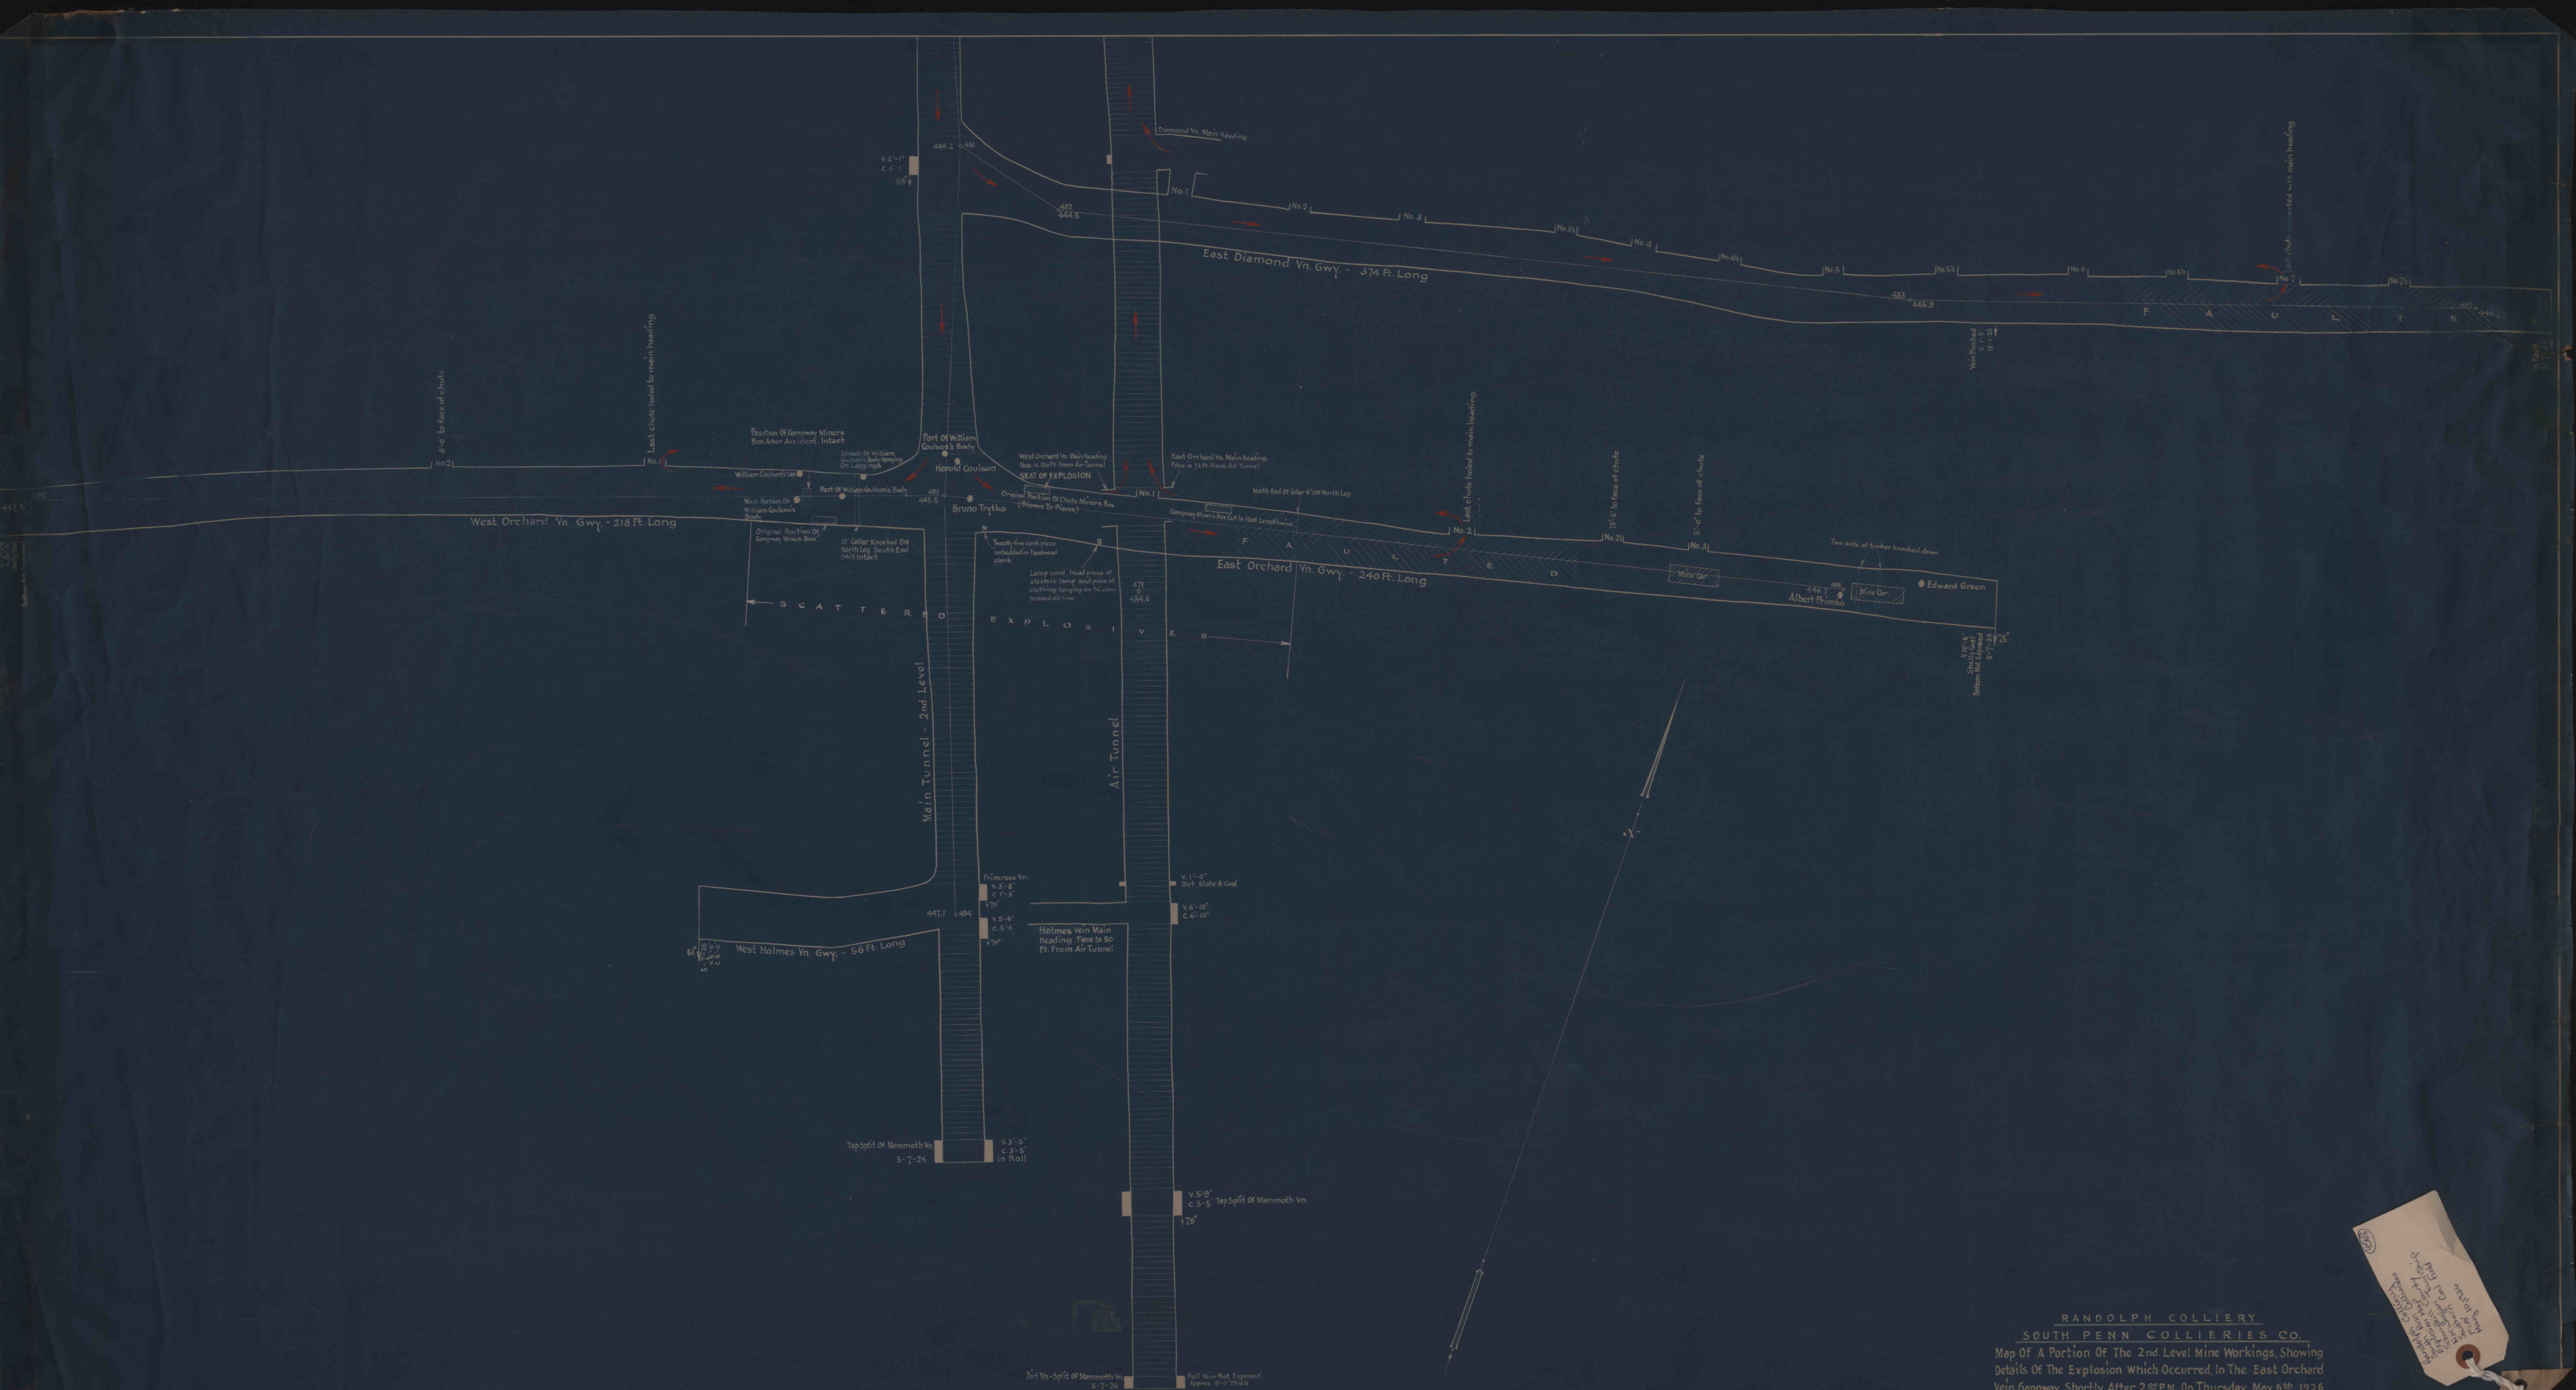

RANDOLPH COLLIERY  
SOUTH PENN. COLLIERIES CO.  
Map of A Portion of The 2nd Level Mine Workings, Showing  
Details of The Explosion Which Occurred, in The East Orchard  
Vn. Gangway, Shortly After 2:30 P.M. on Thursday, May 6th, 1926  
Scale 1" = 10'  
May 10th, 1926  
S. P. C. Co. Engr. Dept.

Original map  
for Randolph Colliery  
Co. showing details  
of explosion in  
East Orchard Vn.  
Gangway, May 6th,  
