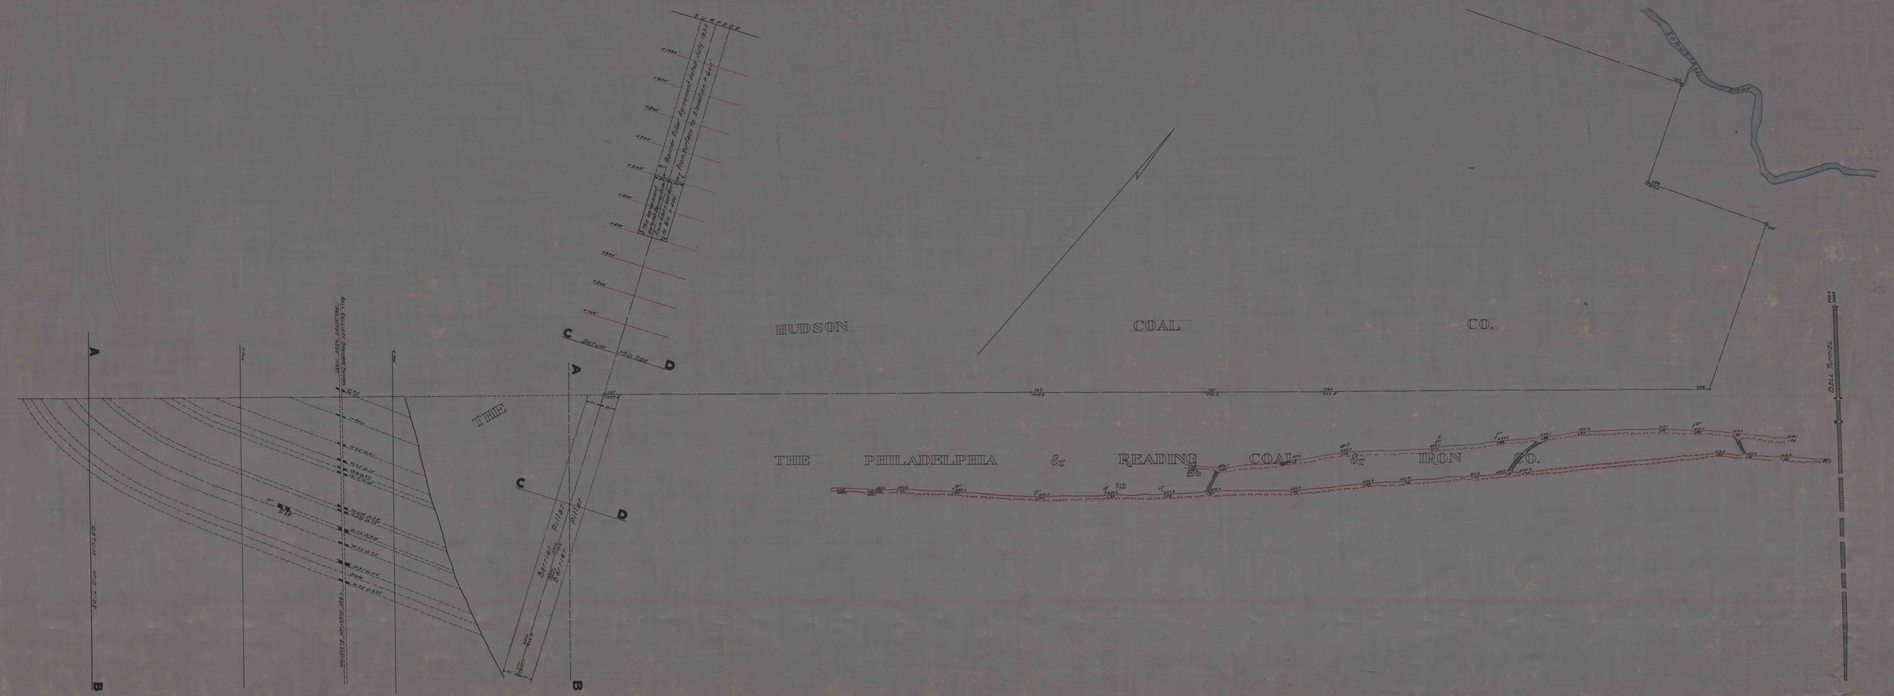
HUDSON COAL CO.
THE PHILADELPHIA & READING COAL & IRON CO.
A
B
C
D
Barrier Pillar
Pillar
Pillar