


SECTION

Showing L.V. Vein 600 ft West of Bear Gap Tunnel

Looking East

Scale 200' = 1"

Jan '33.

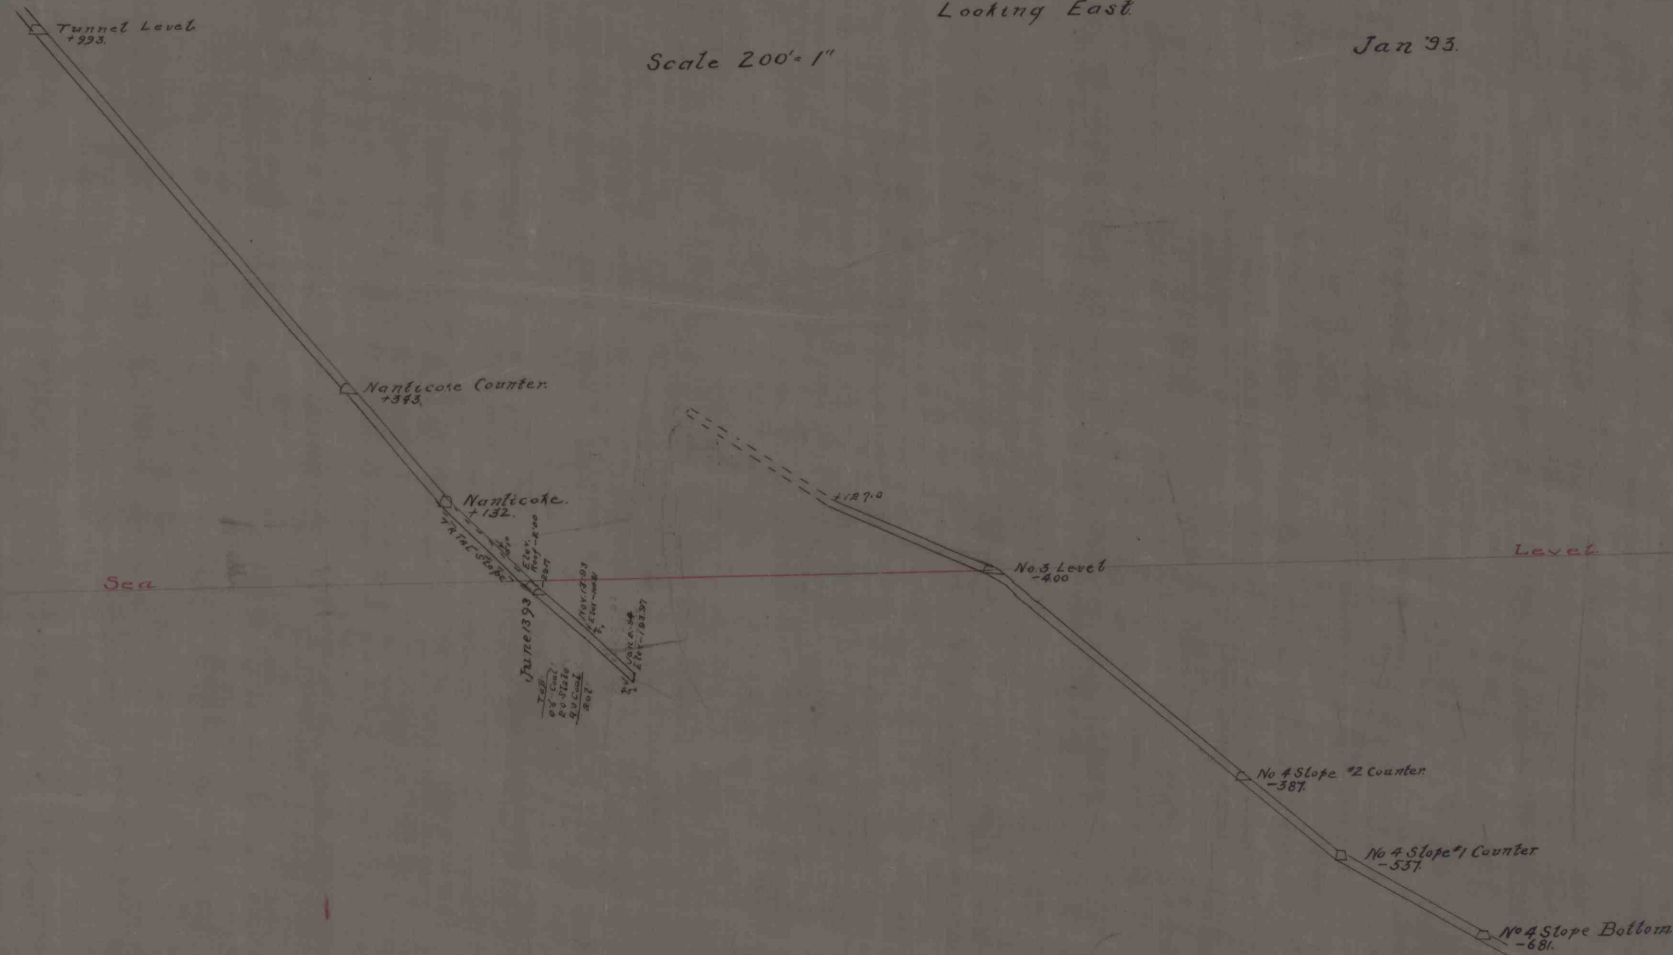

Wms Town Coll'y.
BEAR GAP SECTNS
2 OF 5.

JUN 9 1972
MF

SOUTHERN COAL FIELD.. WICONISCO TWP.,
DAUPHIN COUNTY PA.. 17 LYKENS VALLEY DIST.,
SUSQUEHANNA COLL'RS CO.,