


- TOP ROSS - EASTERN SECTION -

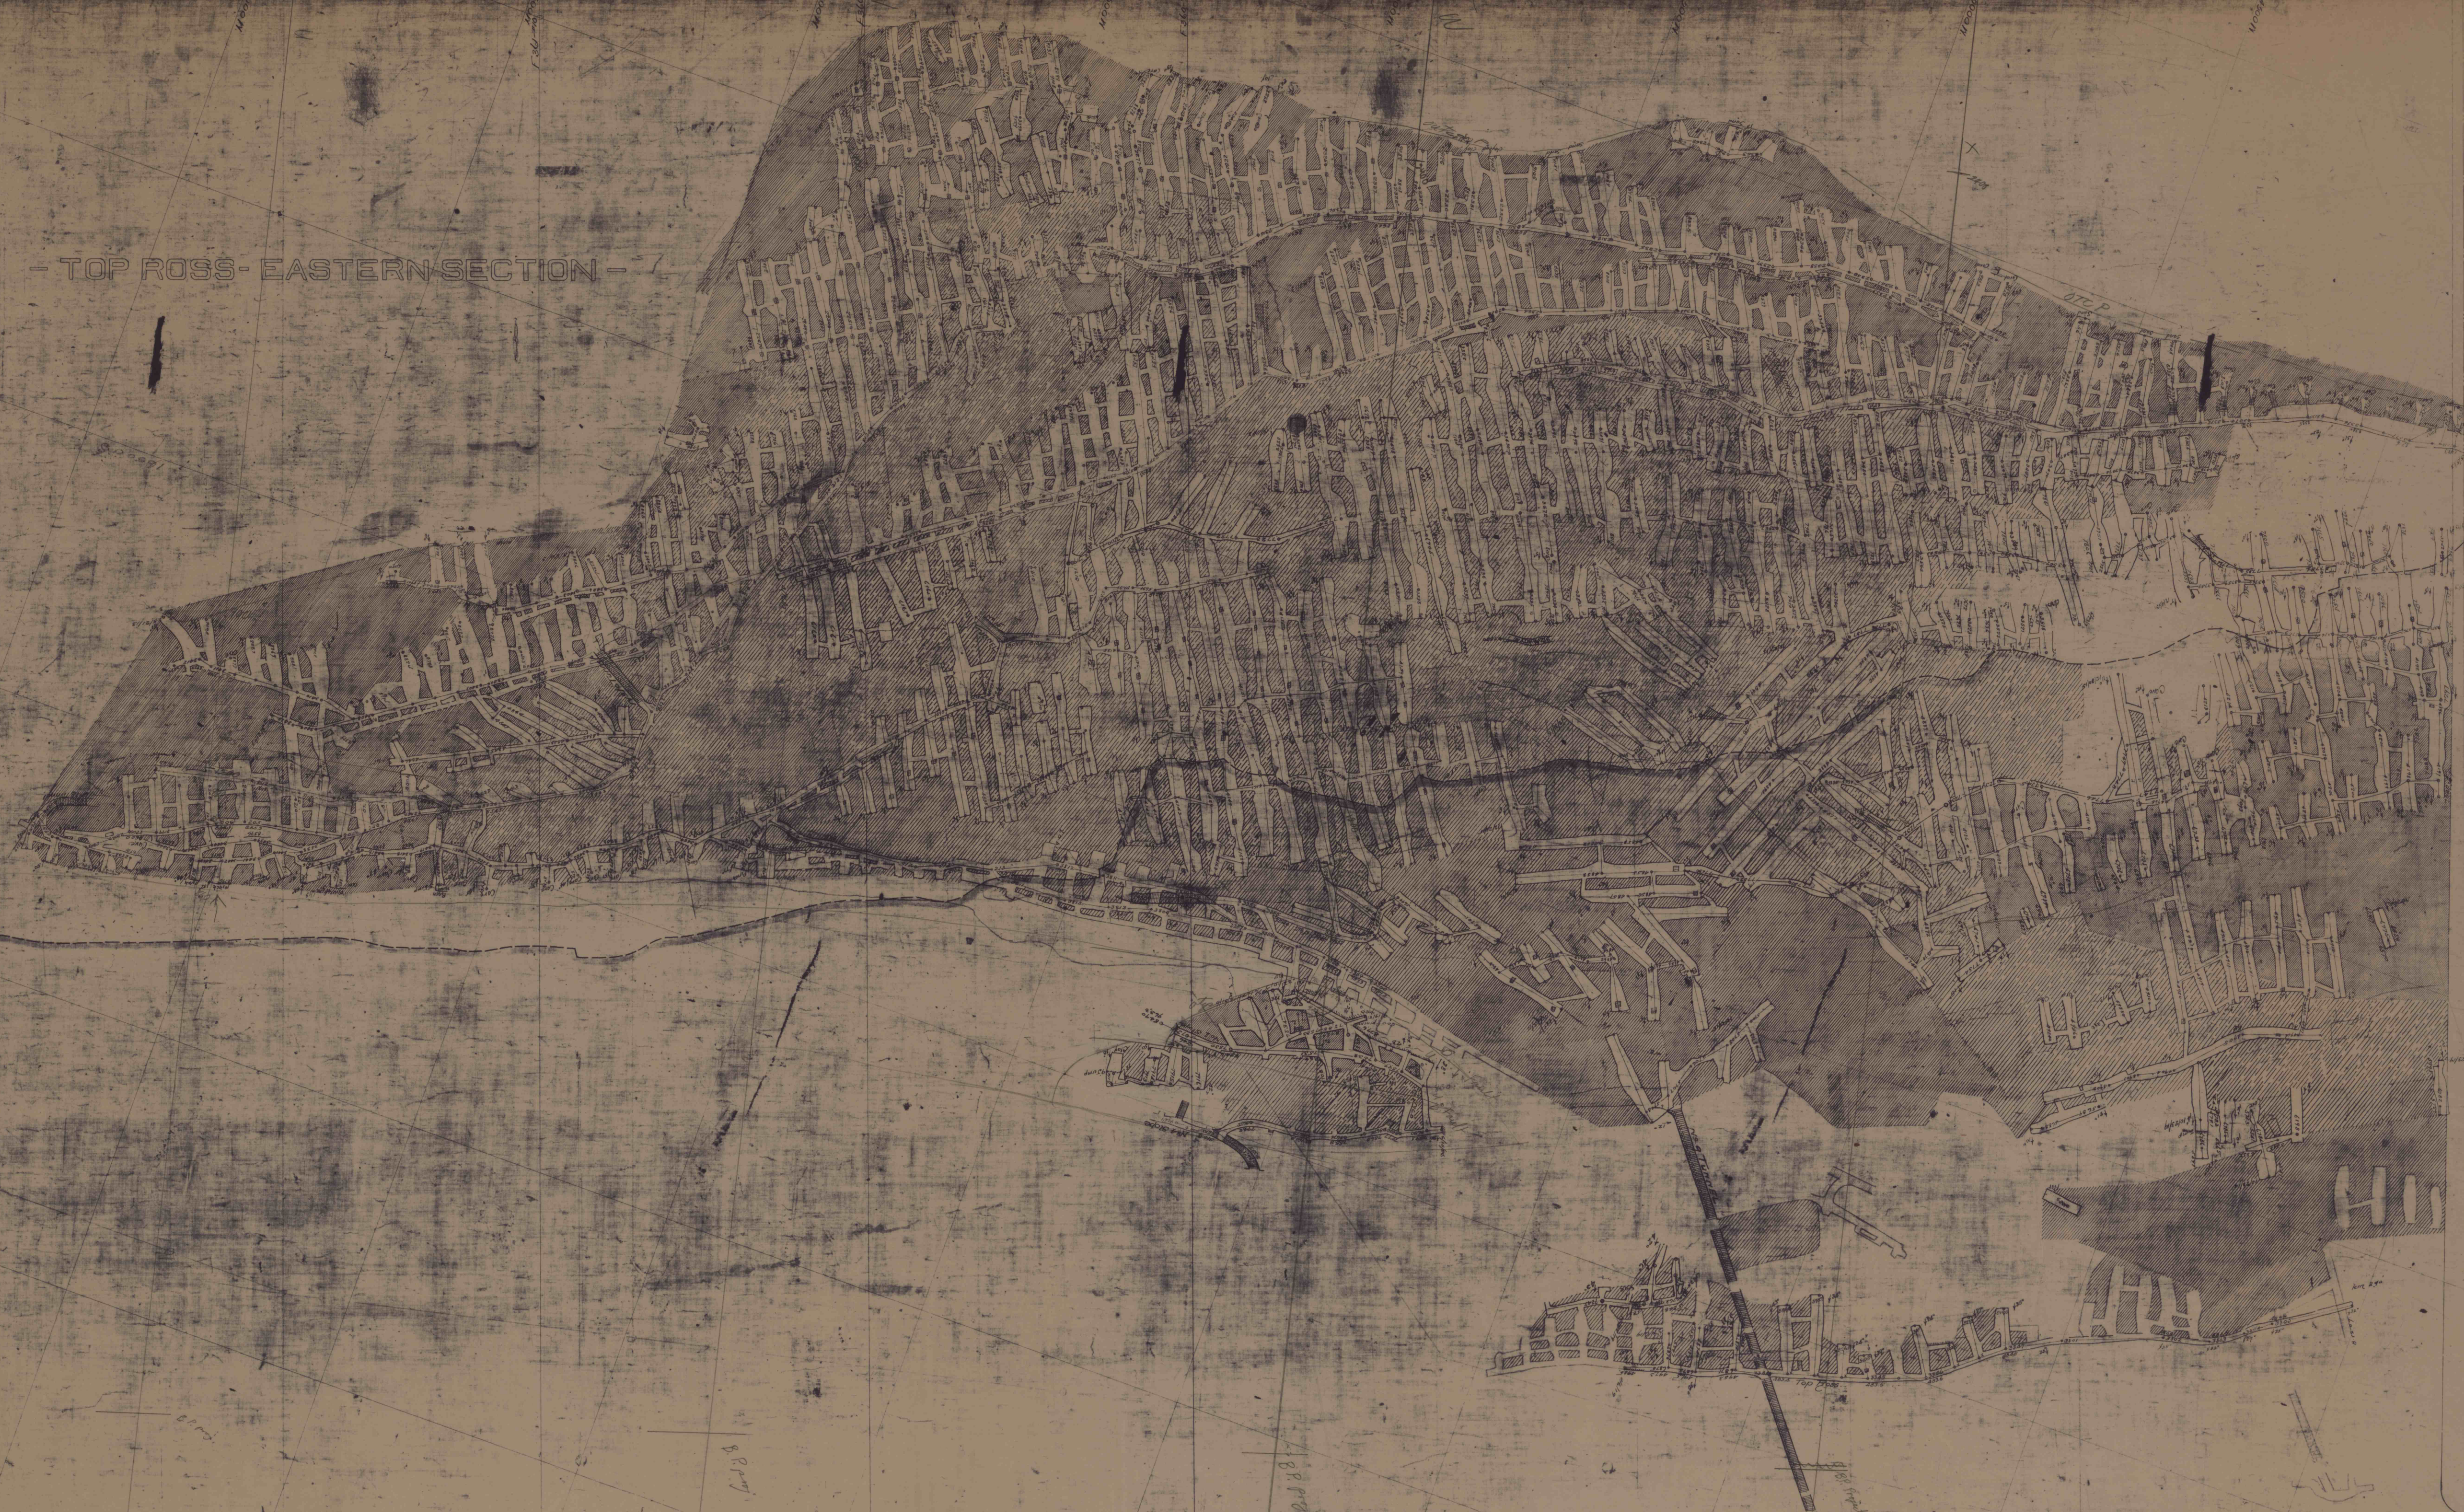

11-1-32

11-1-32

11-1-32

11-1-32