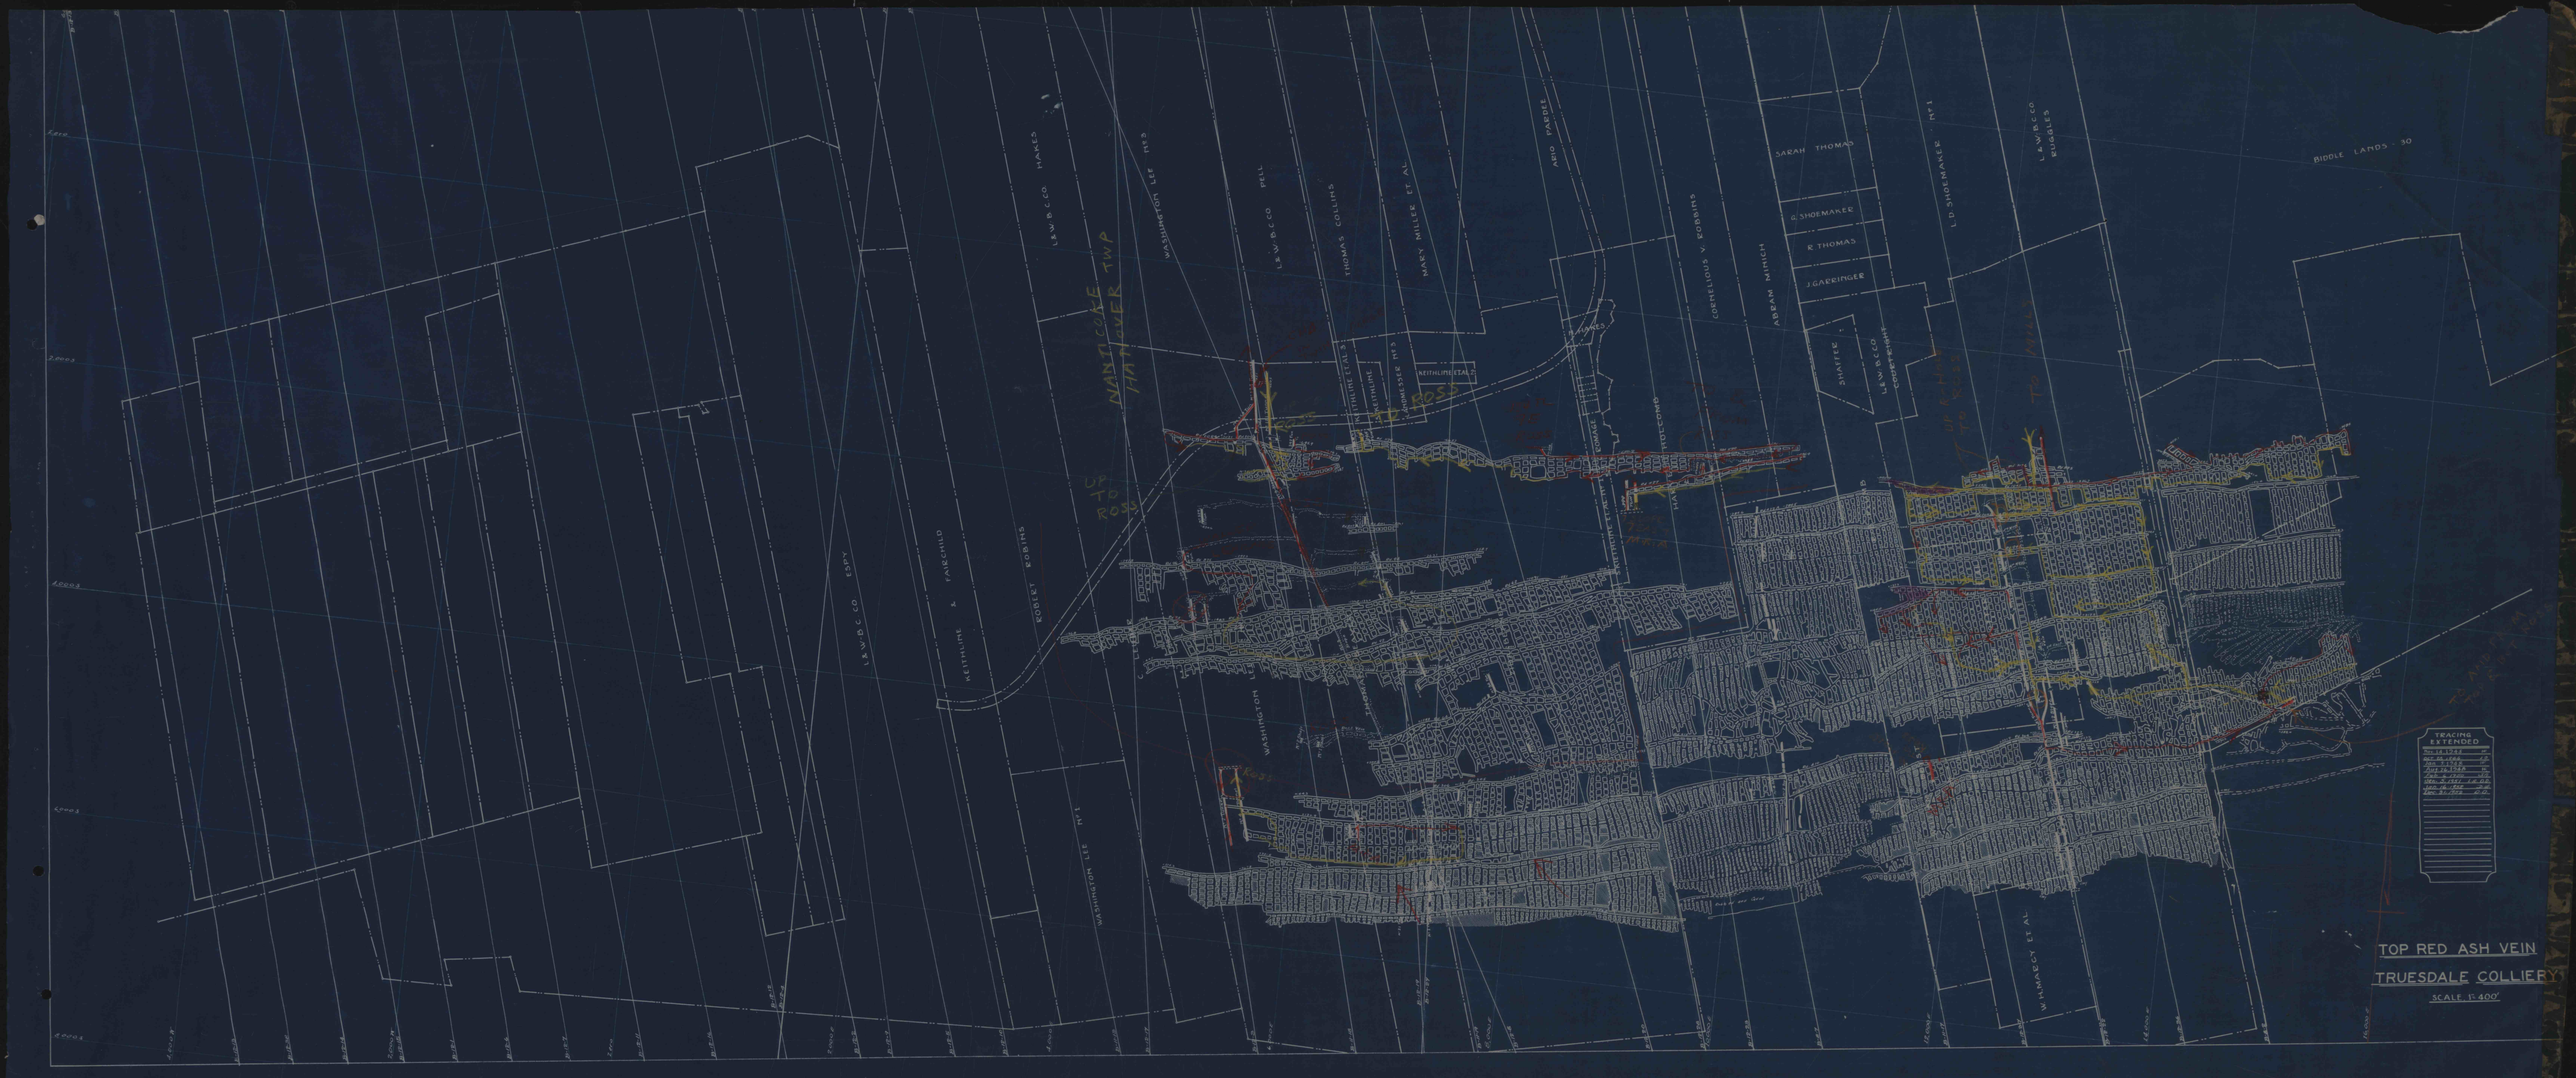
L & W B C CO HAKES
WASHINGTON LEE NO 3
L & W B C CO PELL
THOMAS COLLINS
MARY HILLER ET AL
ARIO PARDEE
CORNELIUS V ROBBINS
ABRAM MITCH
SARAH THOMAS
R SHOEMAKER
R THOMAS
J GAERINGER
L D SHOEMAKER No 1
L & W B C CO RUGGLES
BIDDLE LANDS 30
MEITHLINE & FAIRCHILD
ROBERT ROBINS
WASHINGTON LEE No 1
UP TO ROSS
MEITHLINE ETAL
MEITHLITE ETAL
TRACING EXTENDED
TOP RED ASH VEIN
TRUESDALE COLLIERY
SCALE 1:400'