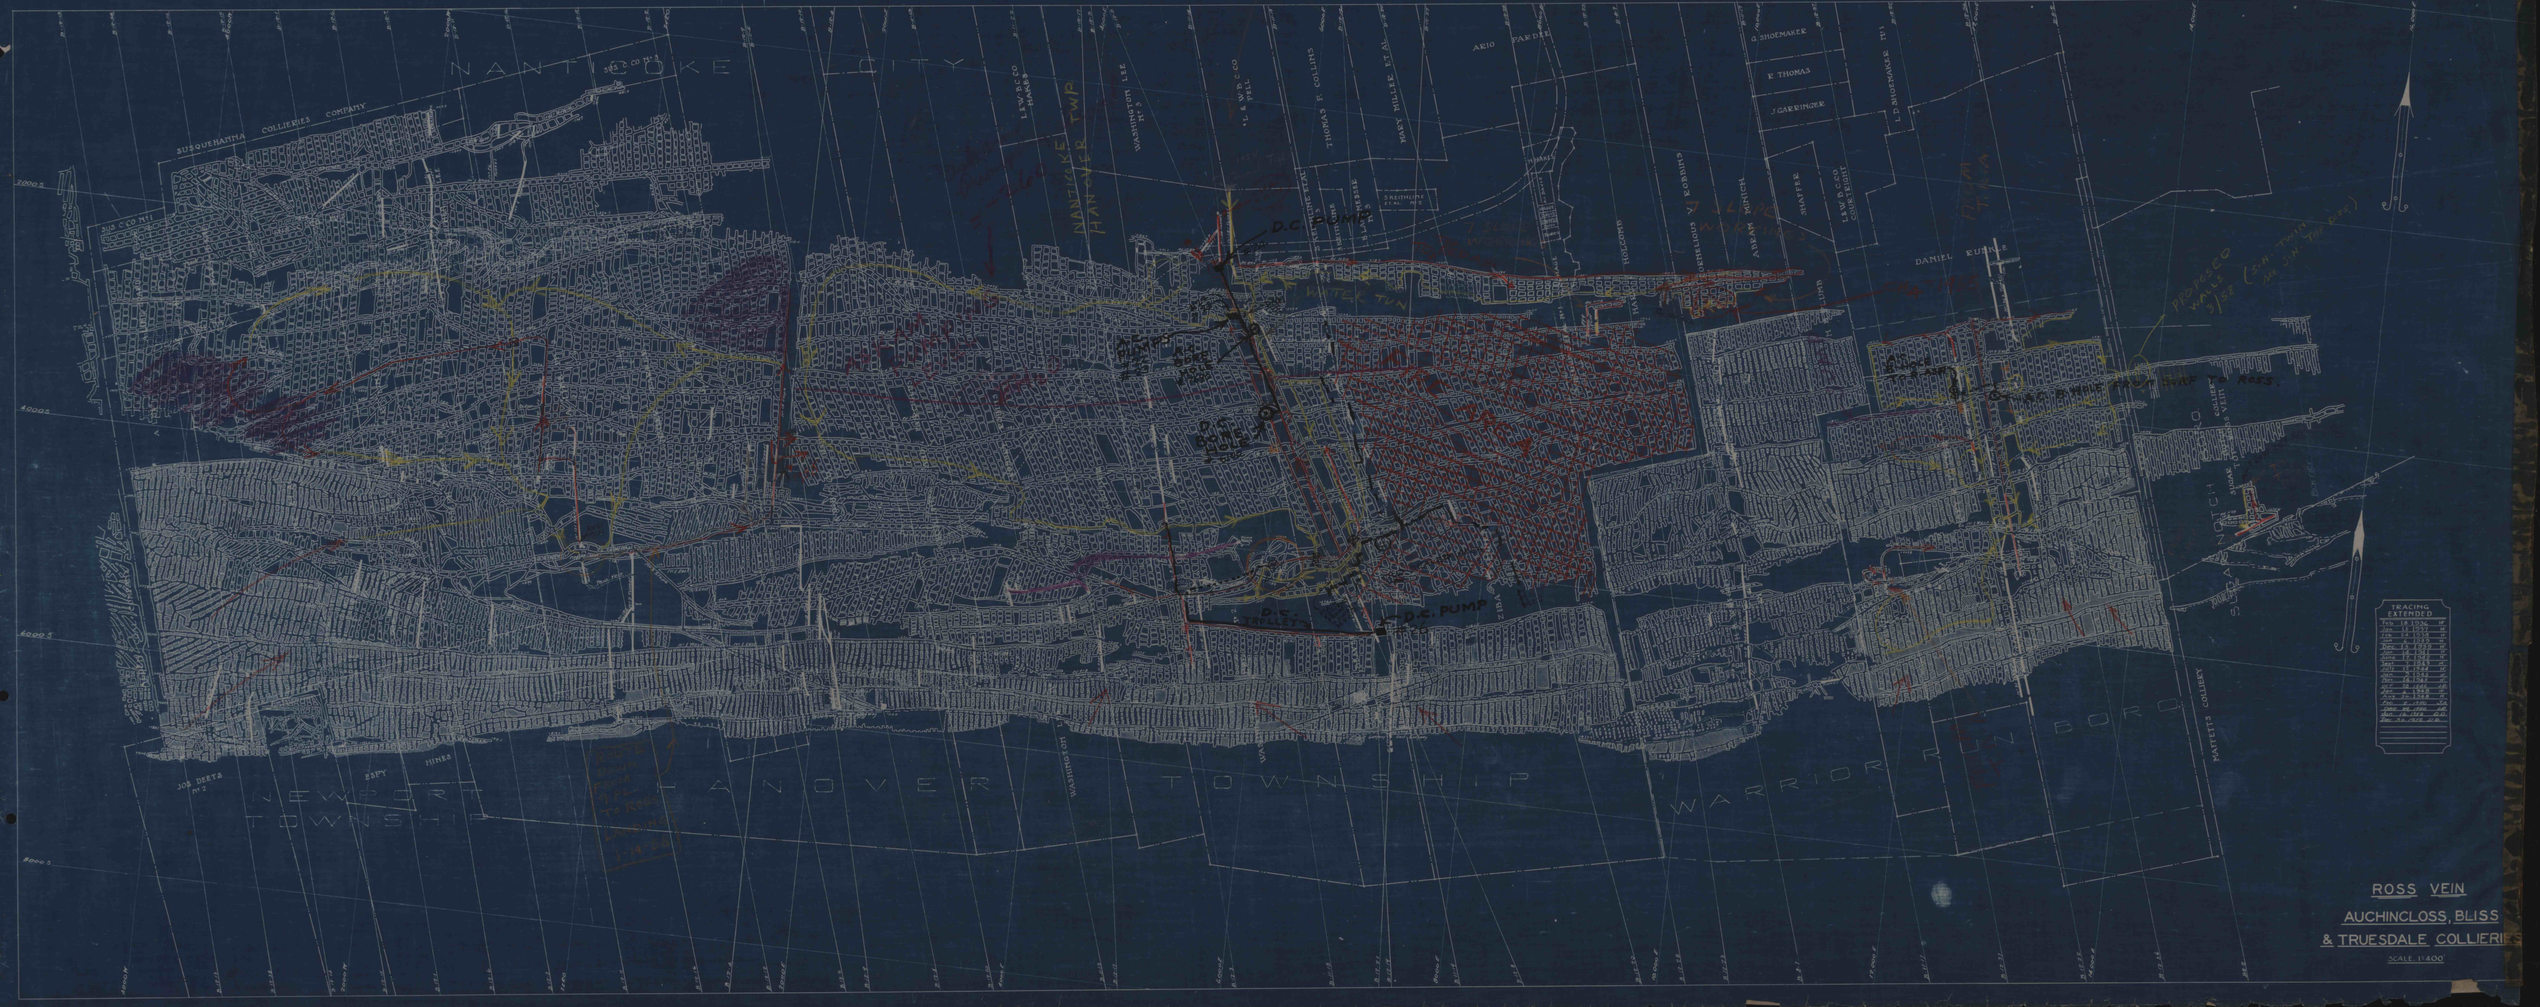
NANTICOKE CITY
SUSQUEHANNA COLLIERIES COMPANY
NANTICOKE TWP
HANOVER TWP
D.C. PUMP
D.C. PUMP
D.C. PUM