


NOTE TO GET
FROM SHAPE TO
AUG PUMPS IN 200
SEE INSTAL. PRINT
ON MILLS W.P.

TO MILL
TO MILL
TO MILL

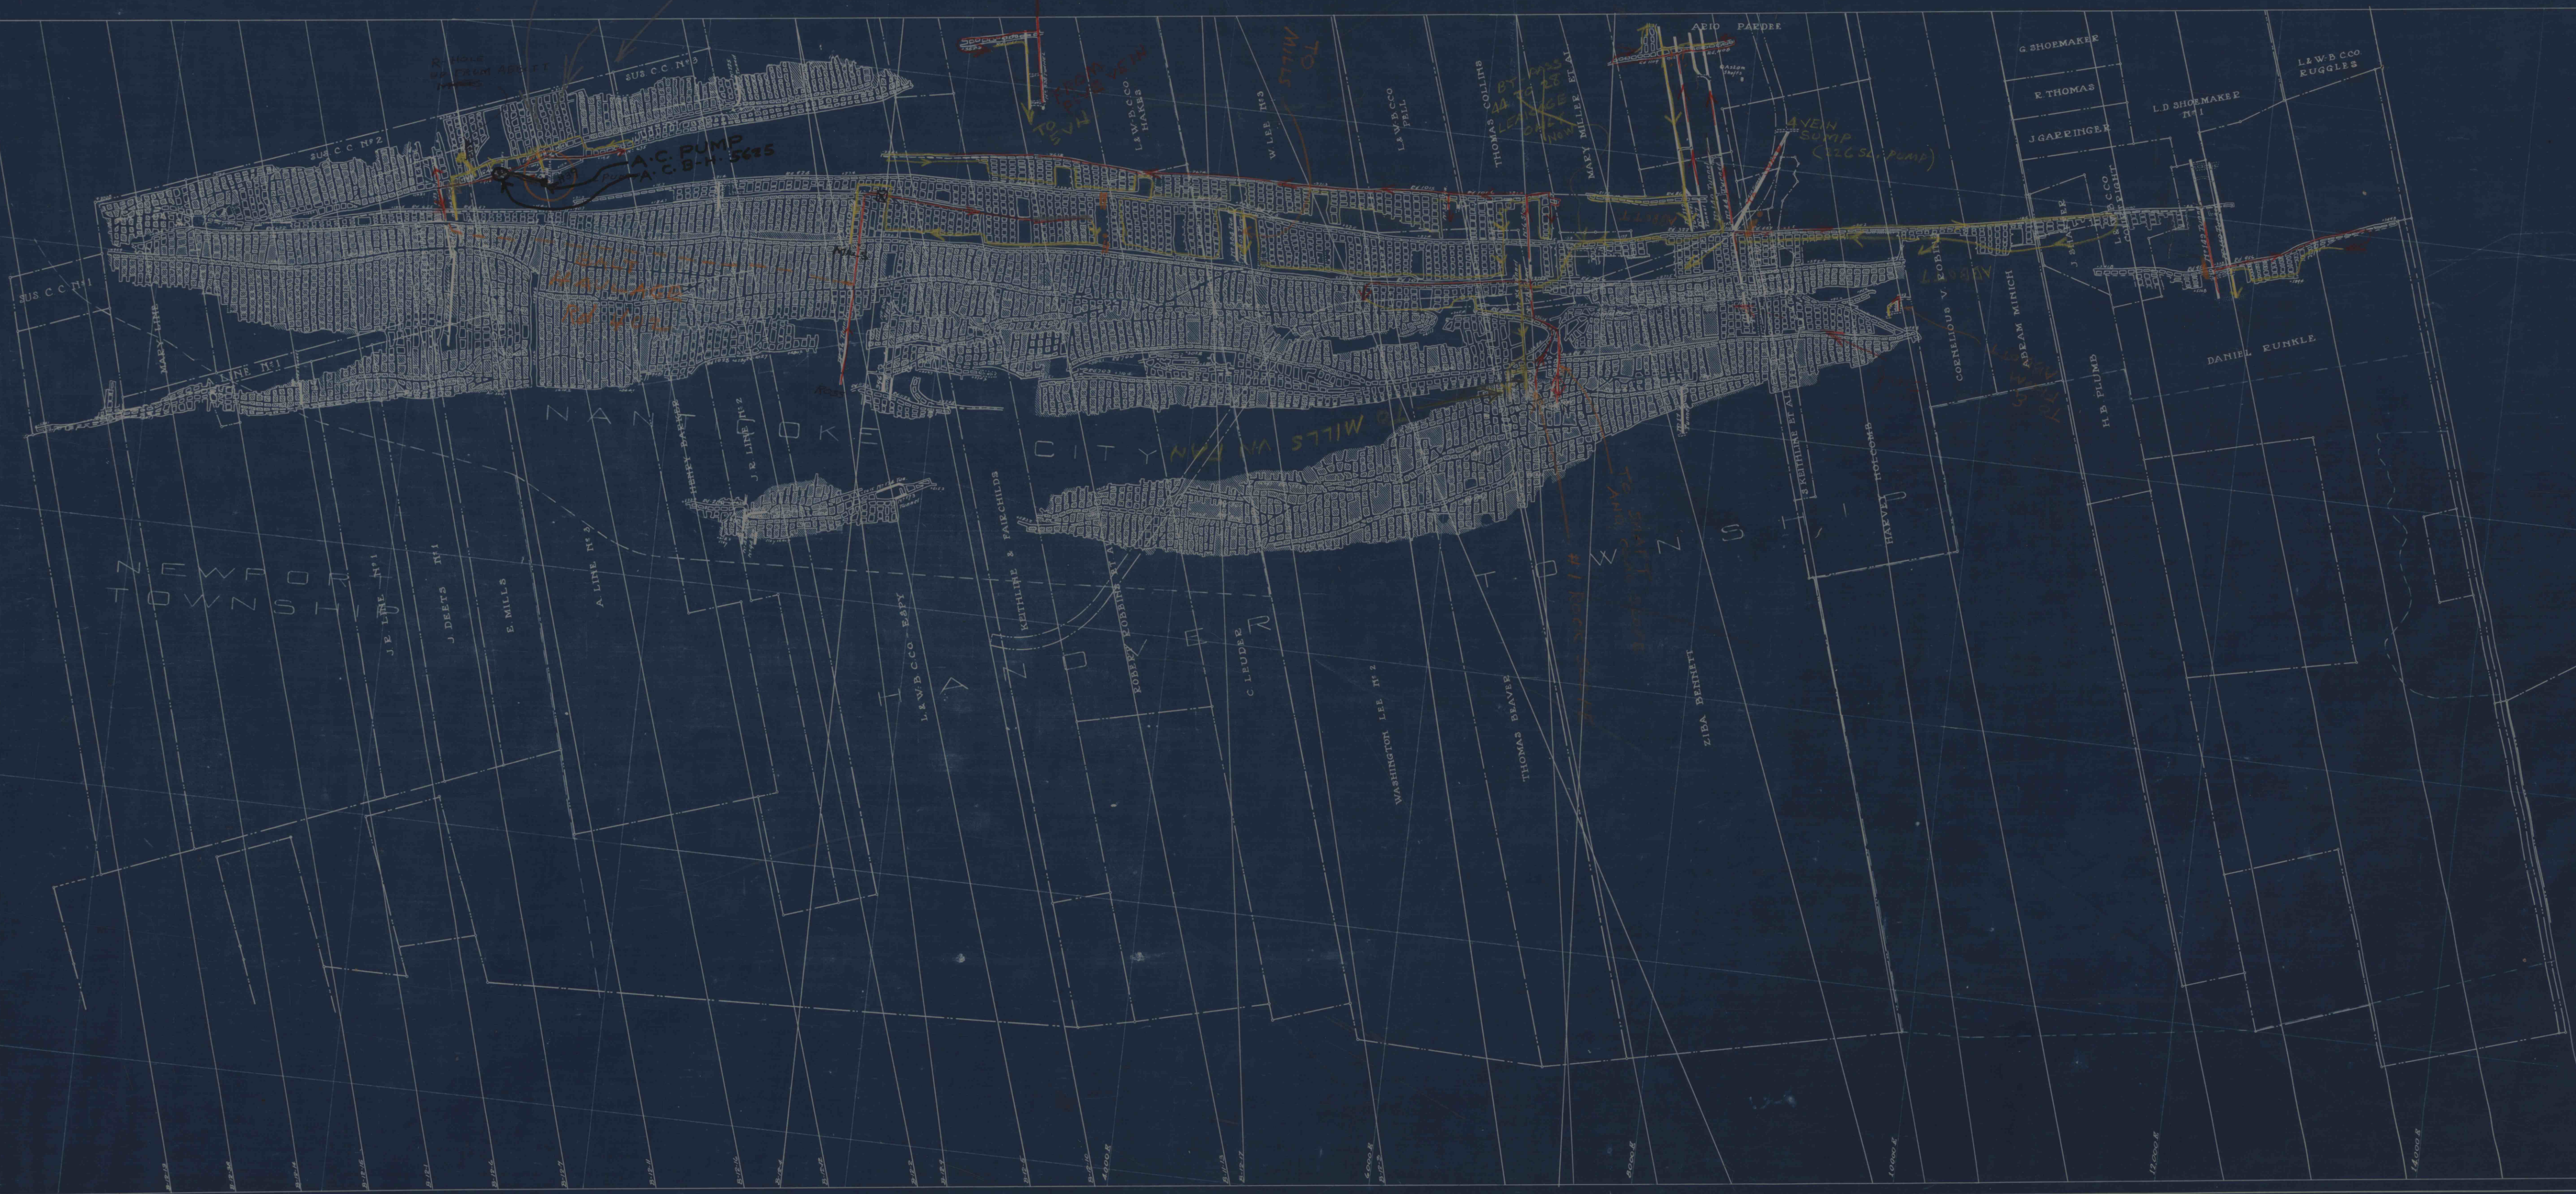

TRACING	EXTENDED
Jan. 1	1000
Jan. 2	1000
GEORGE VEIN
AUCHINCLOSS
BLISS & TRUESDALE COLLIERIE
SCALE 1" = 400'