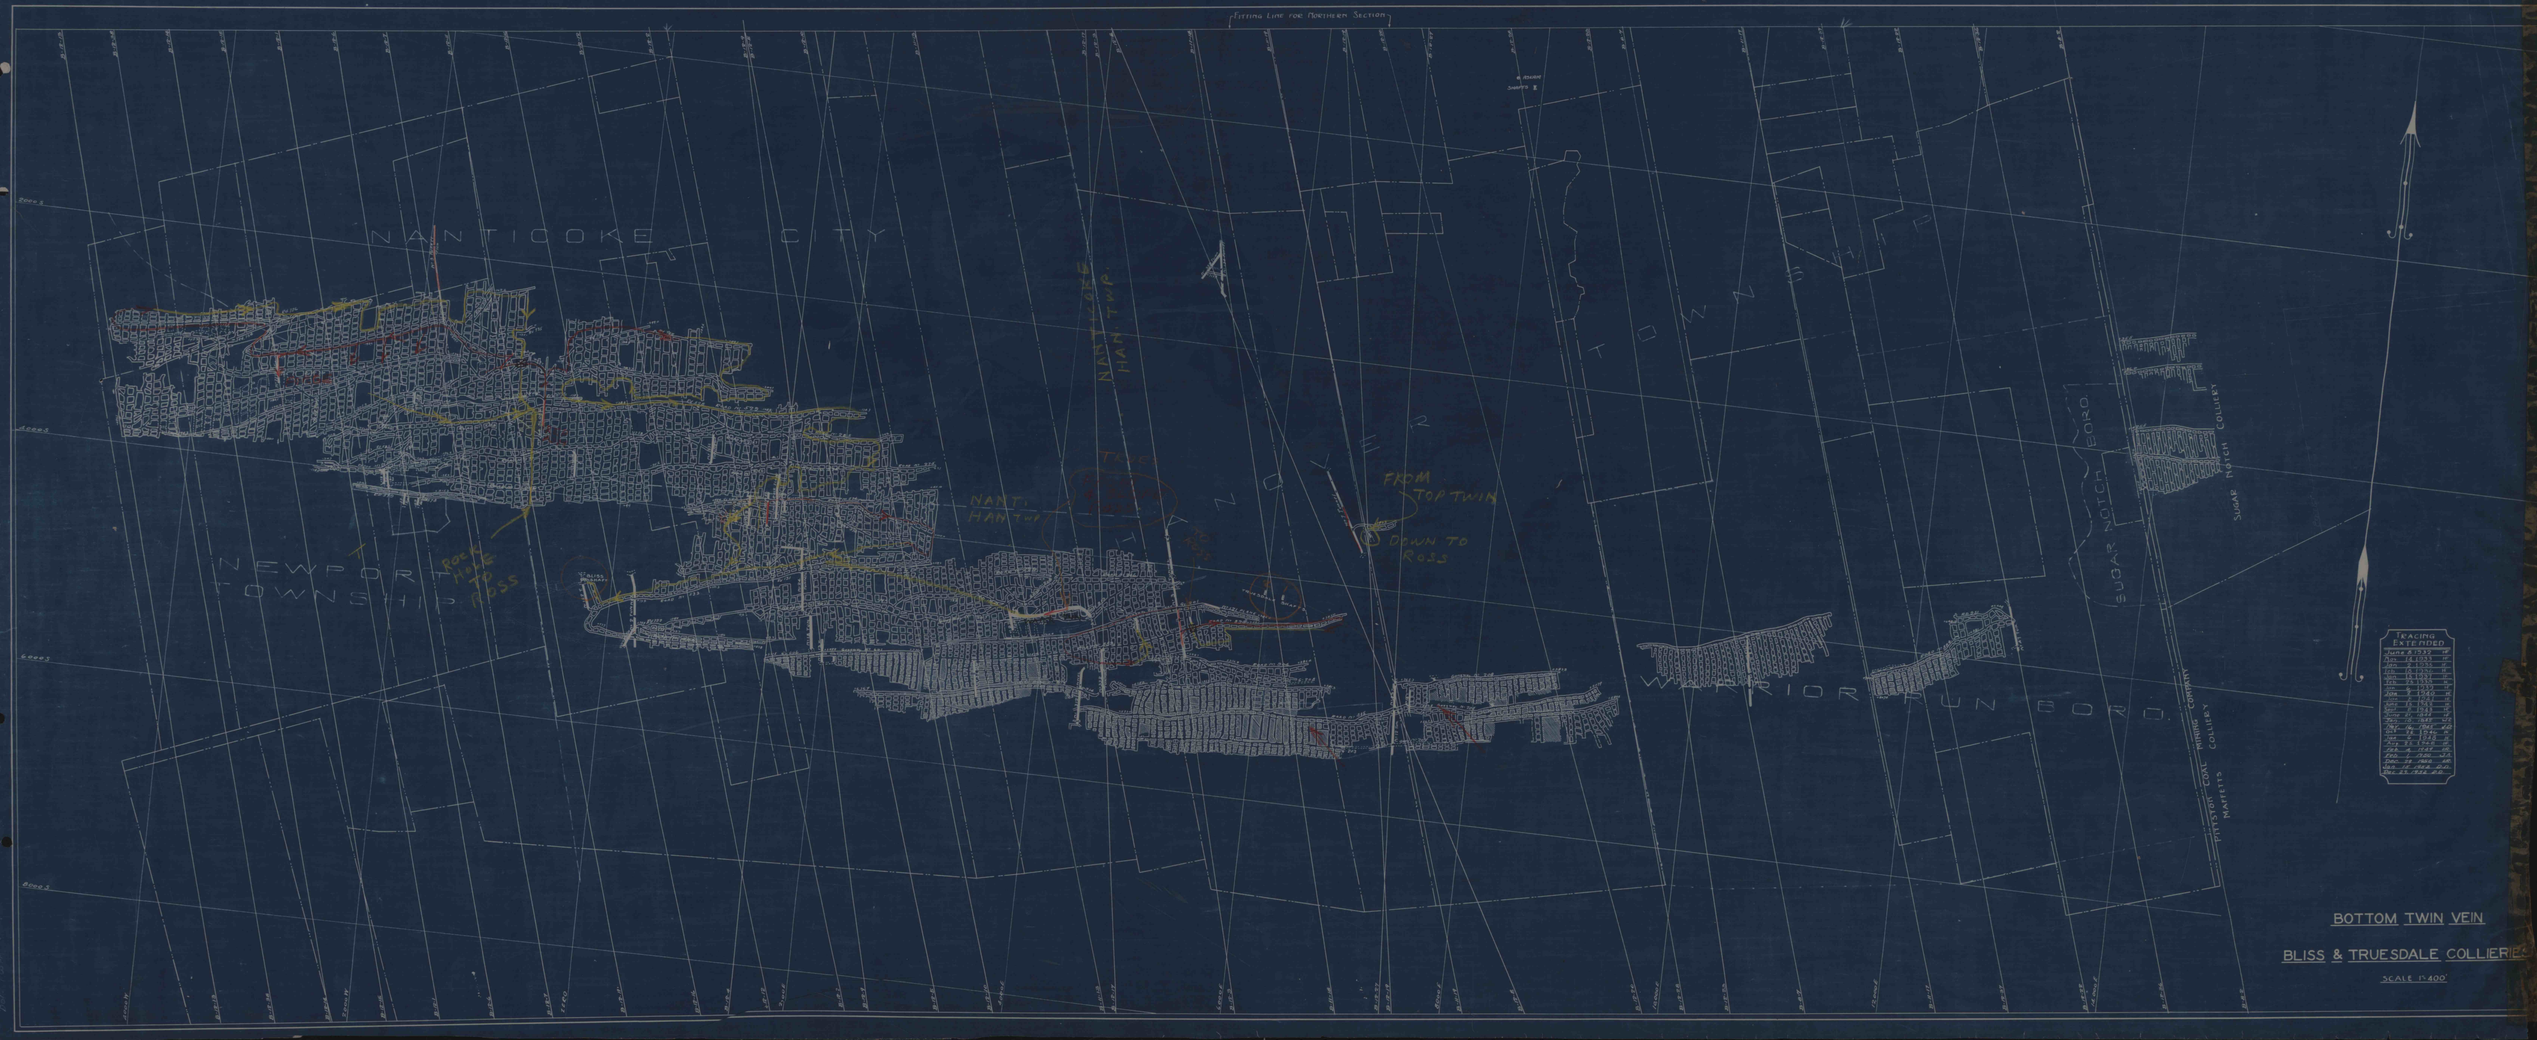
Fitting Line for Northern Section
NANTICOKE CITY
NEWPORT TOWNSHIP
NANTICOKE TOWNSHIP
WARRIOR RUN BORO.
SUGAR NOTCH BORO.
SUGAR NOTCH COLLIERY
HUYSTON COAL MINING COMPANY
MAYFETTS COLLIERY
NANT. HAN TWP
FROM TOP TWIN
DOWN TO ROSS
Rock Hole To Ross
TRACING EXTENDED
BOTTOM TWIN VEIN
BLISS & TRUESDALE COLLIERIES
SCALE 1" = 400'