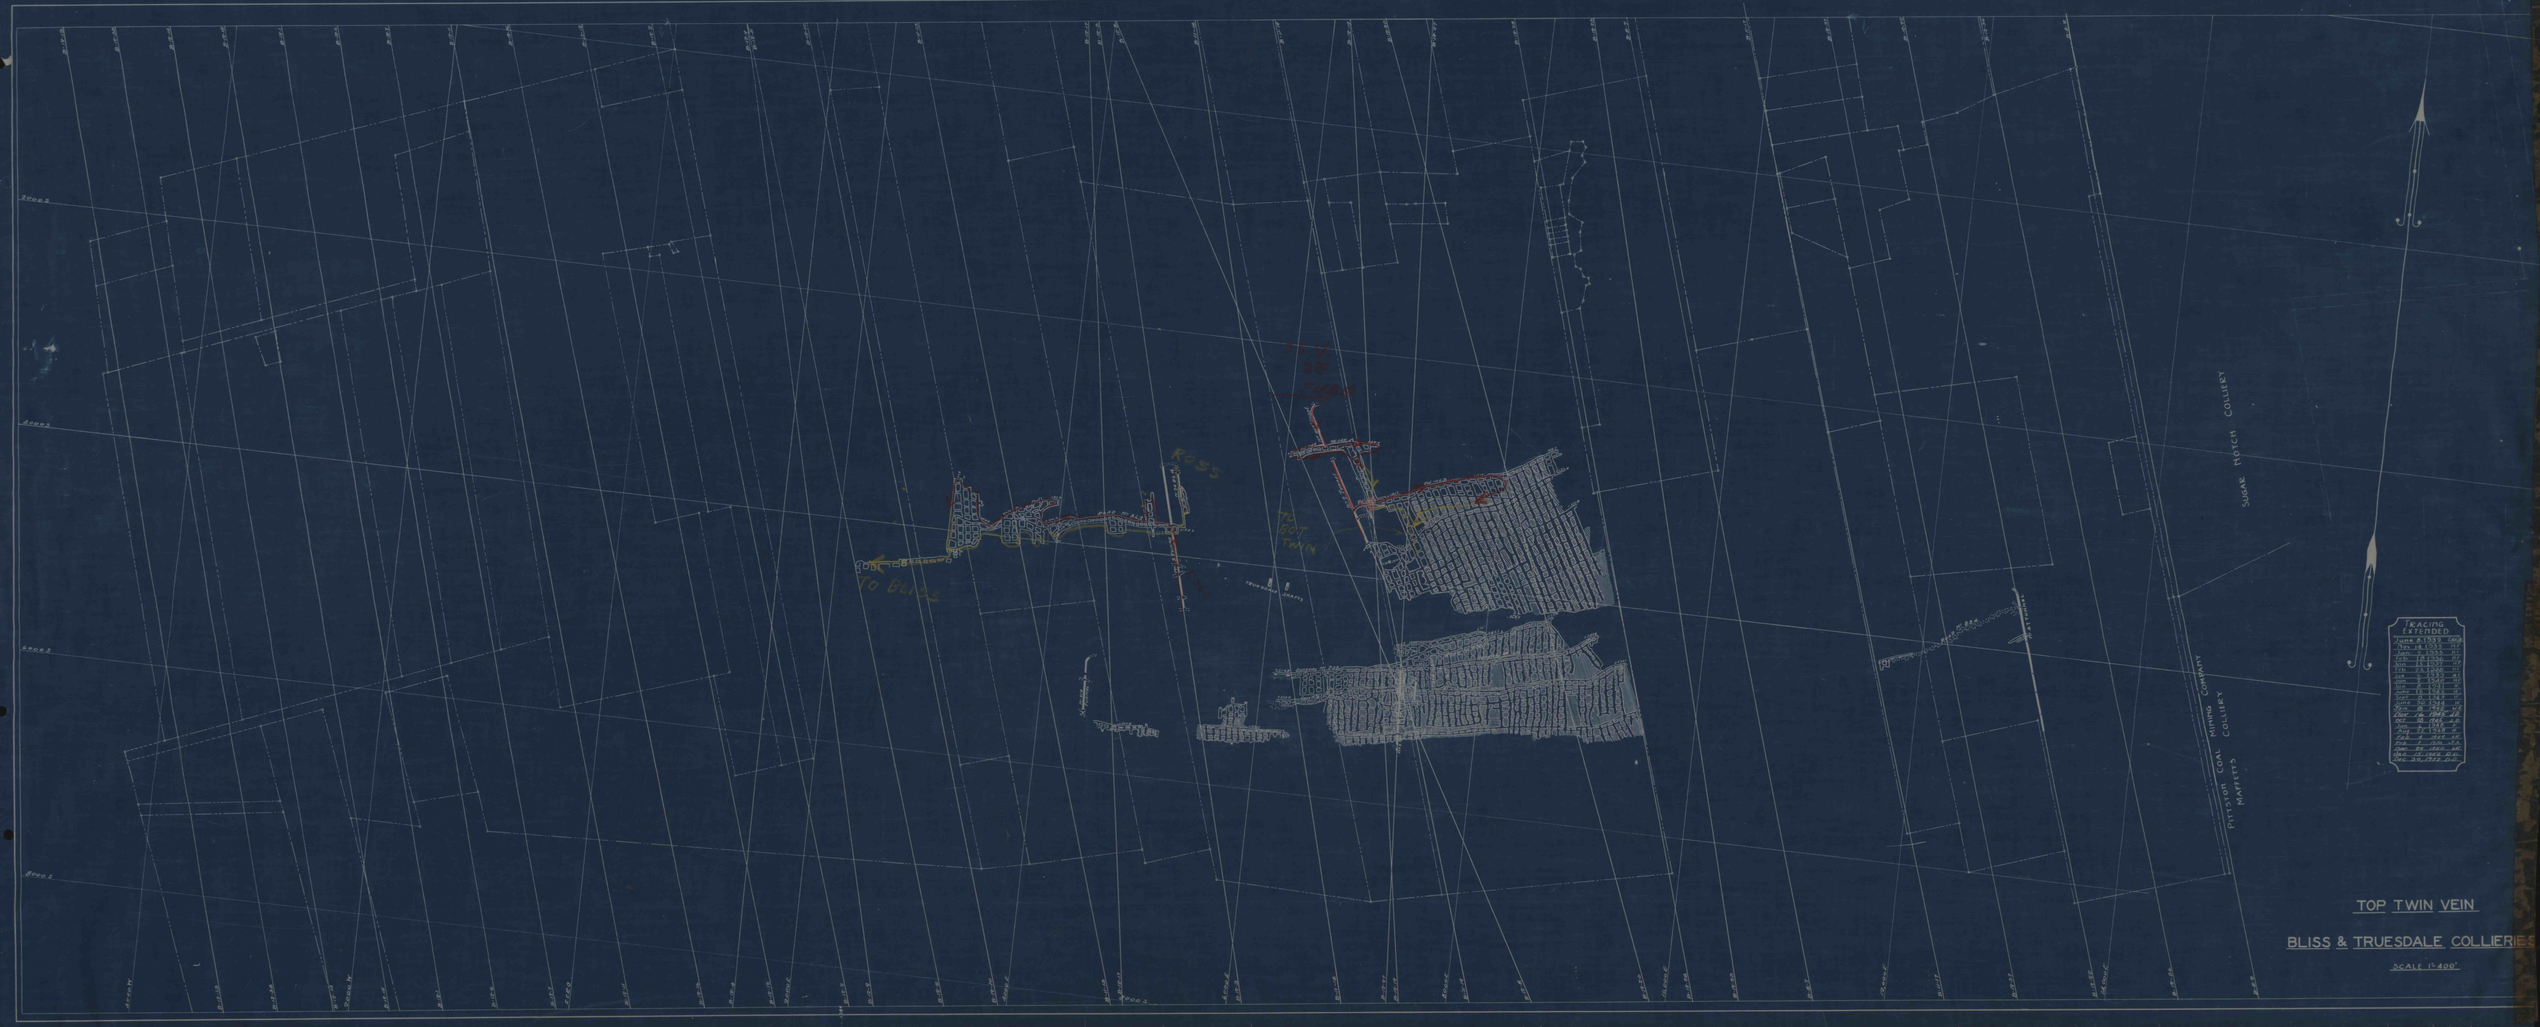
TO BLISS
ROSS
TO BOT TWIN
SUGAR HOLCH COLLIERY
PITTSTON COAL MINING COMPANY
MAFFETTS COLLIERY
TRACING EXTENDED
TOP TWIN VEIN
BLISS & TRUESDALE COLLIERIES
SCALE 1" 400'