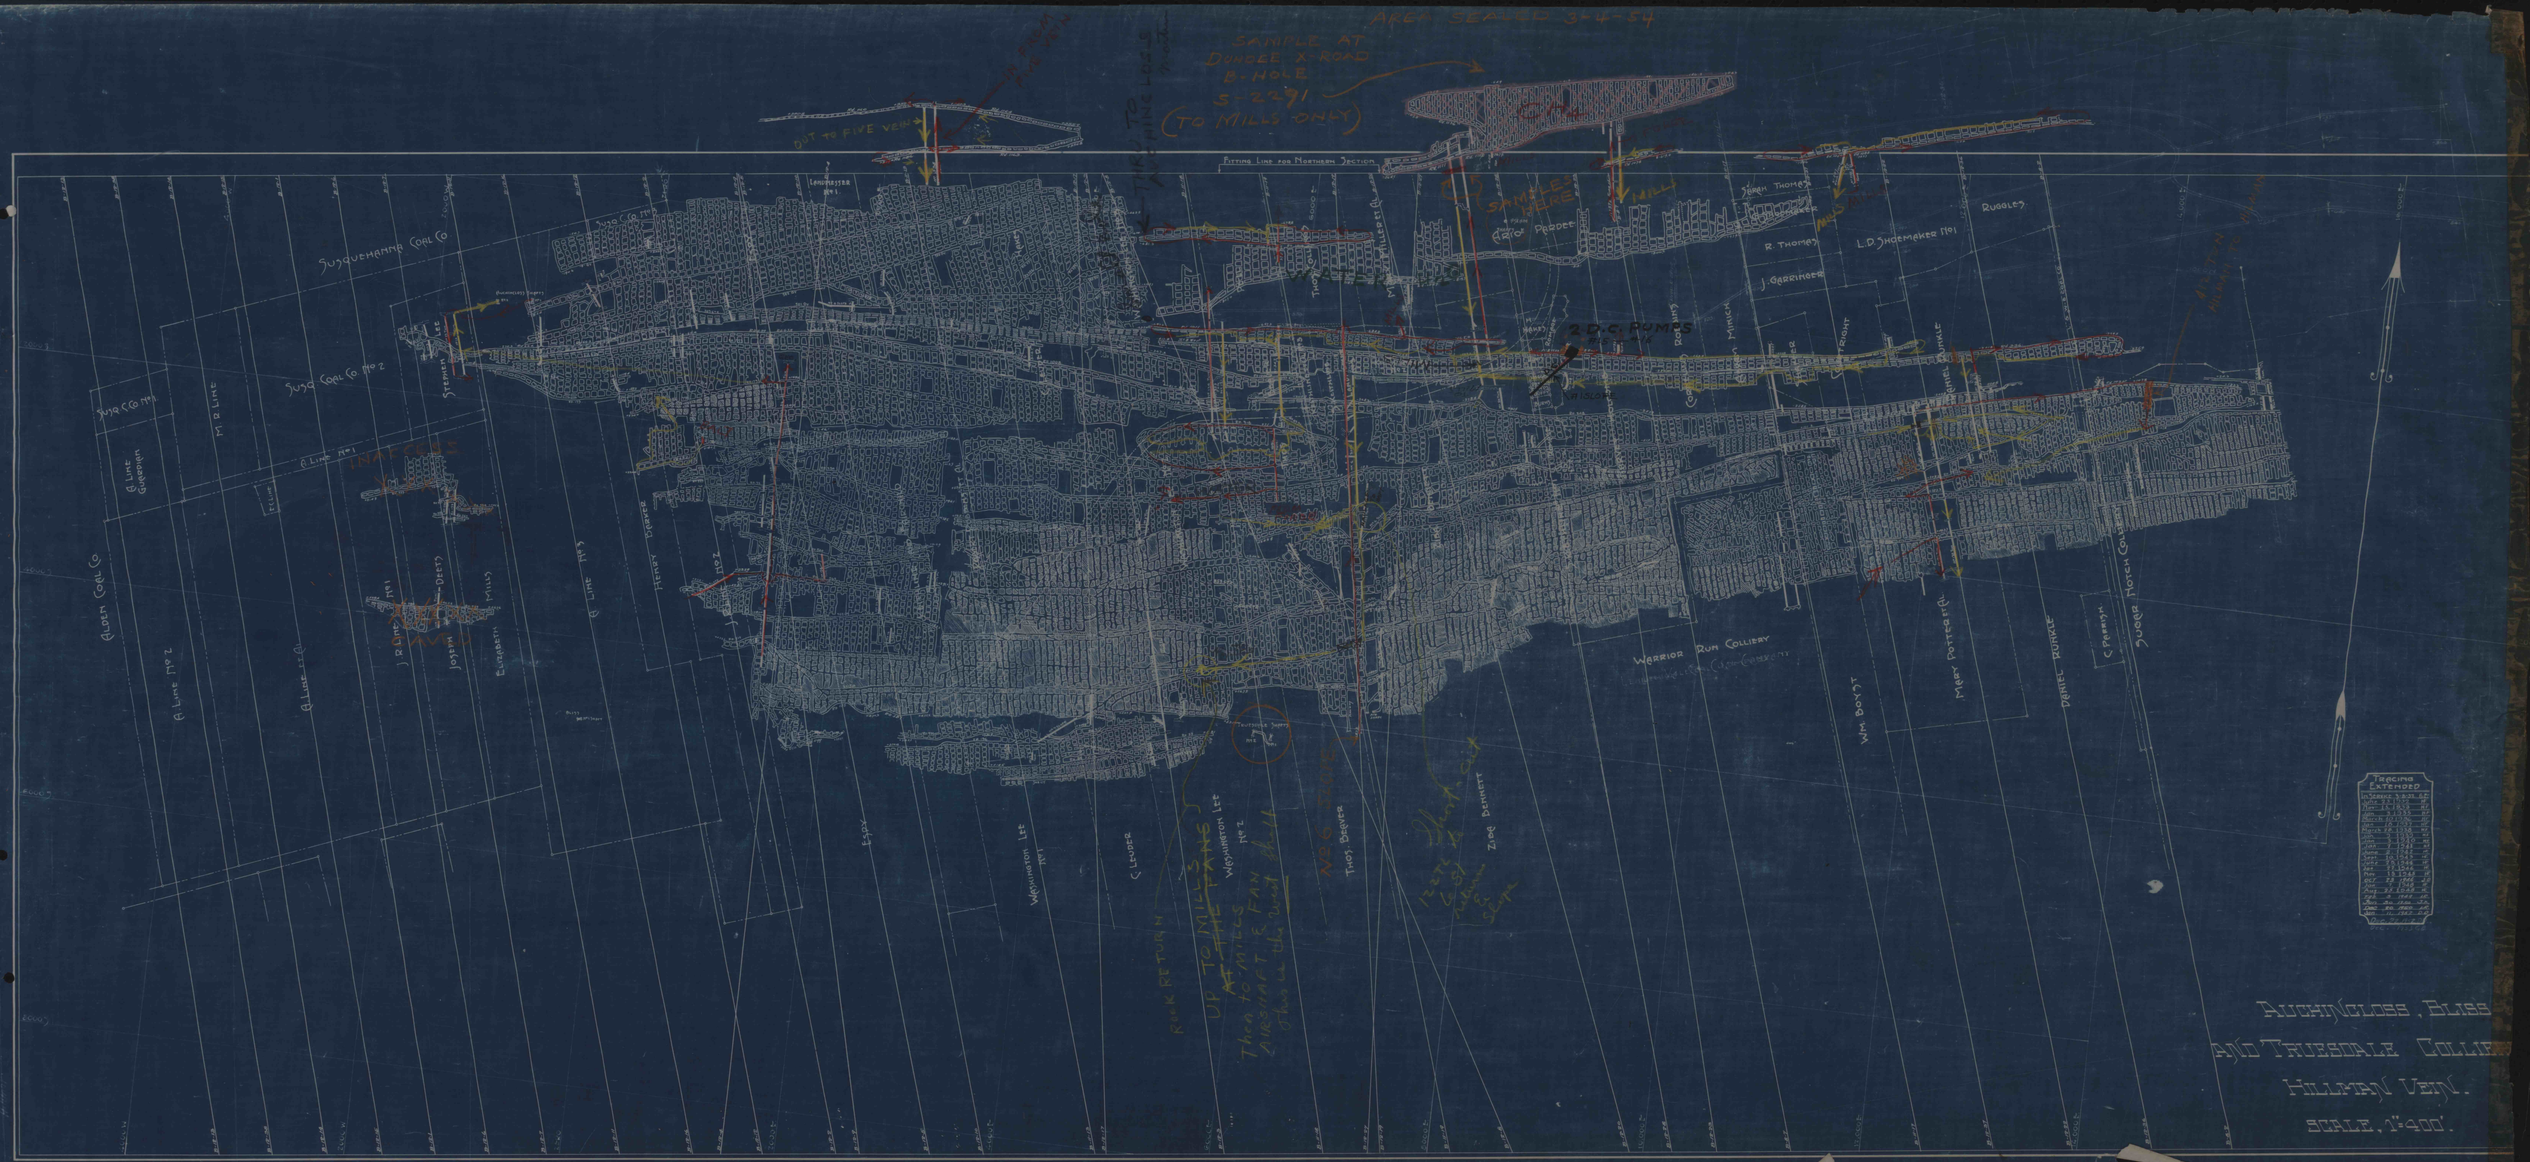
AREA SEALED 3-4-54
SAMPLE AT DUNDEE X-ROAD B-HOLE 5-2291 (TO MILLS ONLY)
OUT TO FIVE VENT
FITTING LINE FOR NORTHERN SECTION
SAMPLES HERE
Floor Pedde
Joseph Thomas
R. Thomas
L.D. Judemeker No1
Ruggles
2 D.C. PUMPS
Susquehanna Coal Co
Susq Co No1
Susq Coal Co No 2
Stephen Lee
Mt Pleasant
Mt 2 Line
A Line No1
A Line Gordon
Alden Coal Co
A Line No 2
A Line No 3
J R Line No1
Joseph Deets
Elizabeth Mills
Henry Beaver
Hice
Lewis
Lewisville
Thos Beaver
Wm Boyst
Mary Potter Rd.
Daniel Burkle
Warrior Run Colliery
Wm. Gibson Co. Contractors
Espy
Washington Lee No1
Washington Lee No 2
C Leader
Rock Re Turn
UP TO MILLS AT THE FANS
Then to MILLS
AIRSHAFT & FAN
Shown in the Quest Book
No 6 Slope
Thos Beaver
Zipe Bennett
Tracing Extended
Hillman Vent.
Scale 1"=400'.