


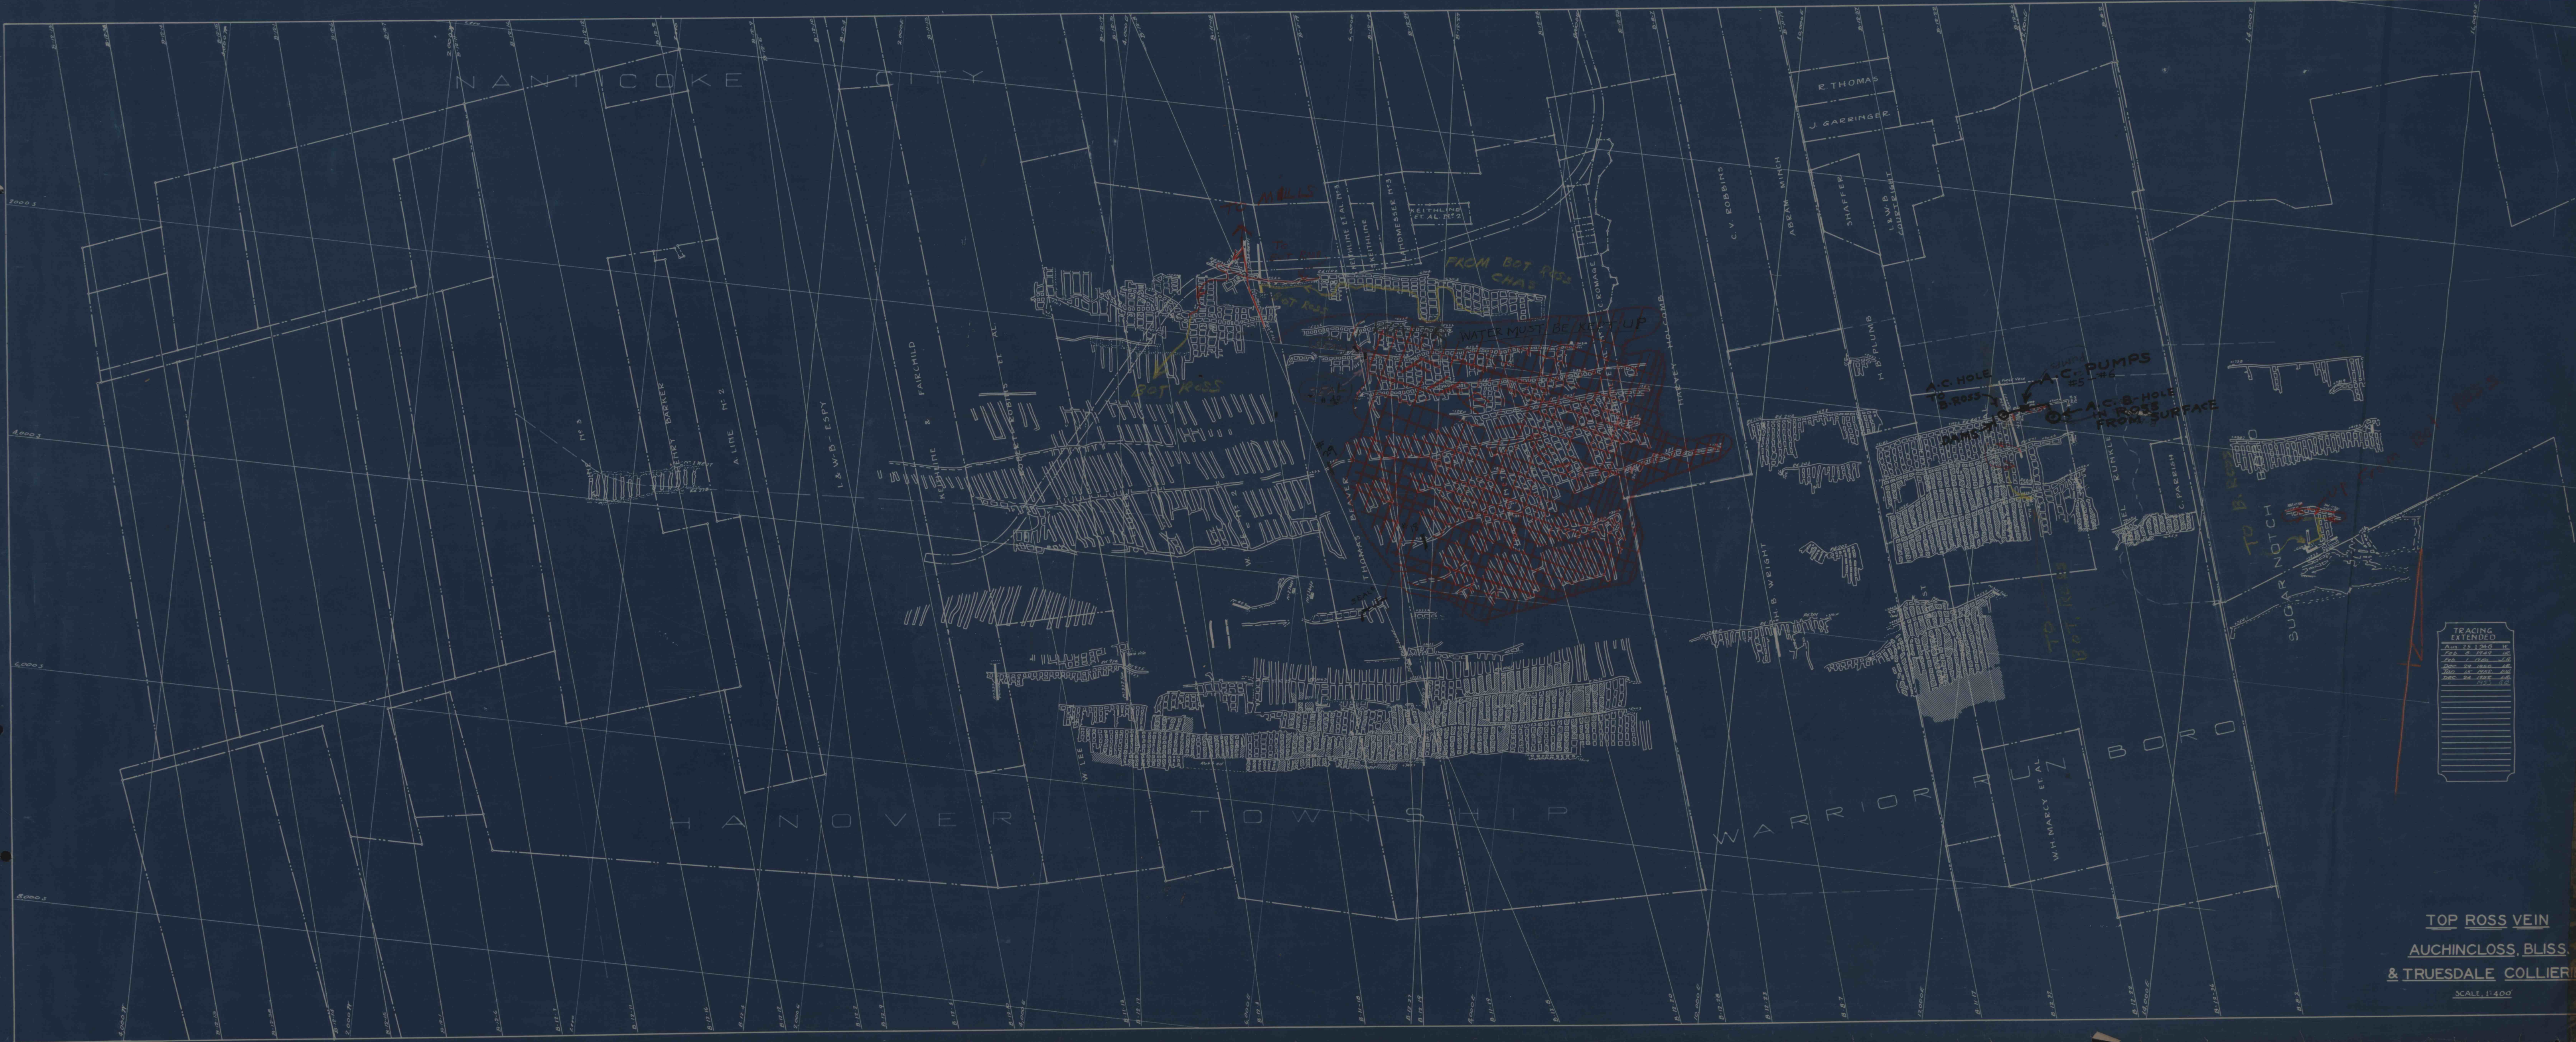

TRACING EXTENDED	
Aug 25 1940	11
Feb 2 1941	10
Feb 1 1942	10
Dec 18 1942	10
Dec 18 1943	10
TOP ROSS VEIN
AUCHINCLOSS, BLISS,
& TRUESDALE COLLIERIES
SCALE, 1"=400'