


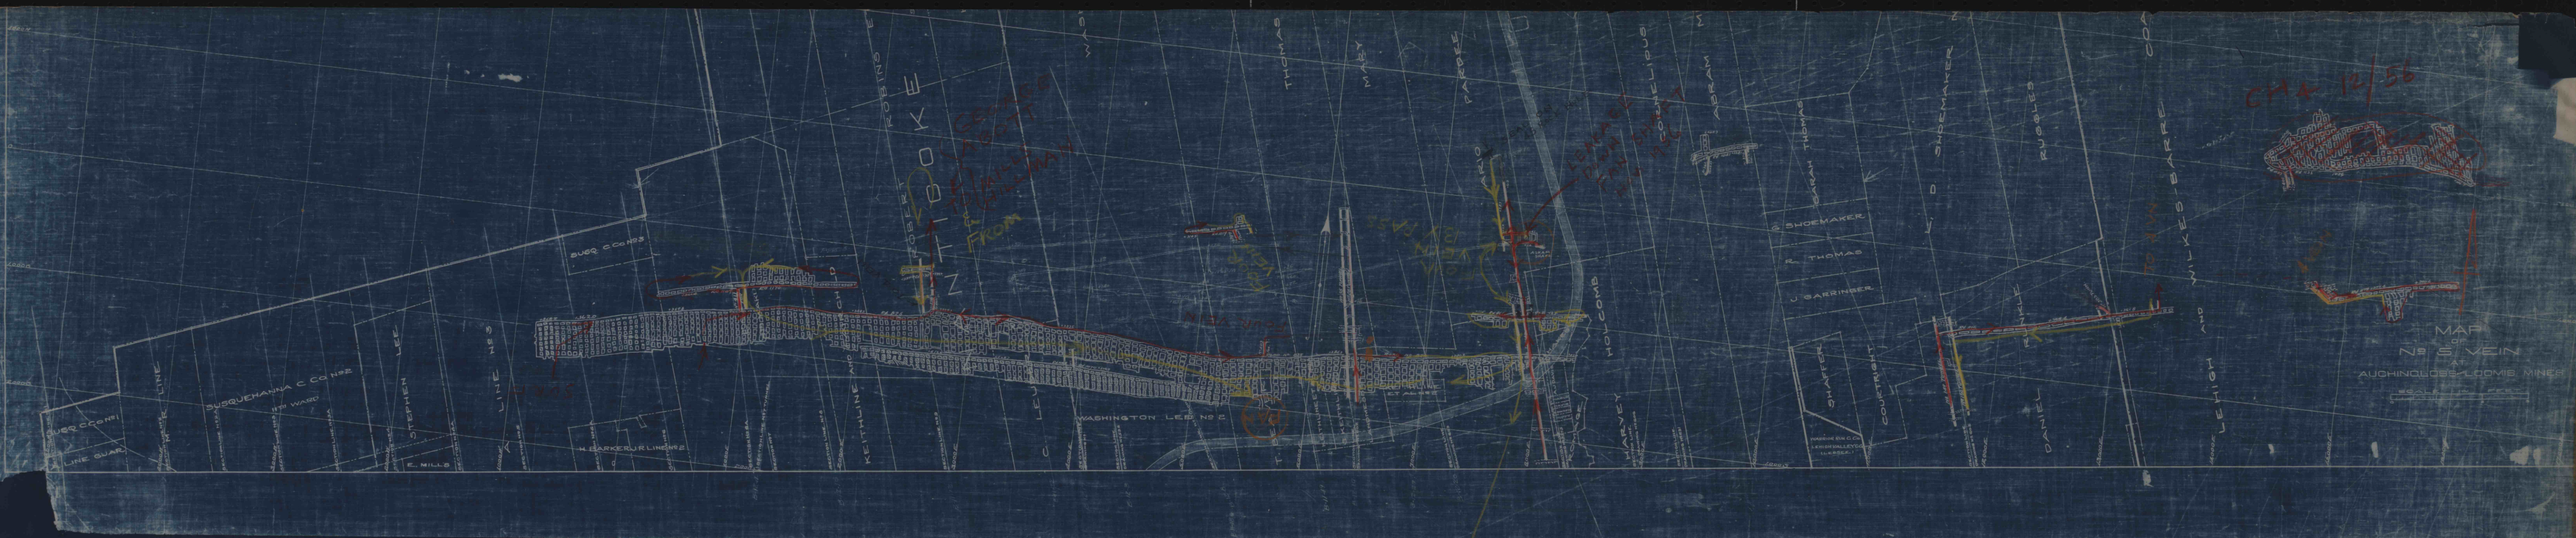

Nov 1926
OUT 140 FEET
TUNNEL TO GEORGE
TO 28 TH
LEVEL 28,000