


NO. 15

FOUR VEIN

50-51

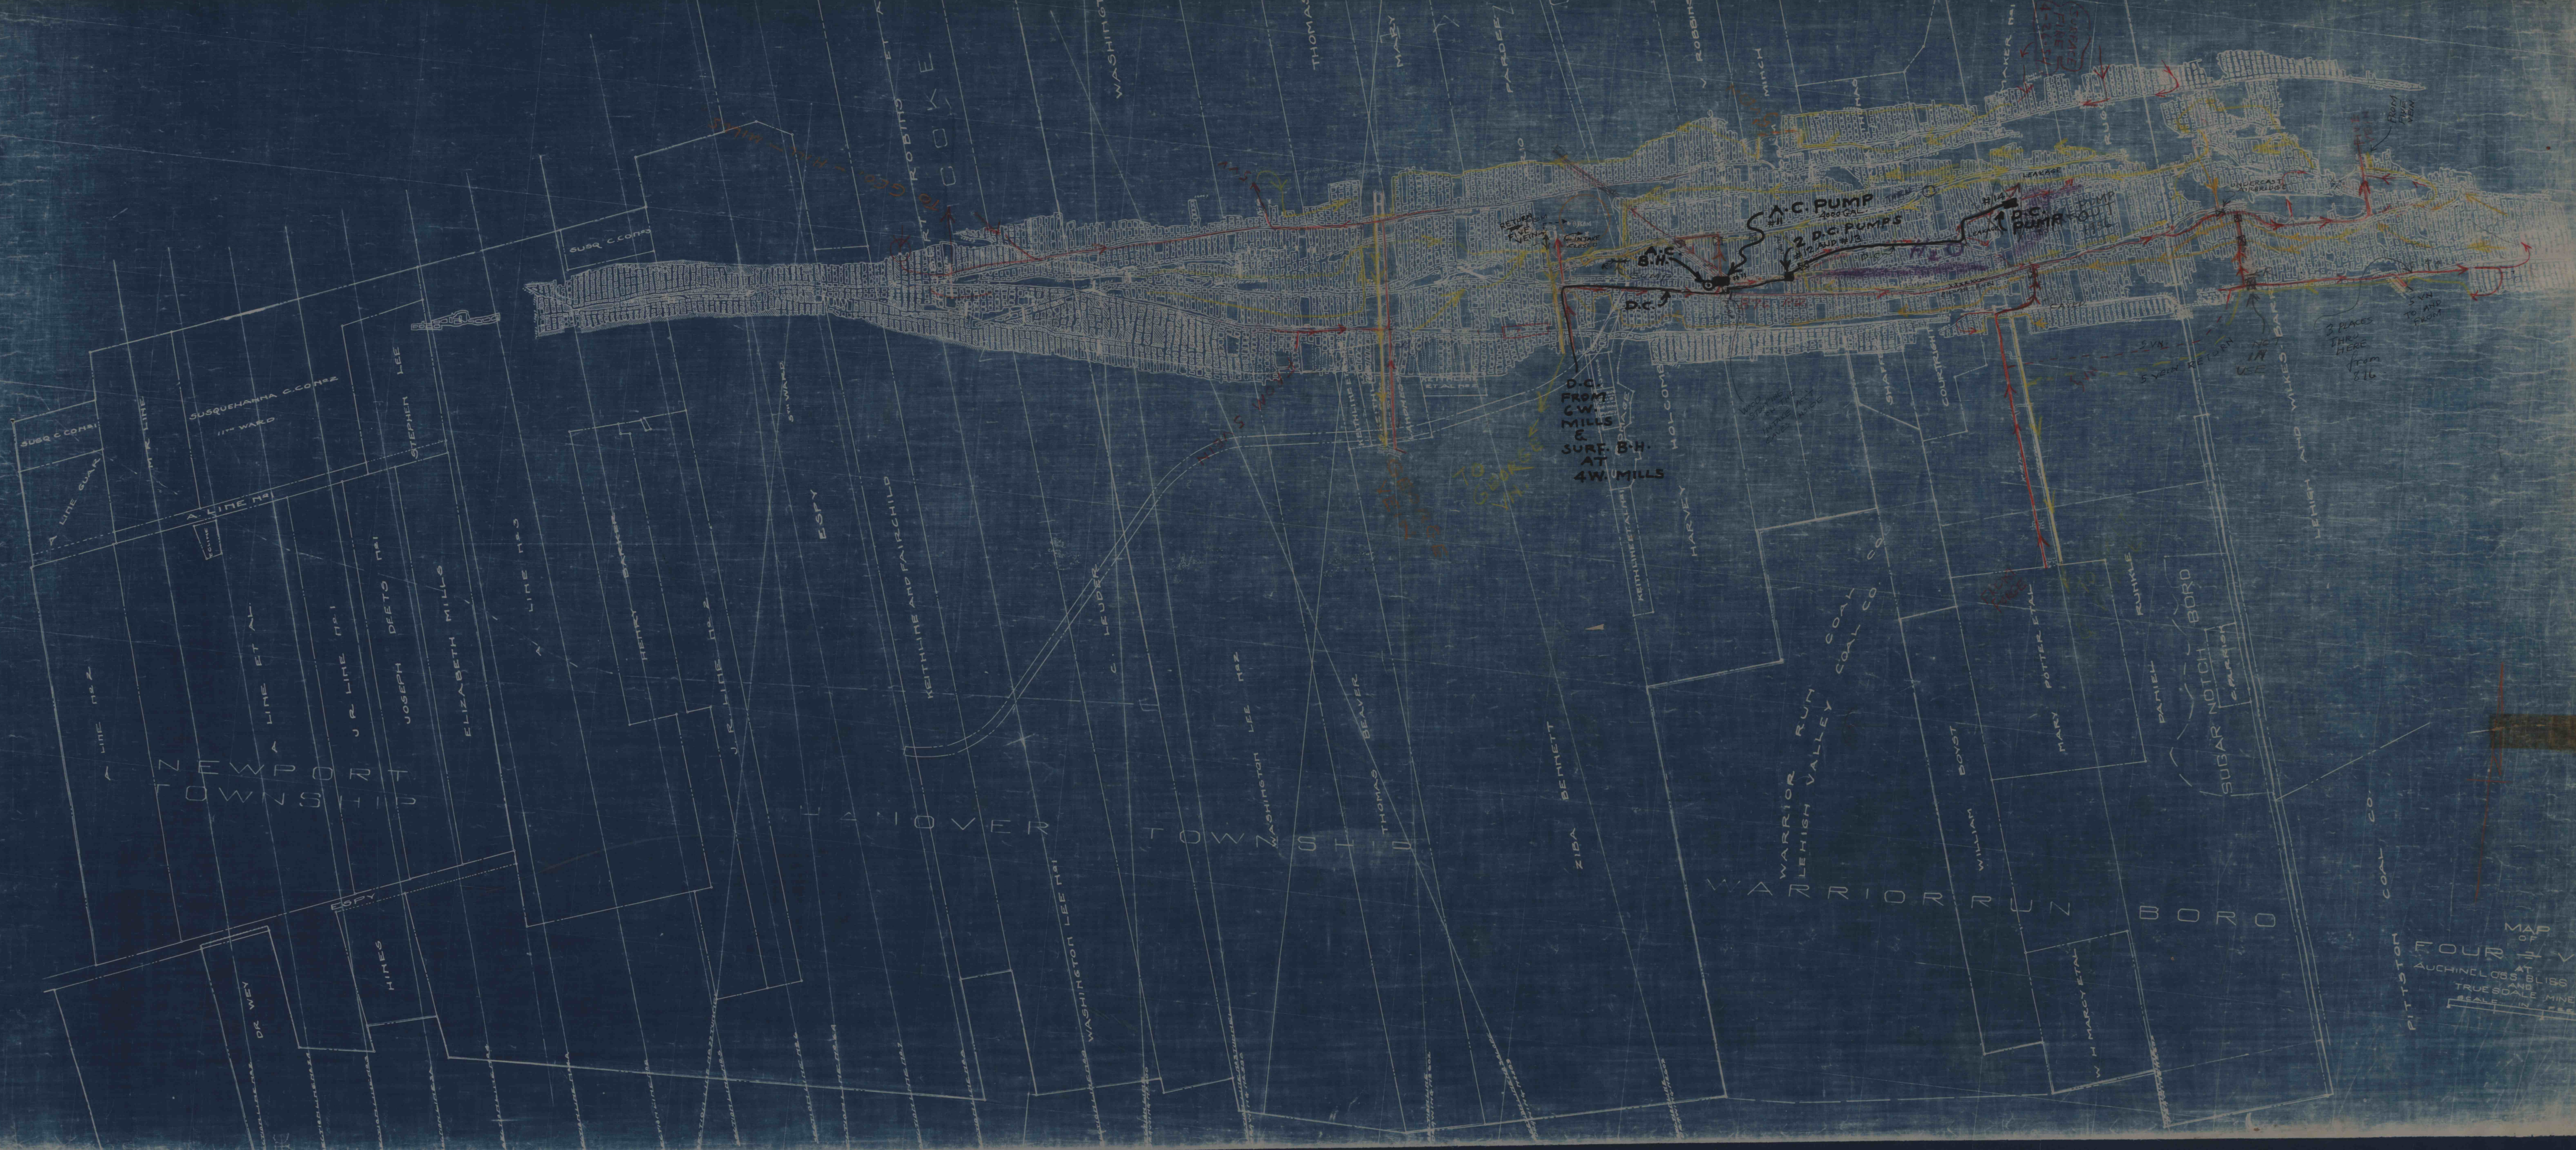

MAP OF
FOUR VEIN
AT
AUCHINCLOSS BLISS LUMBER
TRUE SCALE MINES
SCALE IN FEET