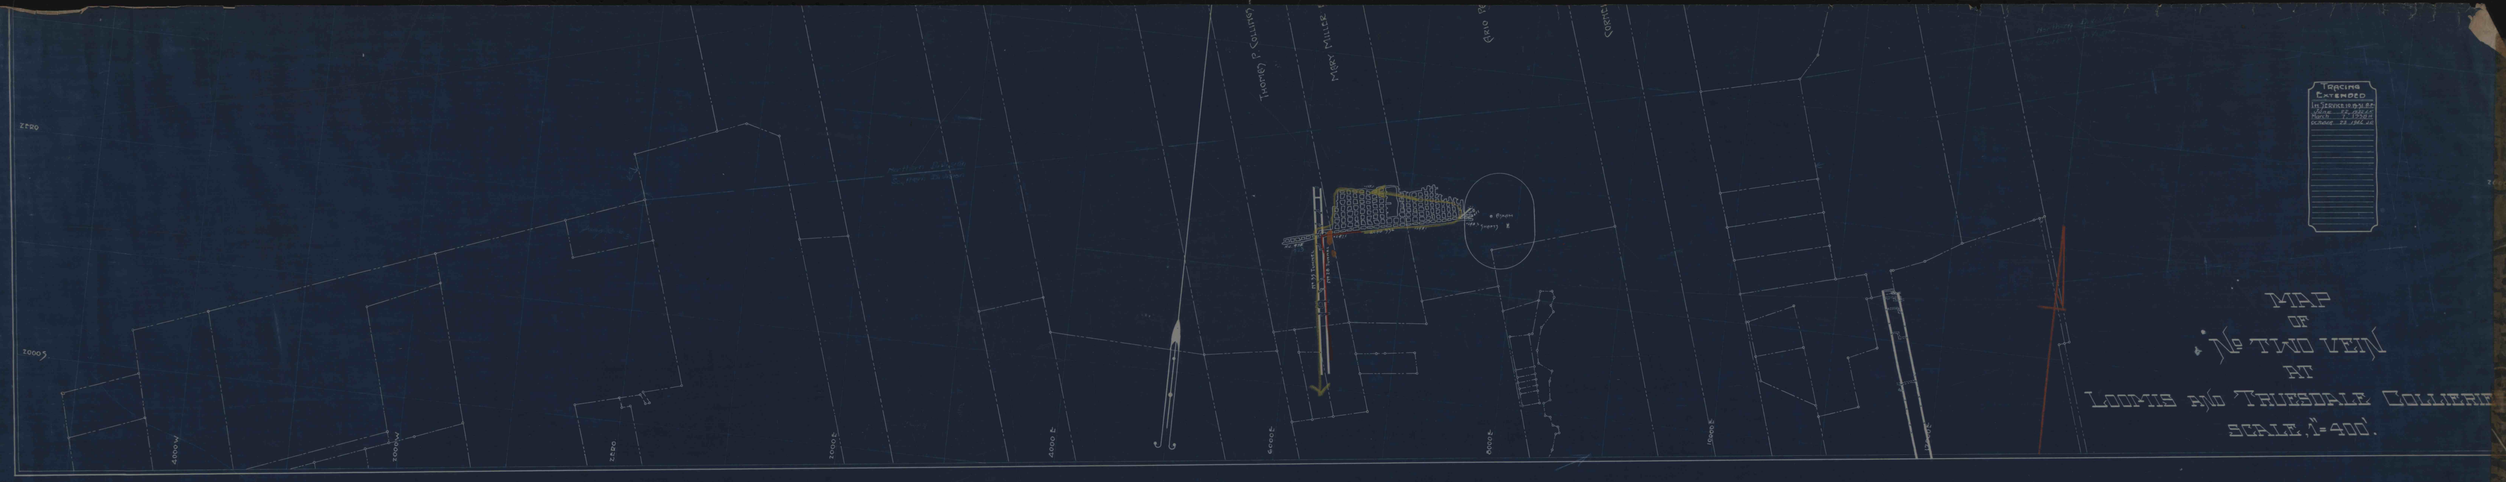
Tracing Extended
MAP
OF
No TWO VEIN
AT
SCALE, 1-400'.