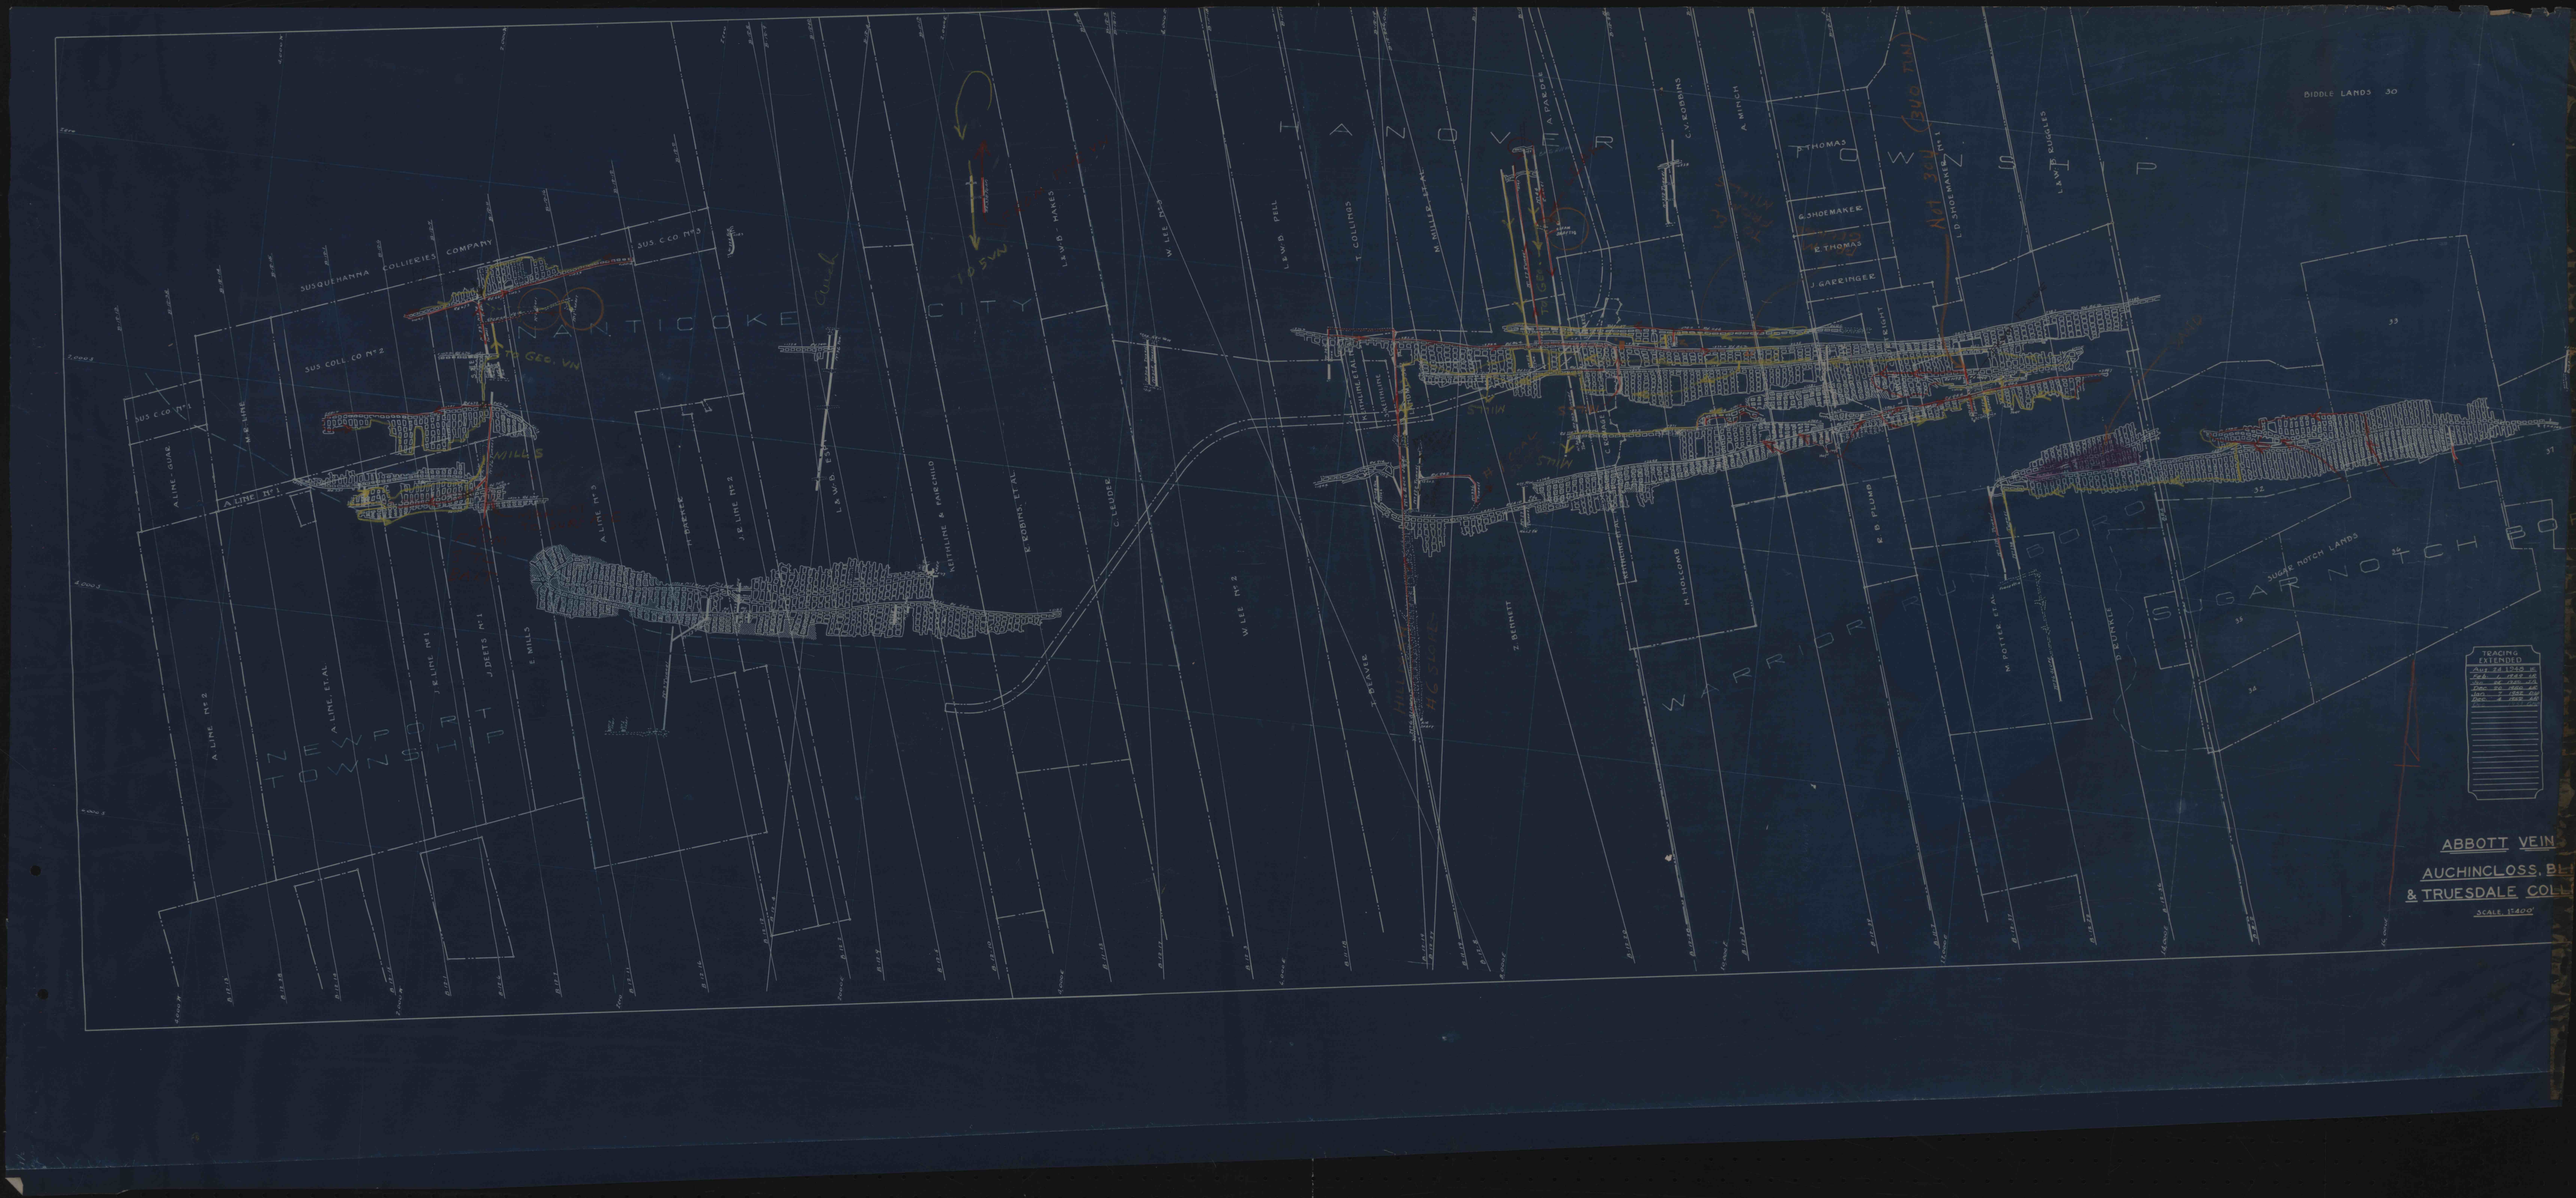
ABBOTT VEIN
AUCHINCLOSS, BE
& TRUESDALE COLL
SCALE 1"=200'
TRACING EXTENDED
NANTICOKE CITY
HANOVER TOWNSHIP
WARRIOR RUN BOROUGH
SUGAR NOTCH BO
NEWPORT TOWNSHIP
SUSQUEHANNA COLLIERIES COMPANY
SUS COLL CO Nº 2
SUS COLL CO Nº 3
SUS C CO
A LINE - GORE
A LINE Nº 1
A LINE Nº 2
A LINE Nº 3
A LINE, ET AL
J & LINE Nº 1
J & LINE Nº 2
J DETTS Nº 1
E MILLS
H FORSTER
L & W R R CO
ARTHLINE & PARCHILD
E ROBINS, ET AL
C EDGE
W LEE Nº 2
L & W R PELL
T COLLINS
A PARDOE
C V ROBINS
A MINTH
F THOMAS
G SHOEMAKER
F THOMAS
J GARRINGER
D SHOEMAKER Nº 1
L & W R RUGGLES
E B PLUMP
H HOOPER
W POTTER ESQ
D RUTHCE
SUGAR NOTCH LANDS
MIDDLE LANDS 30
31
32
33
34
35