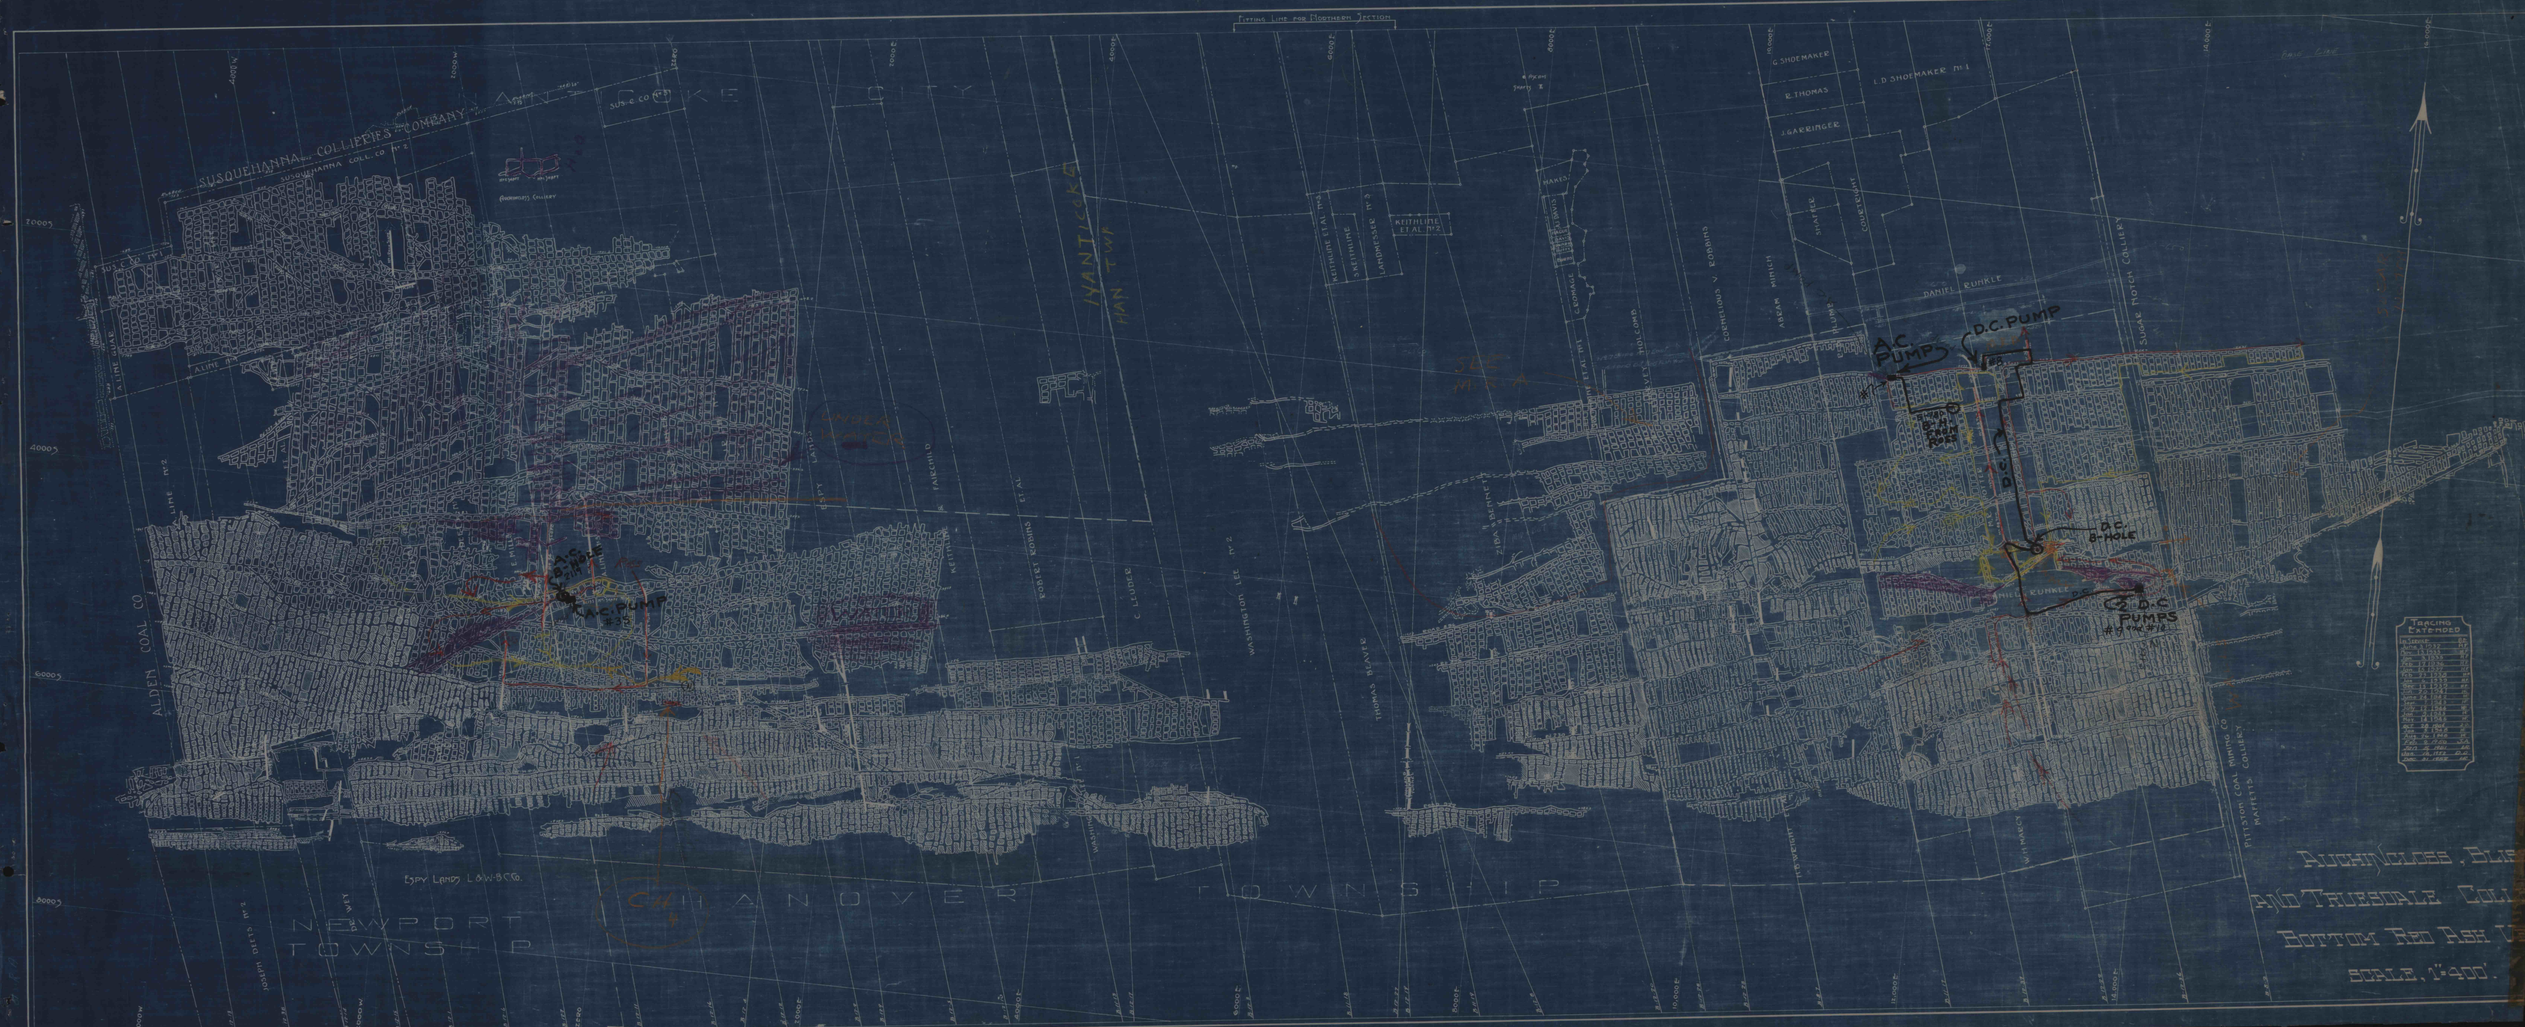
SUSQUEHANNA COLLIERIES COMPANY
SUSQUEHANNA COAL CO Nº 2
SUS-2 CO (R.R.)
ALDEN COAL CO
NEWPORT TOWNSHIP
HANOVER TOWNSHIP
IVANTICOKE
HAN TWP
LANDER HEIRS
KEITHLINE ET AL Nº2
KEITHLINE ET AL Nº3
KEITHLINE
LANDESSER Nº3
KEITHLINE ET AL Nº1
MARKS
G. SHOEMAKER
R. THOMAS
J. GARRINGER
L.D. SHOEMAKER Nº1
SHAFFER
COURTRIGHT
DANIEL RUNKLE
SUGAR NOTCH COLLIERY
ABRAM MINICH
WASHINGTON LEE Nº2
THOMAS BEAVER
ROBERT ROBINS ET AL
C. LEISHER
FAIRCHILD
WILLIAMS
PITTSTON COAL MINING CO
NAYLETTS COLLIERY
A.C. PUMPS
D.C. PUMP
D.C. 8-HOLE
2 D.C. PUMPS #17 and #18
A.C. PUMP #15
A.C. 2-HOLE
TRACING EXTENDED
and Trucsdale Coll
Bottom Red Ash V
SCALE, 1"=400'.