


8X3C

(TWIN)
ELEVEN FOOT

11 Feet

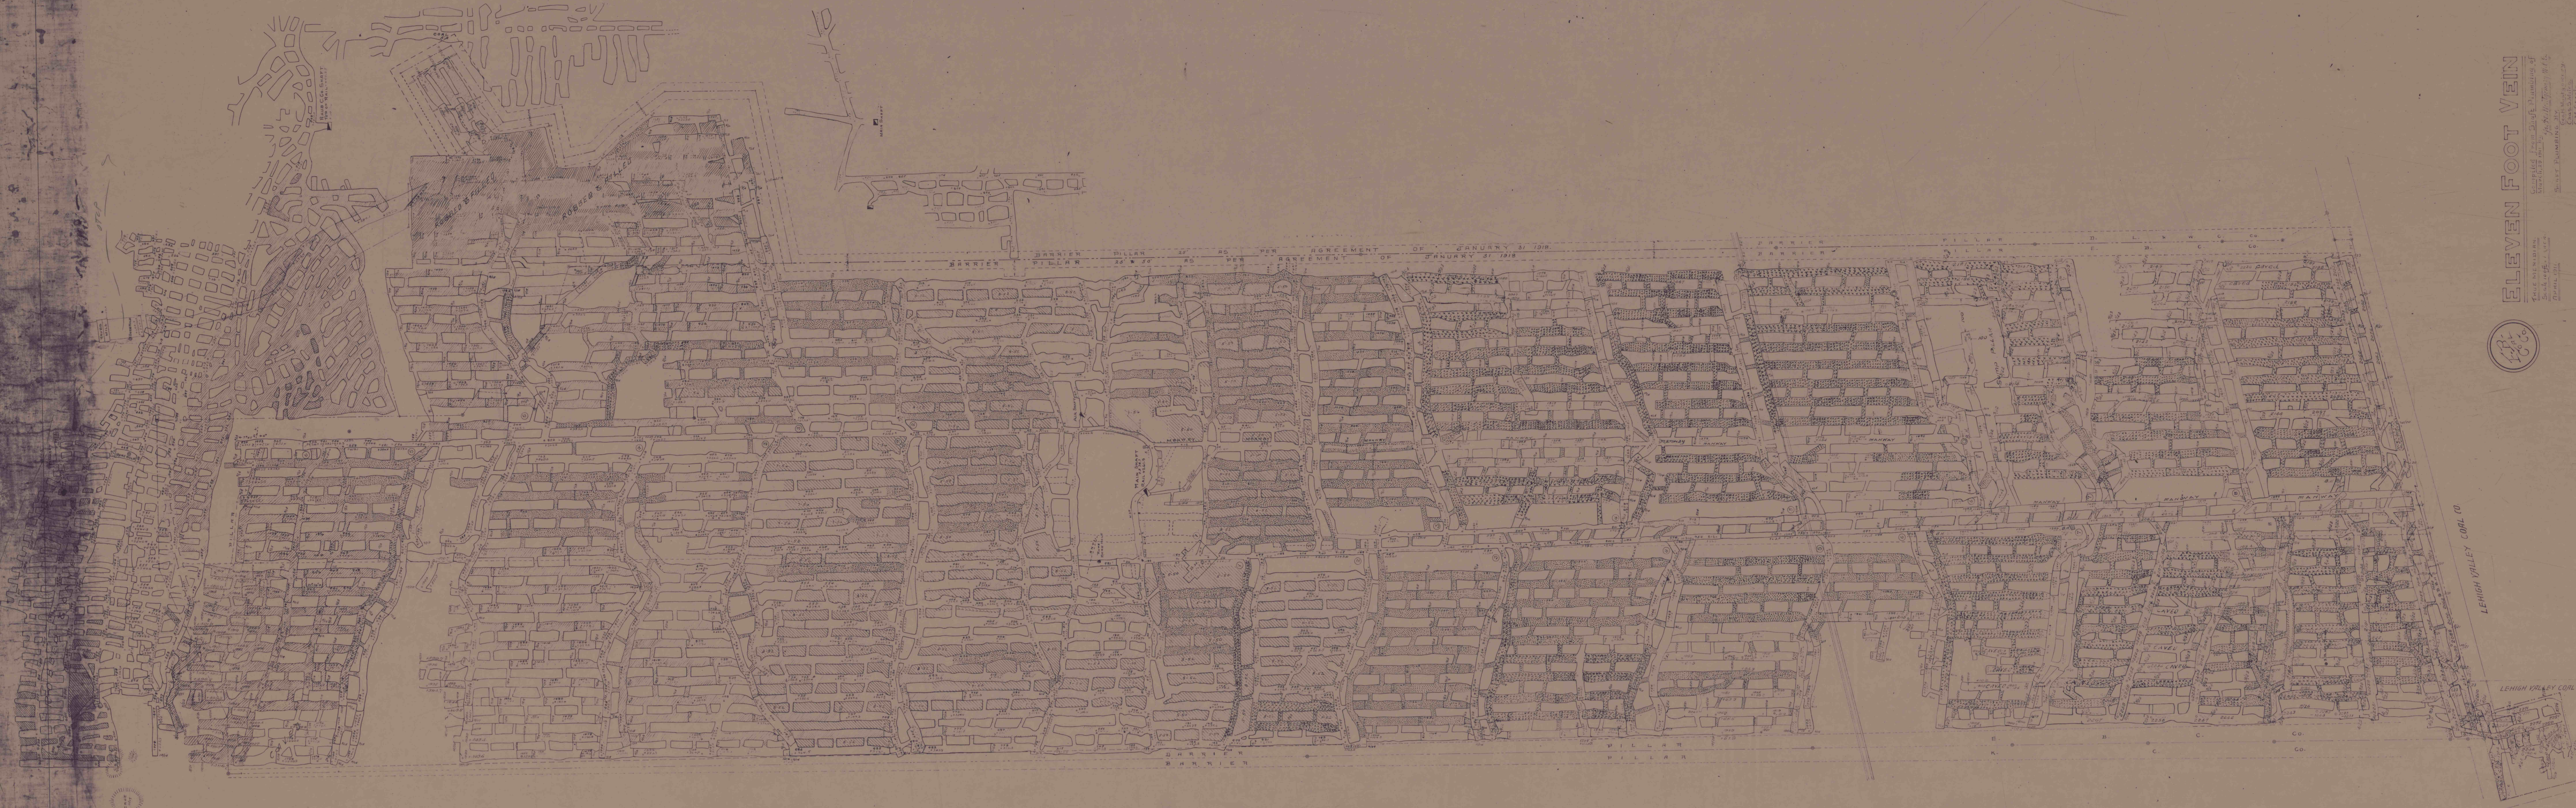

ELEVEN FOOT VEIN
Copyright 1918 by Lehigh Valley Coal Co.
All Rights Reserved
Printed at the Lehigh Valley Coal Co. Office
Pittston, Pa.



Revised June 1920

ELEVEN FOOT.