


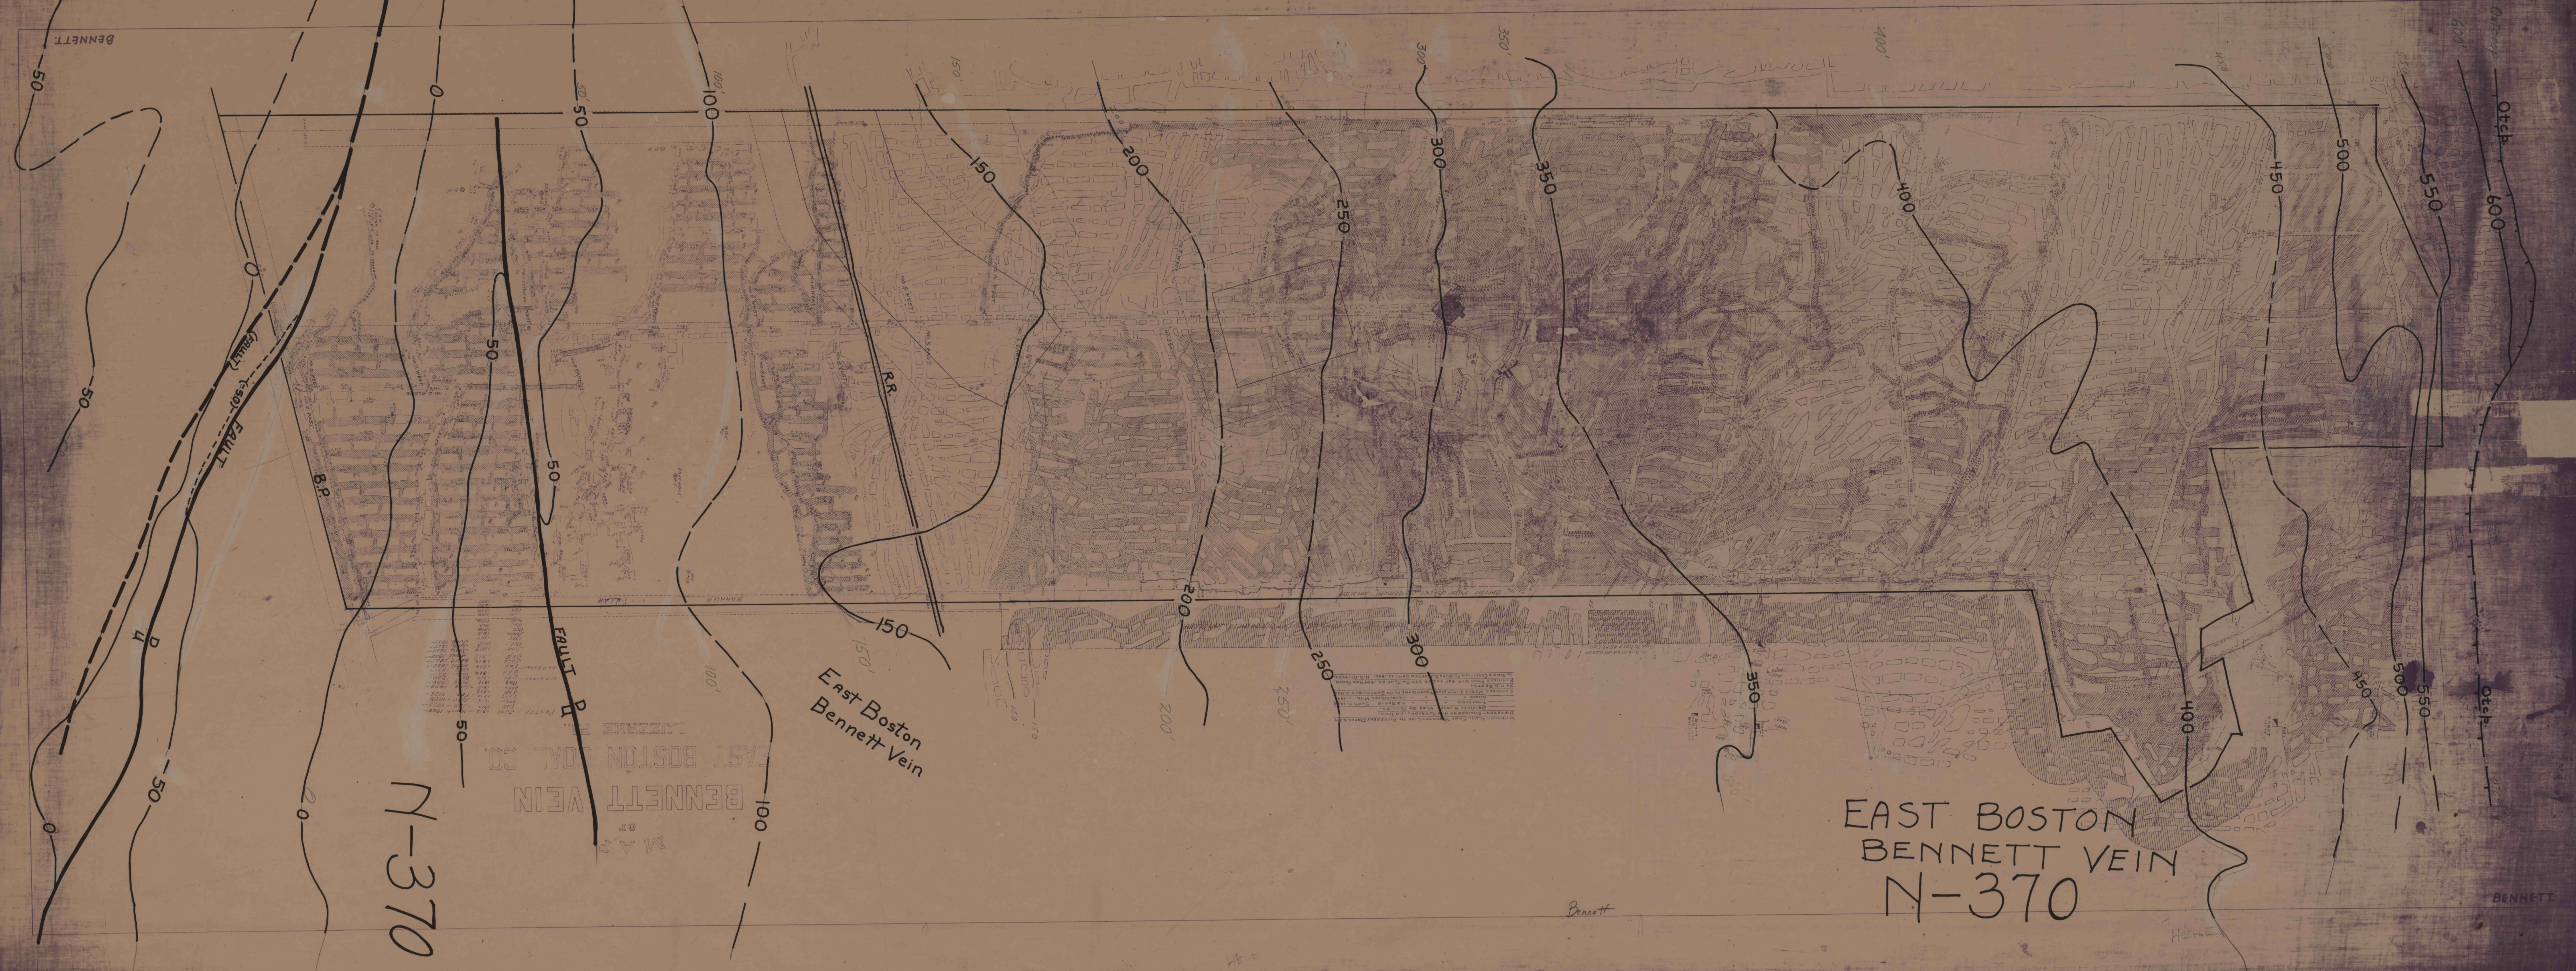

N-370

East Boston
Bennett Vein

EAST BOSTON
BENNETT VEIN
N-370