


Wyo Ave

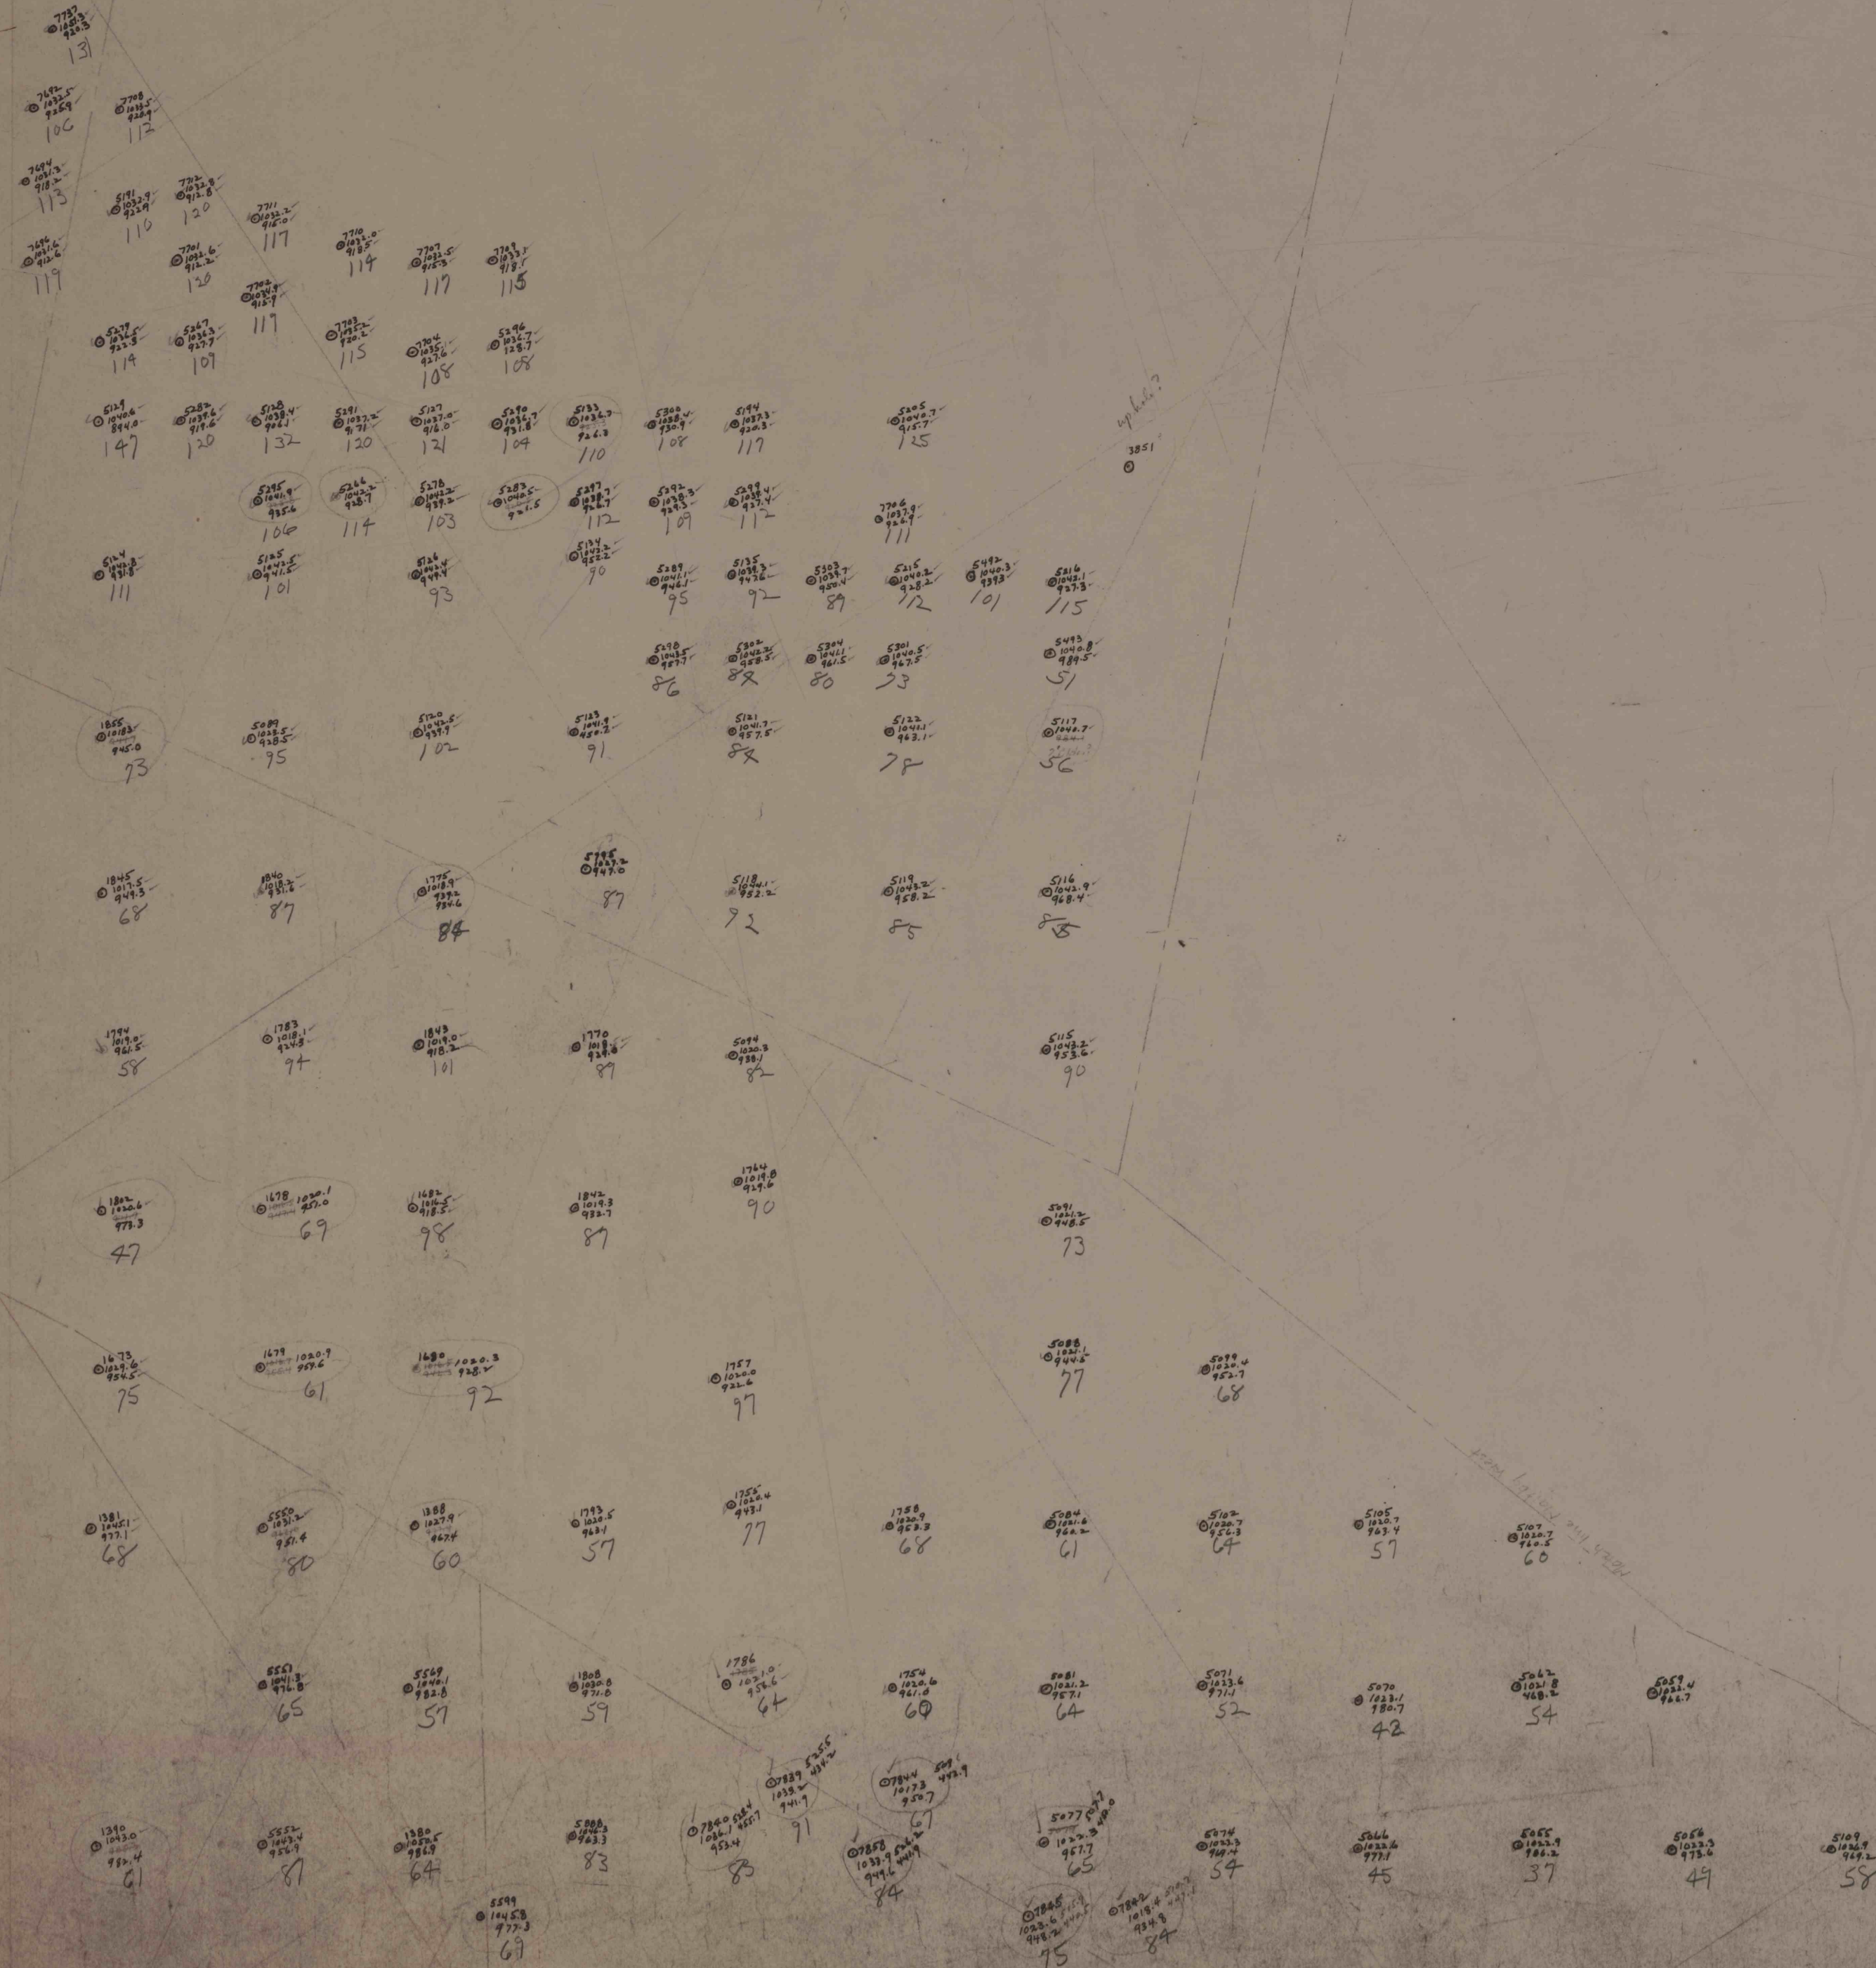

E 1000

