


BRISBAND-DIAMOND-MANVILLE
NEW COUNTY — BOTTOM SPLIT

SCALE 1" = 400'

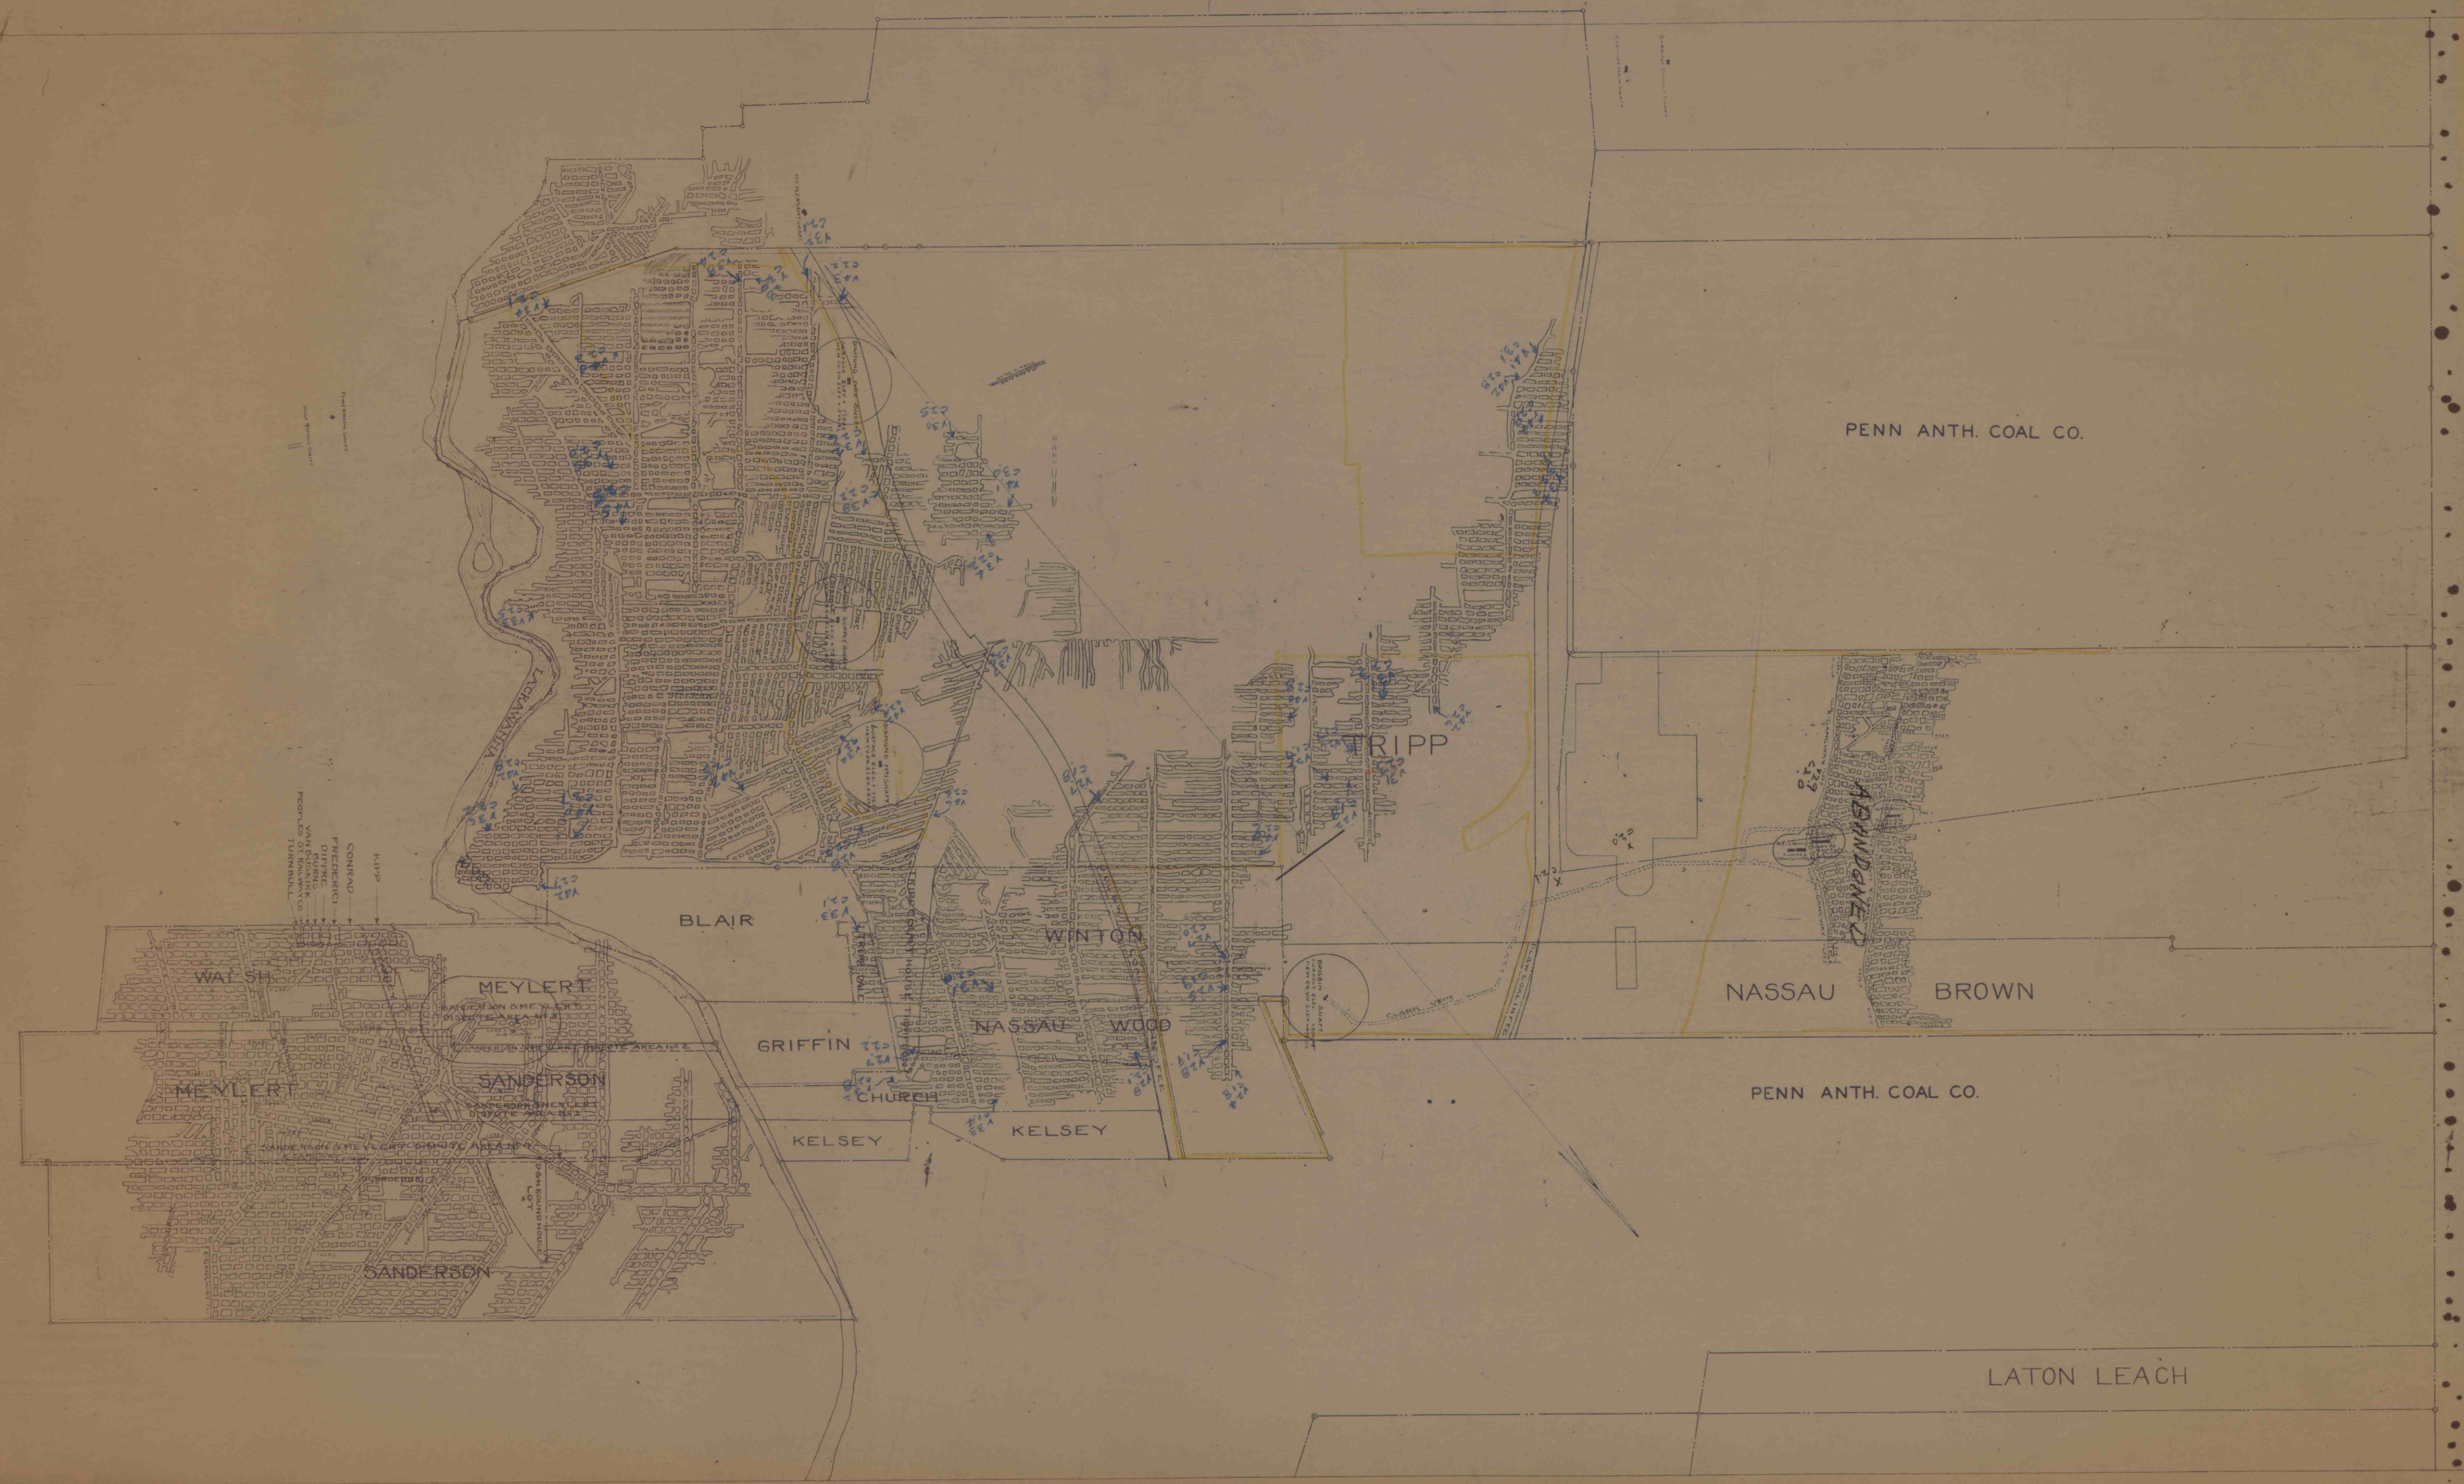

PENN ANTH. COAL CO.

NASSAU BROWN

PENN ANTH. COAL CO.

LATON LEACH