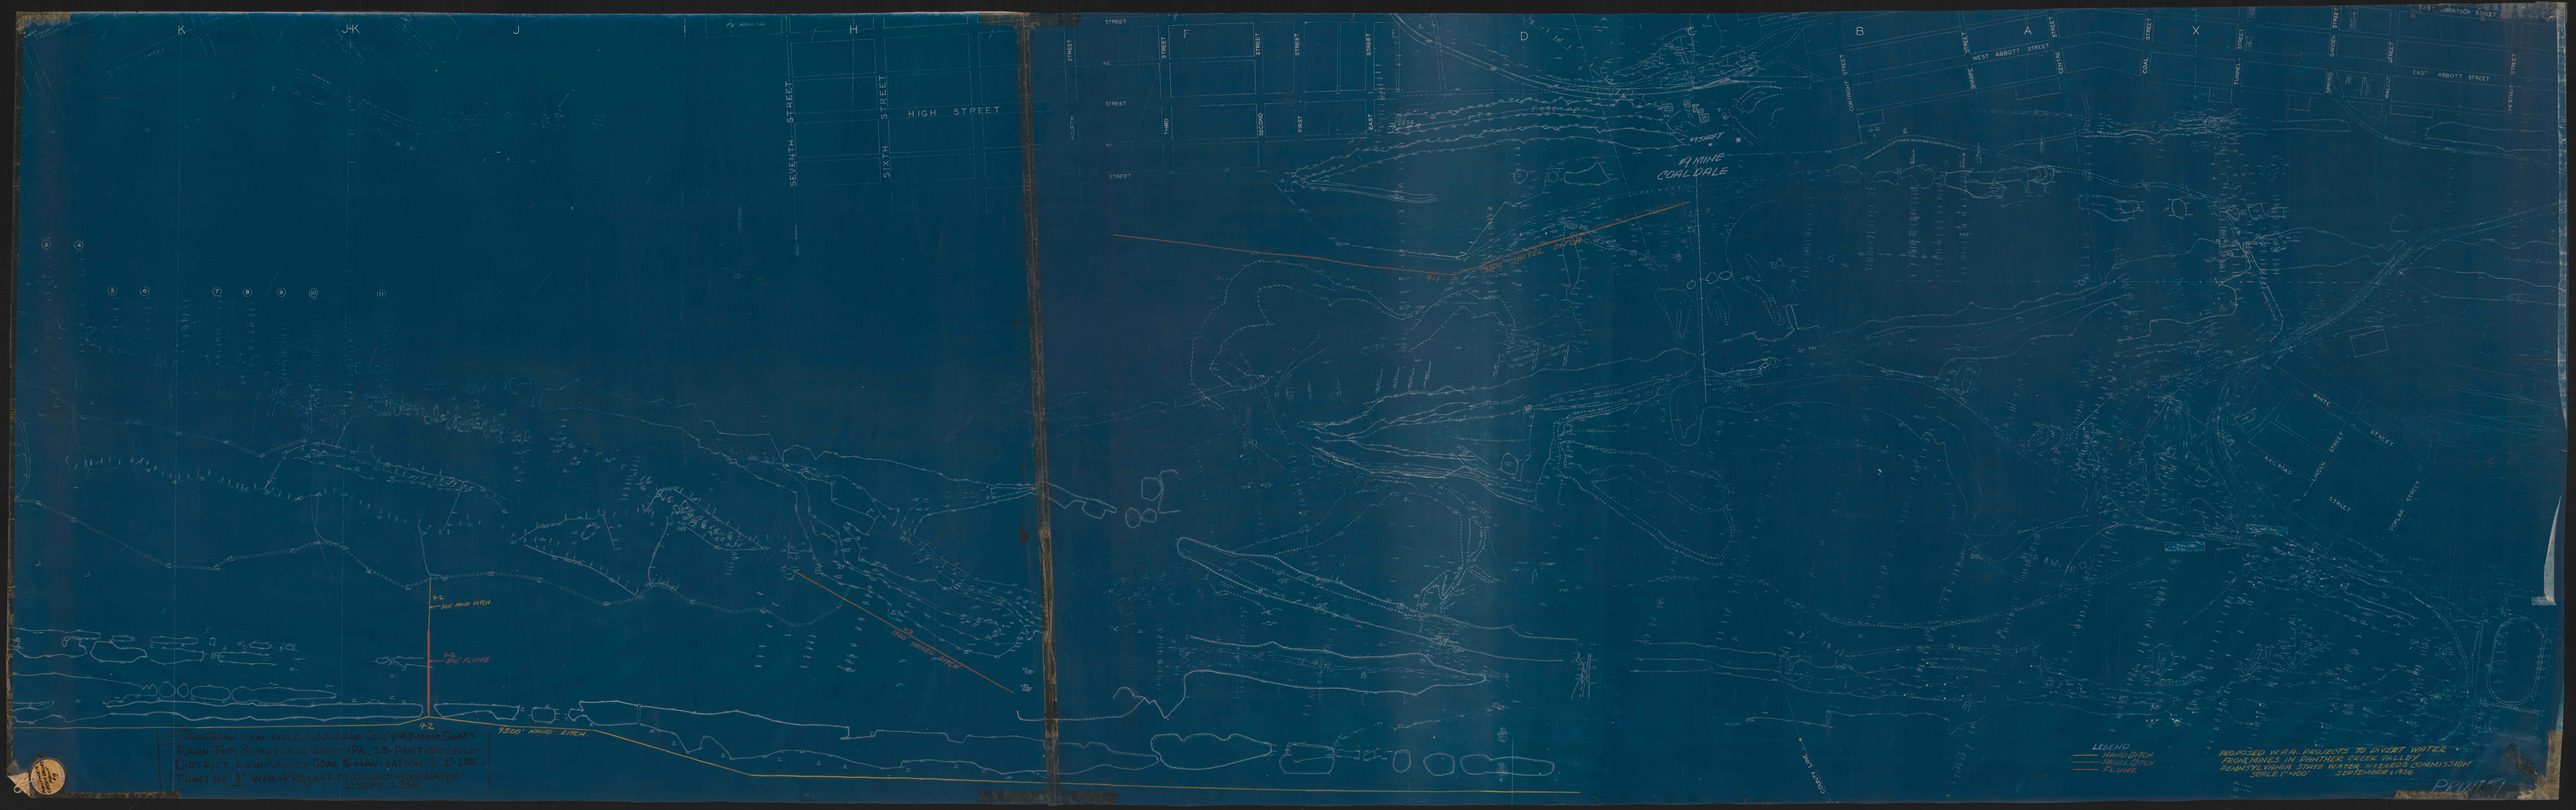

SCHUYLKILL COAL FIELD: COALDALE COLL'RY & MINE SHAFT
RAHN TWP. SCHUYLKILL COUNTY PA. S.B. PANTHER CREEK
DISTRICT. LEHIGH VALLEY COAL & NAVIGATION CO. Lt. LOC.
PRINT NO: 3 "W.P.A. PROJECT TO DIVERT MINE WATER"
1 SEPT. 1938