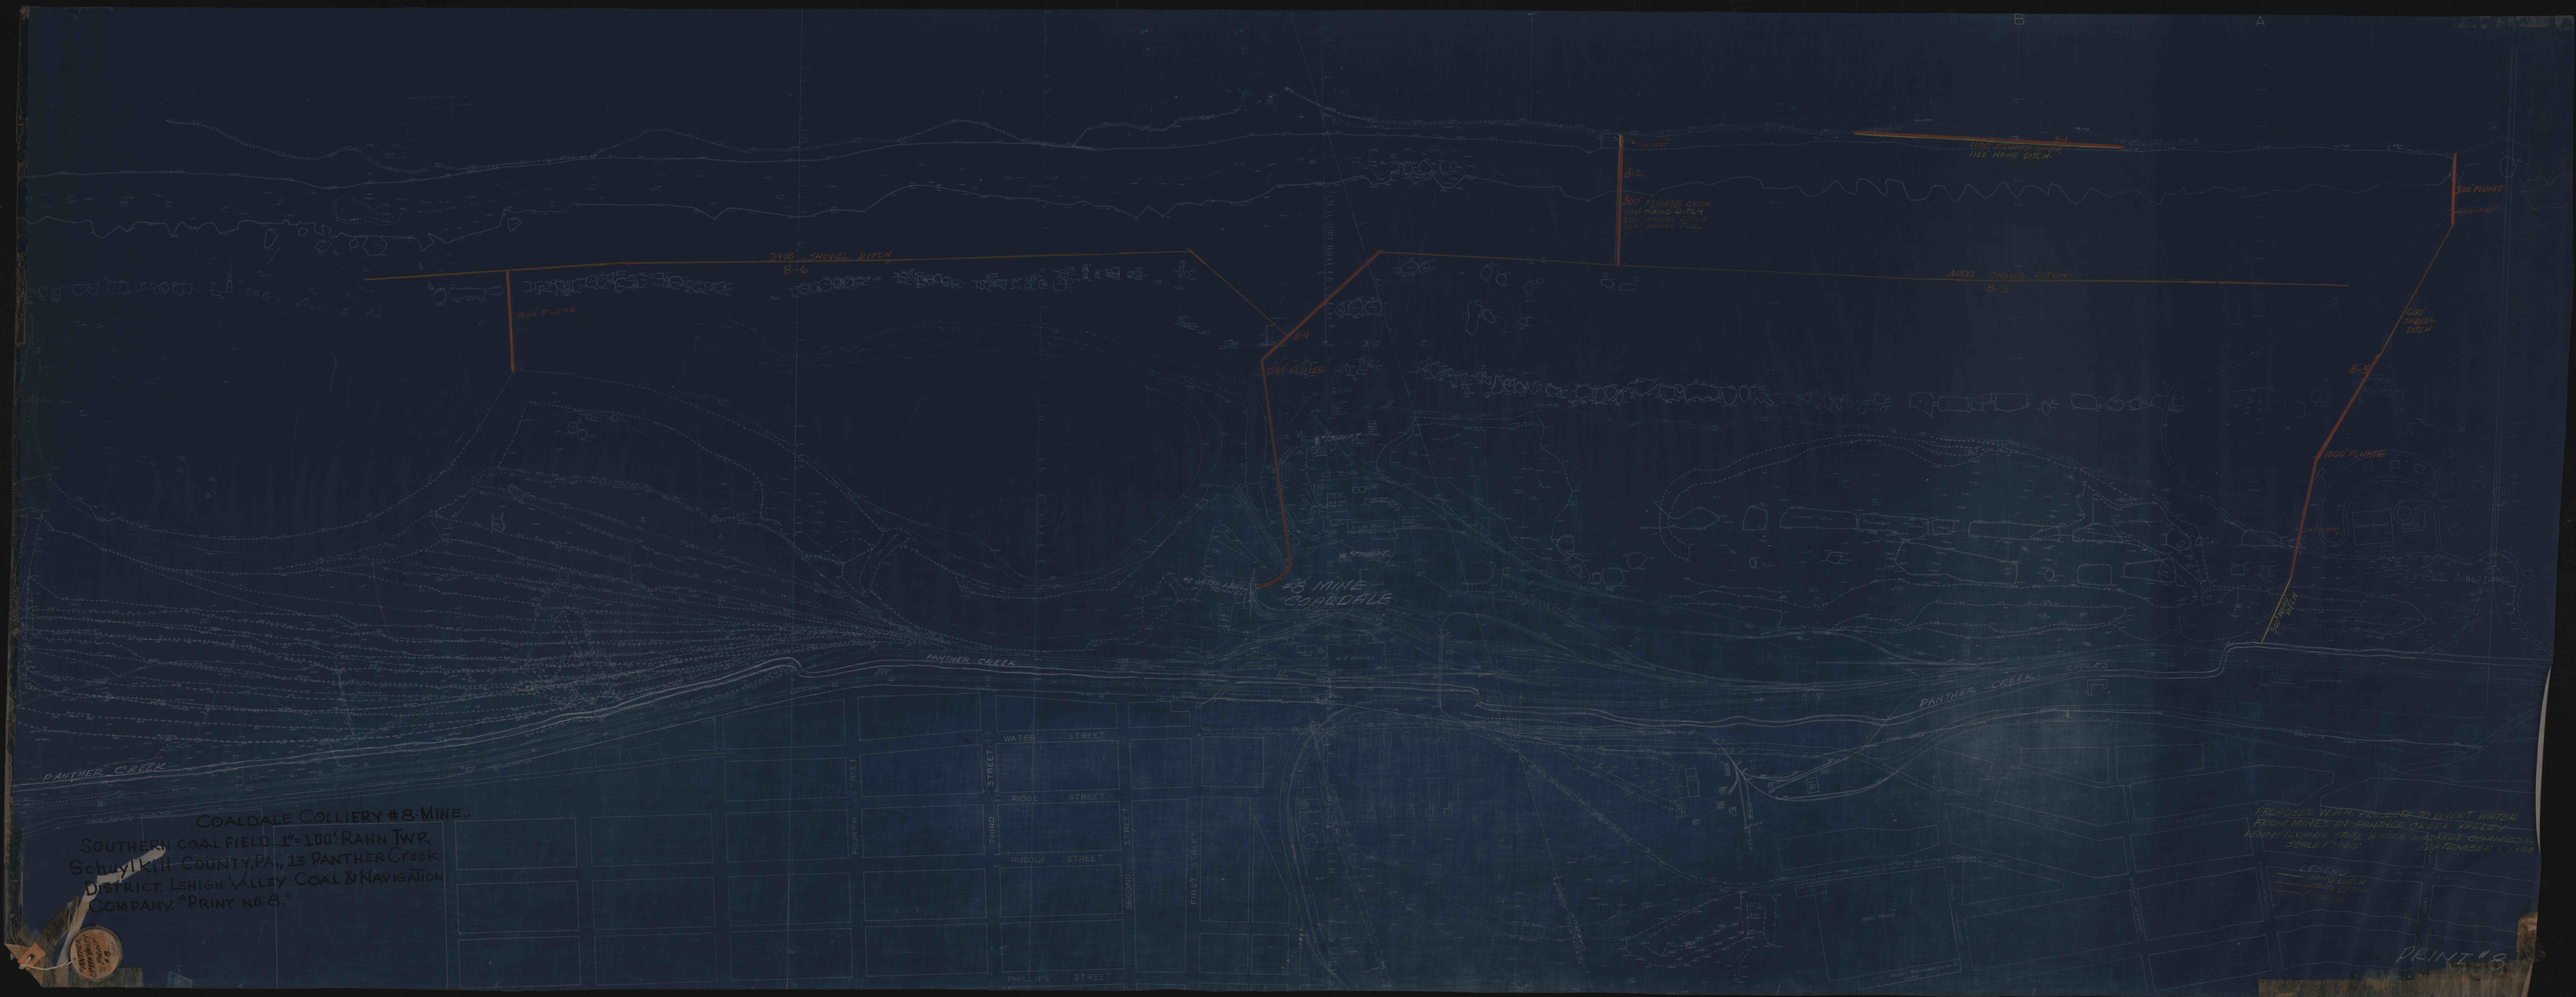
COALDALE COLLIERY #8 MINE.
SOUTHERN COAL FIELD. 1" = 100' RAHN TWP.
Schuylkill County, Pa., 13 Panther Creek
District. Lehigh Valley Coal & Navigation
Company. "Print No. 8."
3200' SHOVEL DITCH
B-6
400' FLUME
B-4
1100' FLUME
B-2
900' FLUME OVER
100' HAND DITCH
4000' SHOVEL DITCH
B-3
1100' FLUME OVER
1100' HAND DITCH
500' FLUME
500' SHOVEL DITCH
B-5
1000' FLUME
#8 MINE
COALDALE
PANTHER CREEK
WATER STREET
RIDGE STREET
RUDDLE STREET
PHILLIPS STREET
THIRD STREET
SECOND STREET
FIRST STREET
FOURTH STREET
PRINT #8