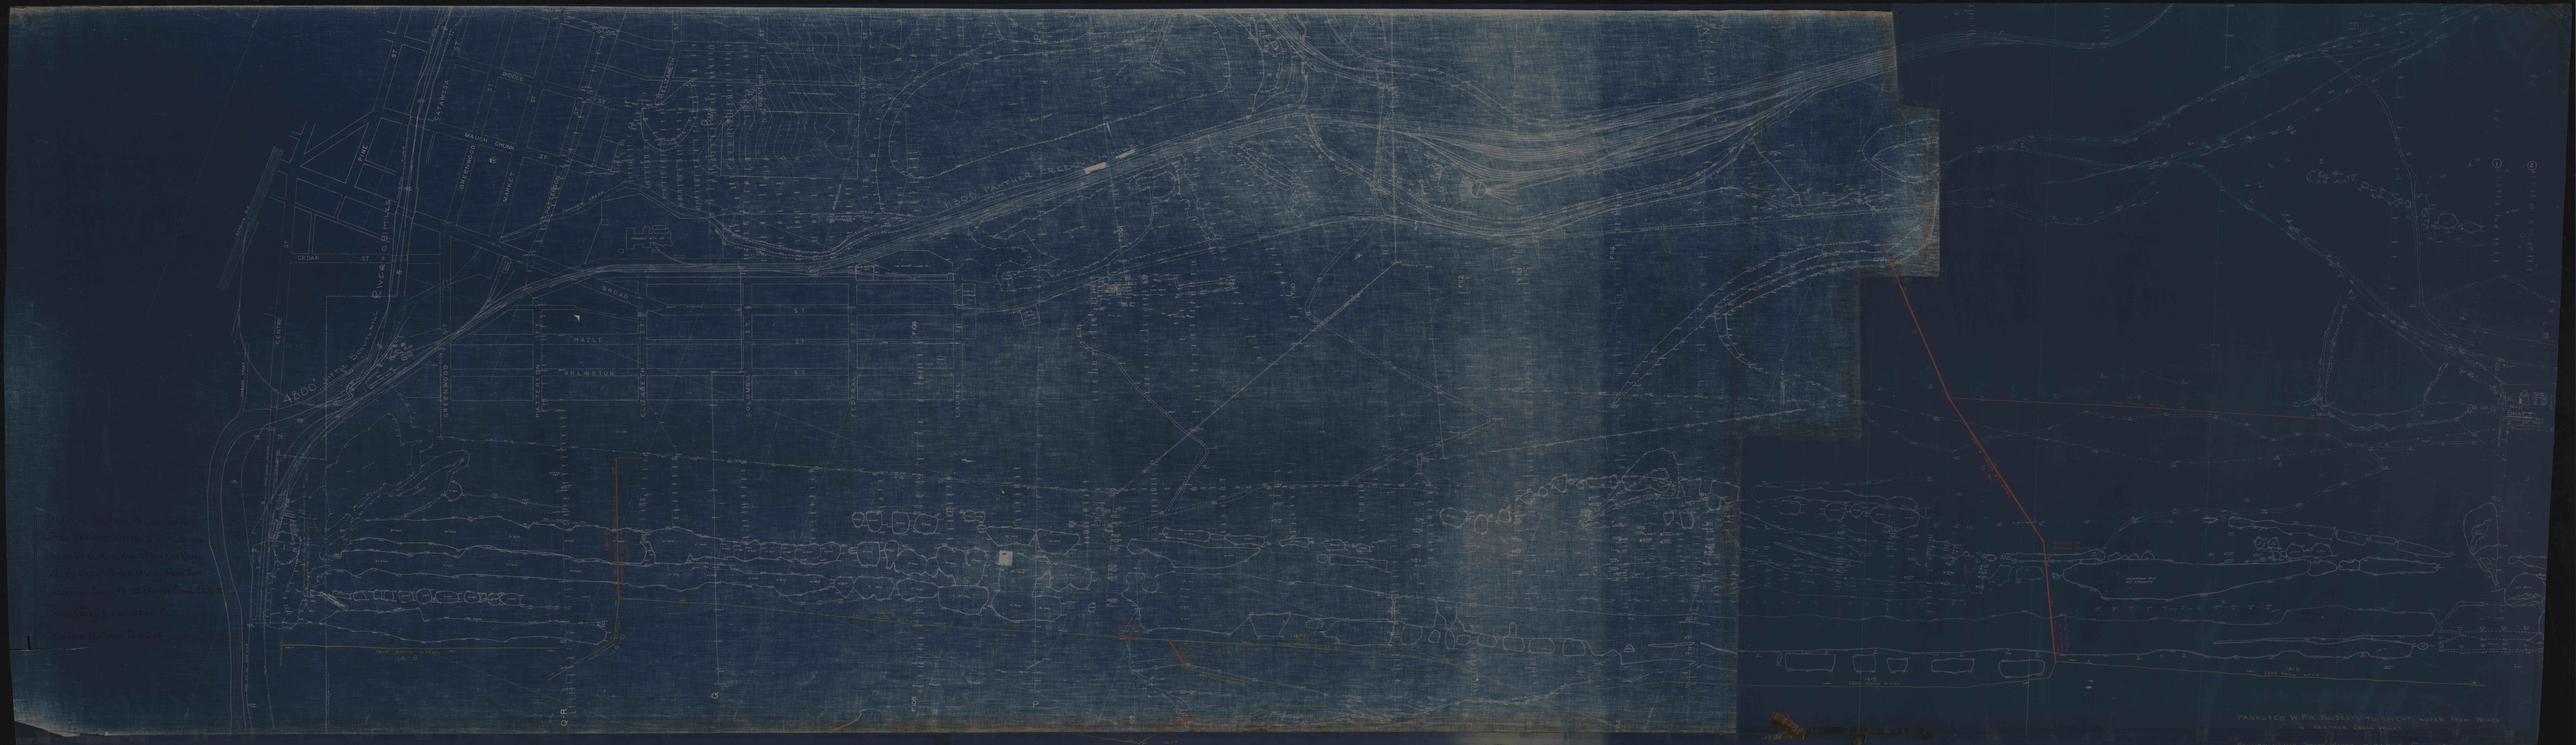
in Panther Creek Basin
Pennsylvania State Water Hazards Commission
Scale 1"=100'
September 1, 1936
LEGEND
Hand Ditch
Shovel Ditch
Flume
Print # 14 South
Panther Creek
Hazle
Arlington
Cedar
Broad
Mauch Chunk
Greenwood
Market
Pine
Cline
Laurel
Hazleton
Pennsylvania
Railroad
Lehigh Valley
Hazleton Branch
Hazle Branch
Panther Creek Branch
Hazle Creek
Lehigh River
Lehigh Canal
