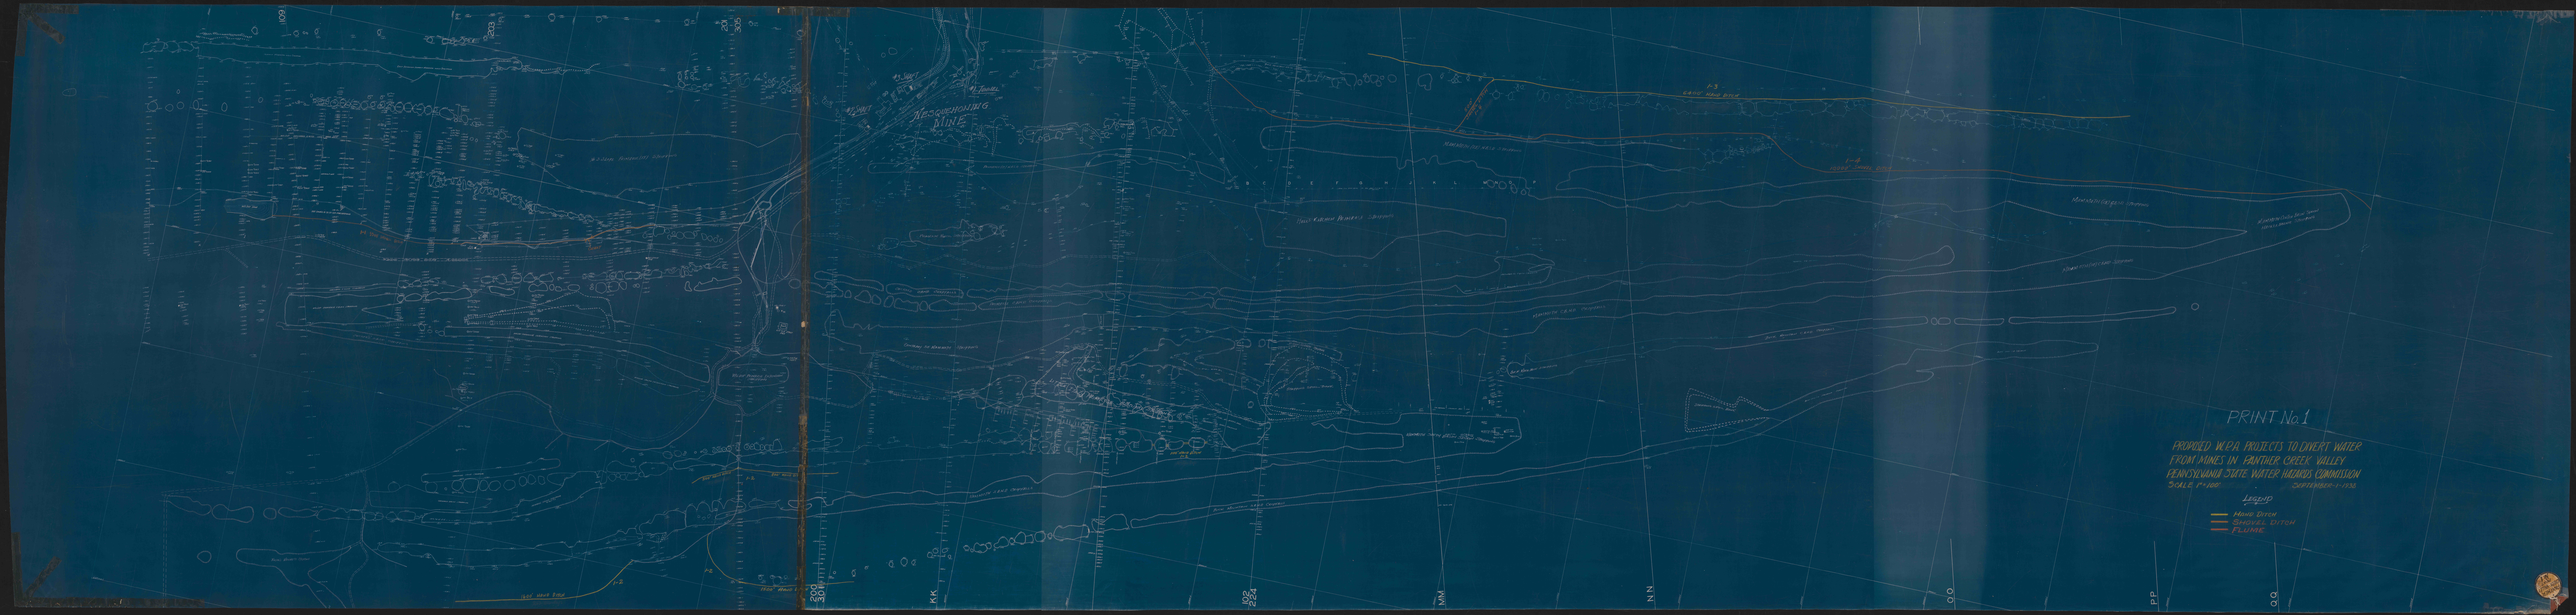
PRINT No. 1
PROPOSED W.R.A. PROJECTS TO DIVERT WATER
PENNSYLVANIA STATE WATER HAZARDS COMMISSION
SCALE 1" = 100'
SEPTEMBER 1, 1936
LEGEND
SHOVEL DITCH
FLUME
KK
NN
OO
PP
QQ