


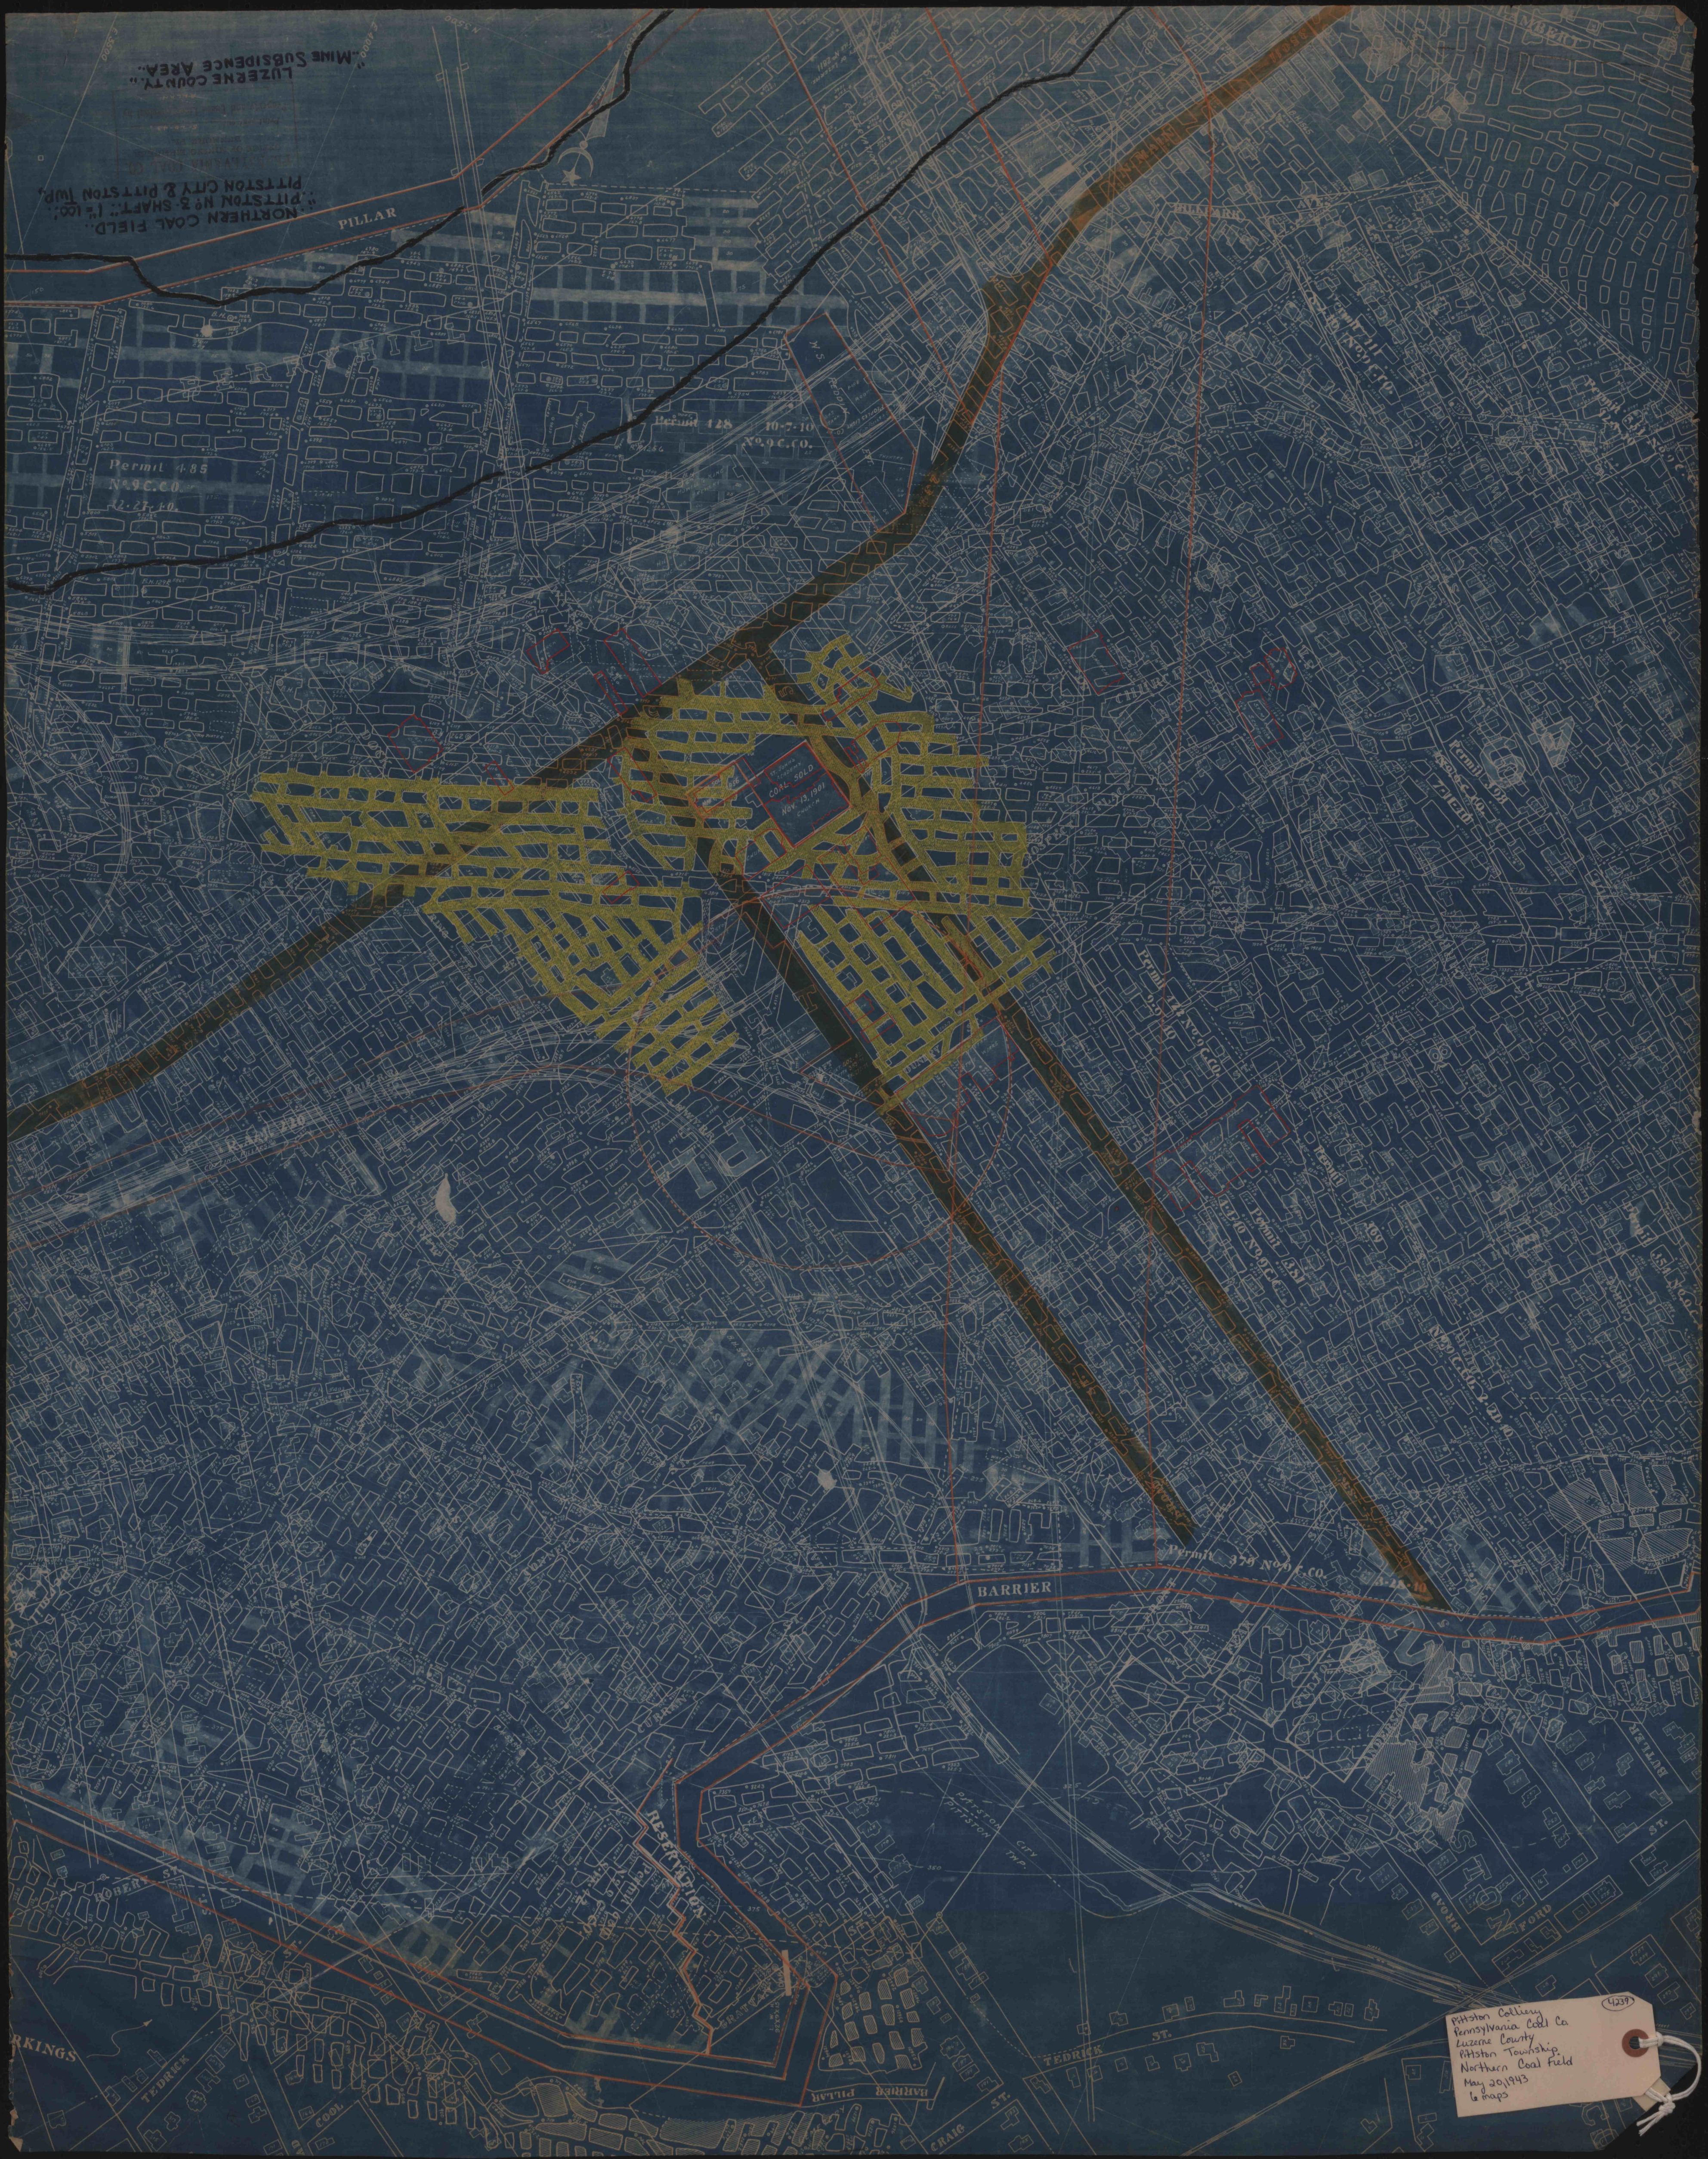

Pittston Colliery
Pennsylvania Coal Co.
Luzerne County
Pittston Township
Northern Coal Field
May 20, 1943
6 maps